

28

28


943 M
40 Ac
J. SMITH
M L

1898
J. Smith
M L

275-02

275-02

SCALE 30 FT TO AN INCH

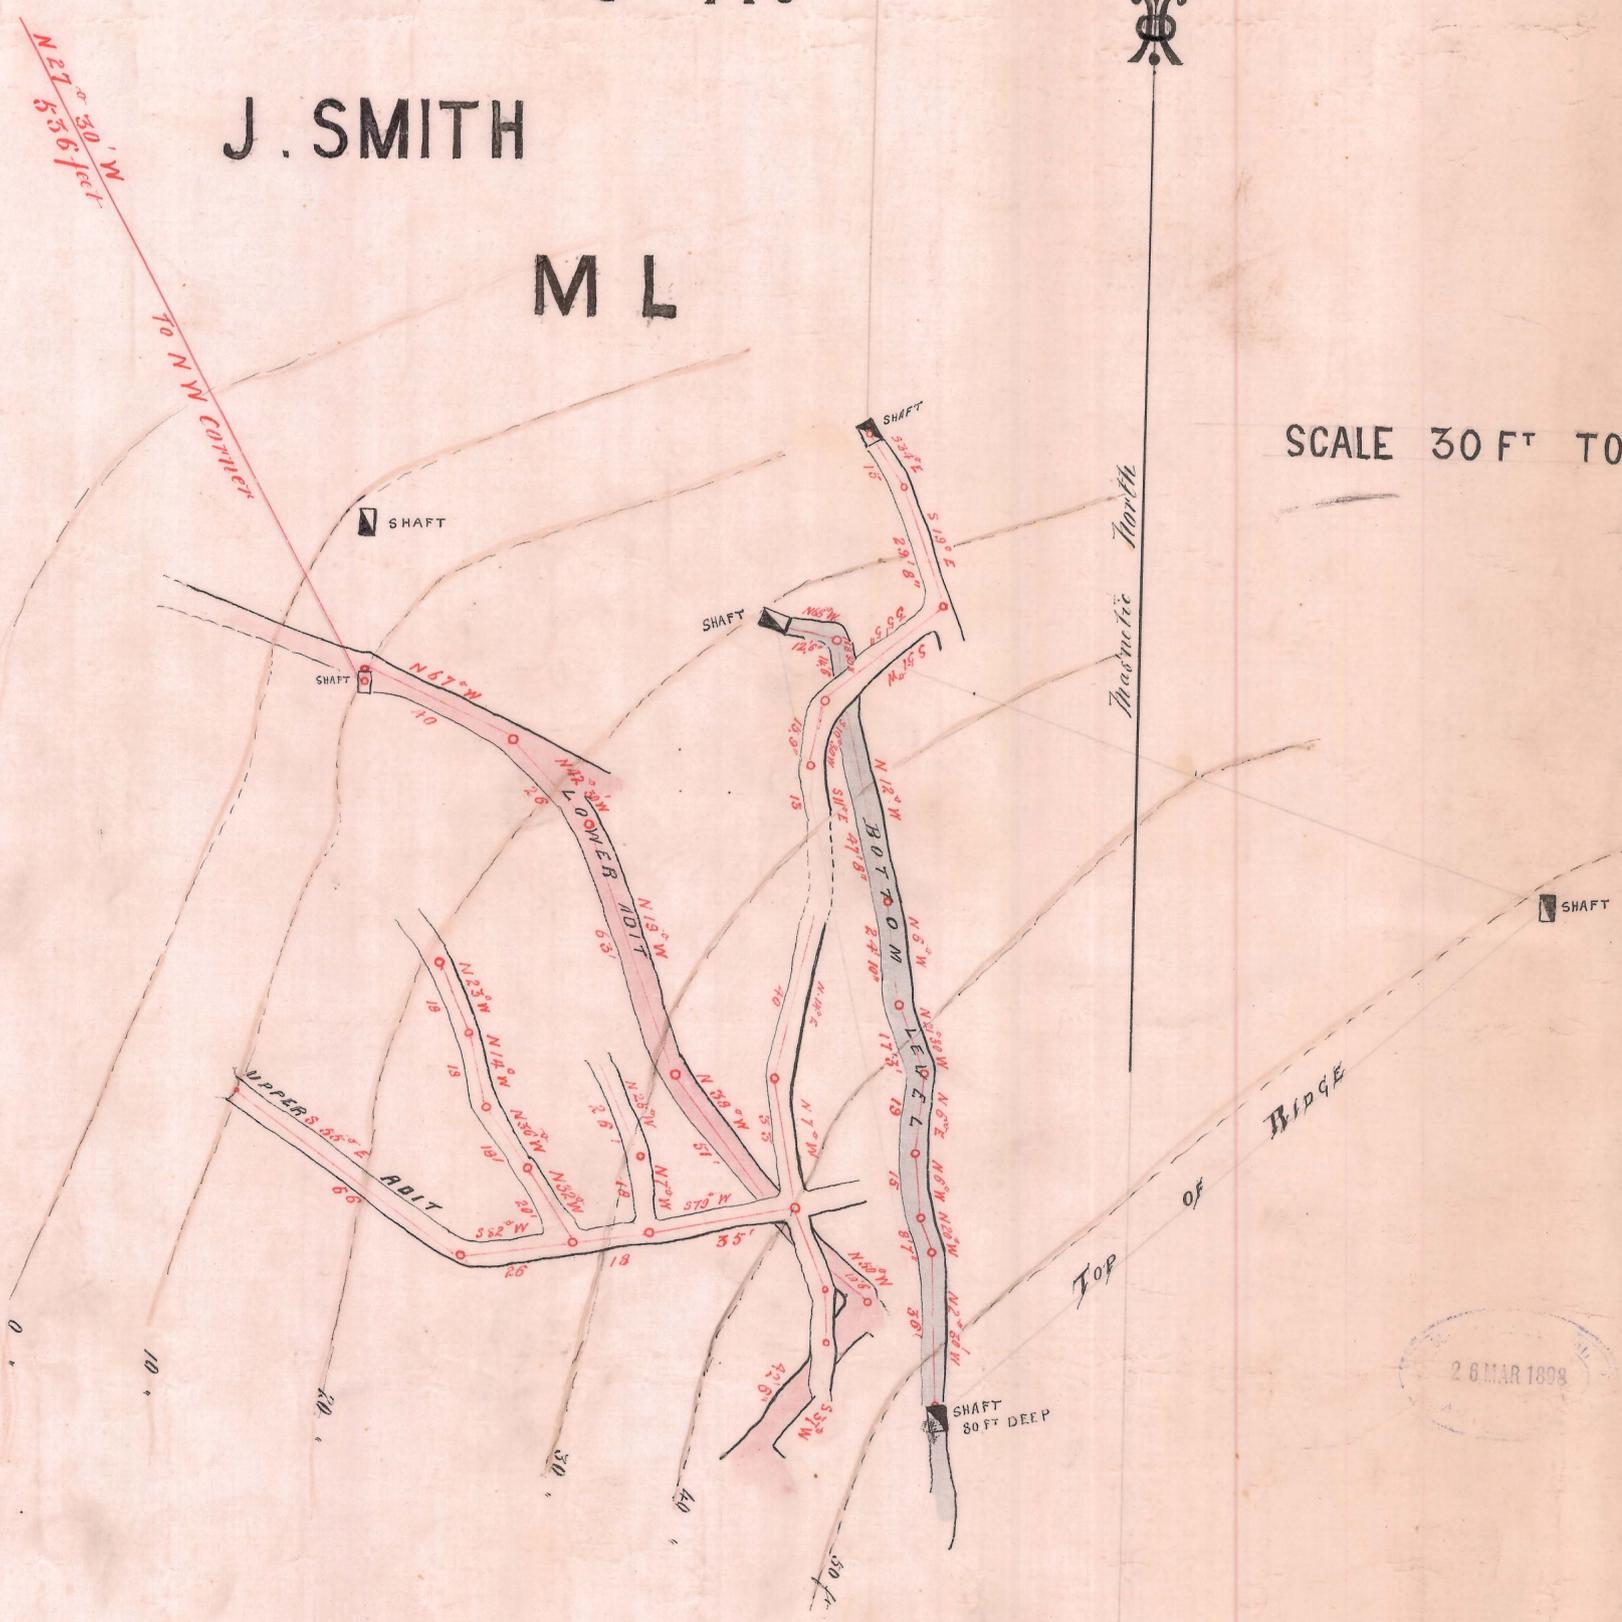

26 MAR 1898

80