

275-06


275-06

5 cm

88

88

To N.W. Corner

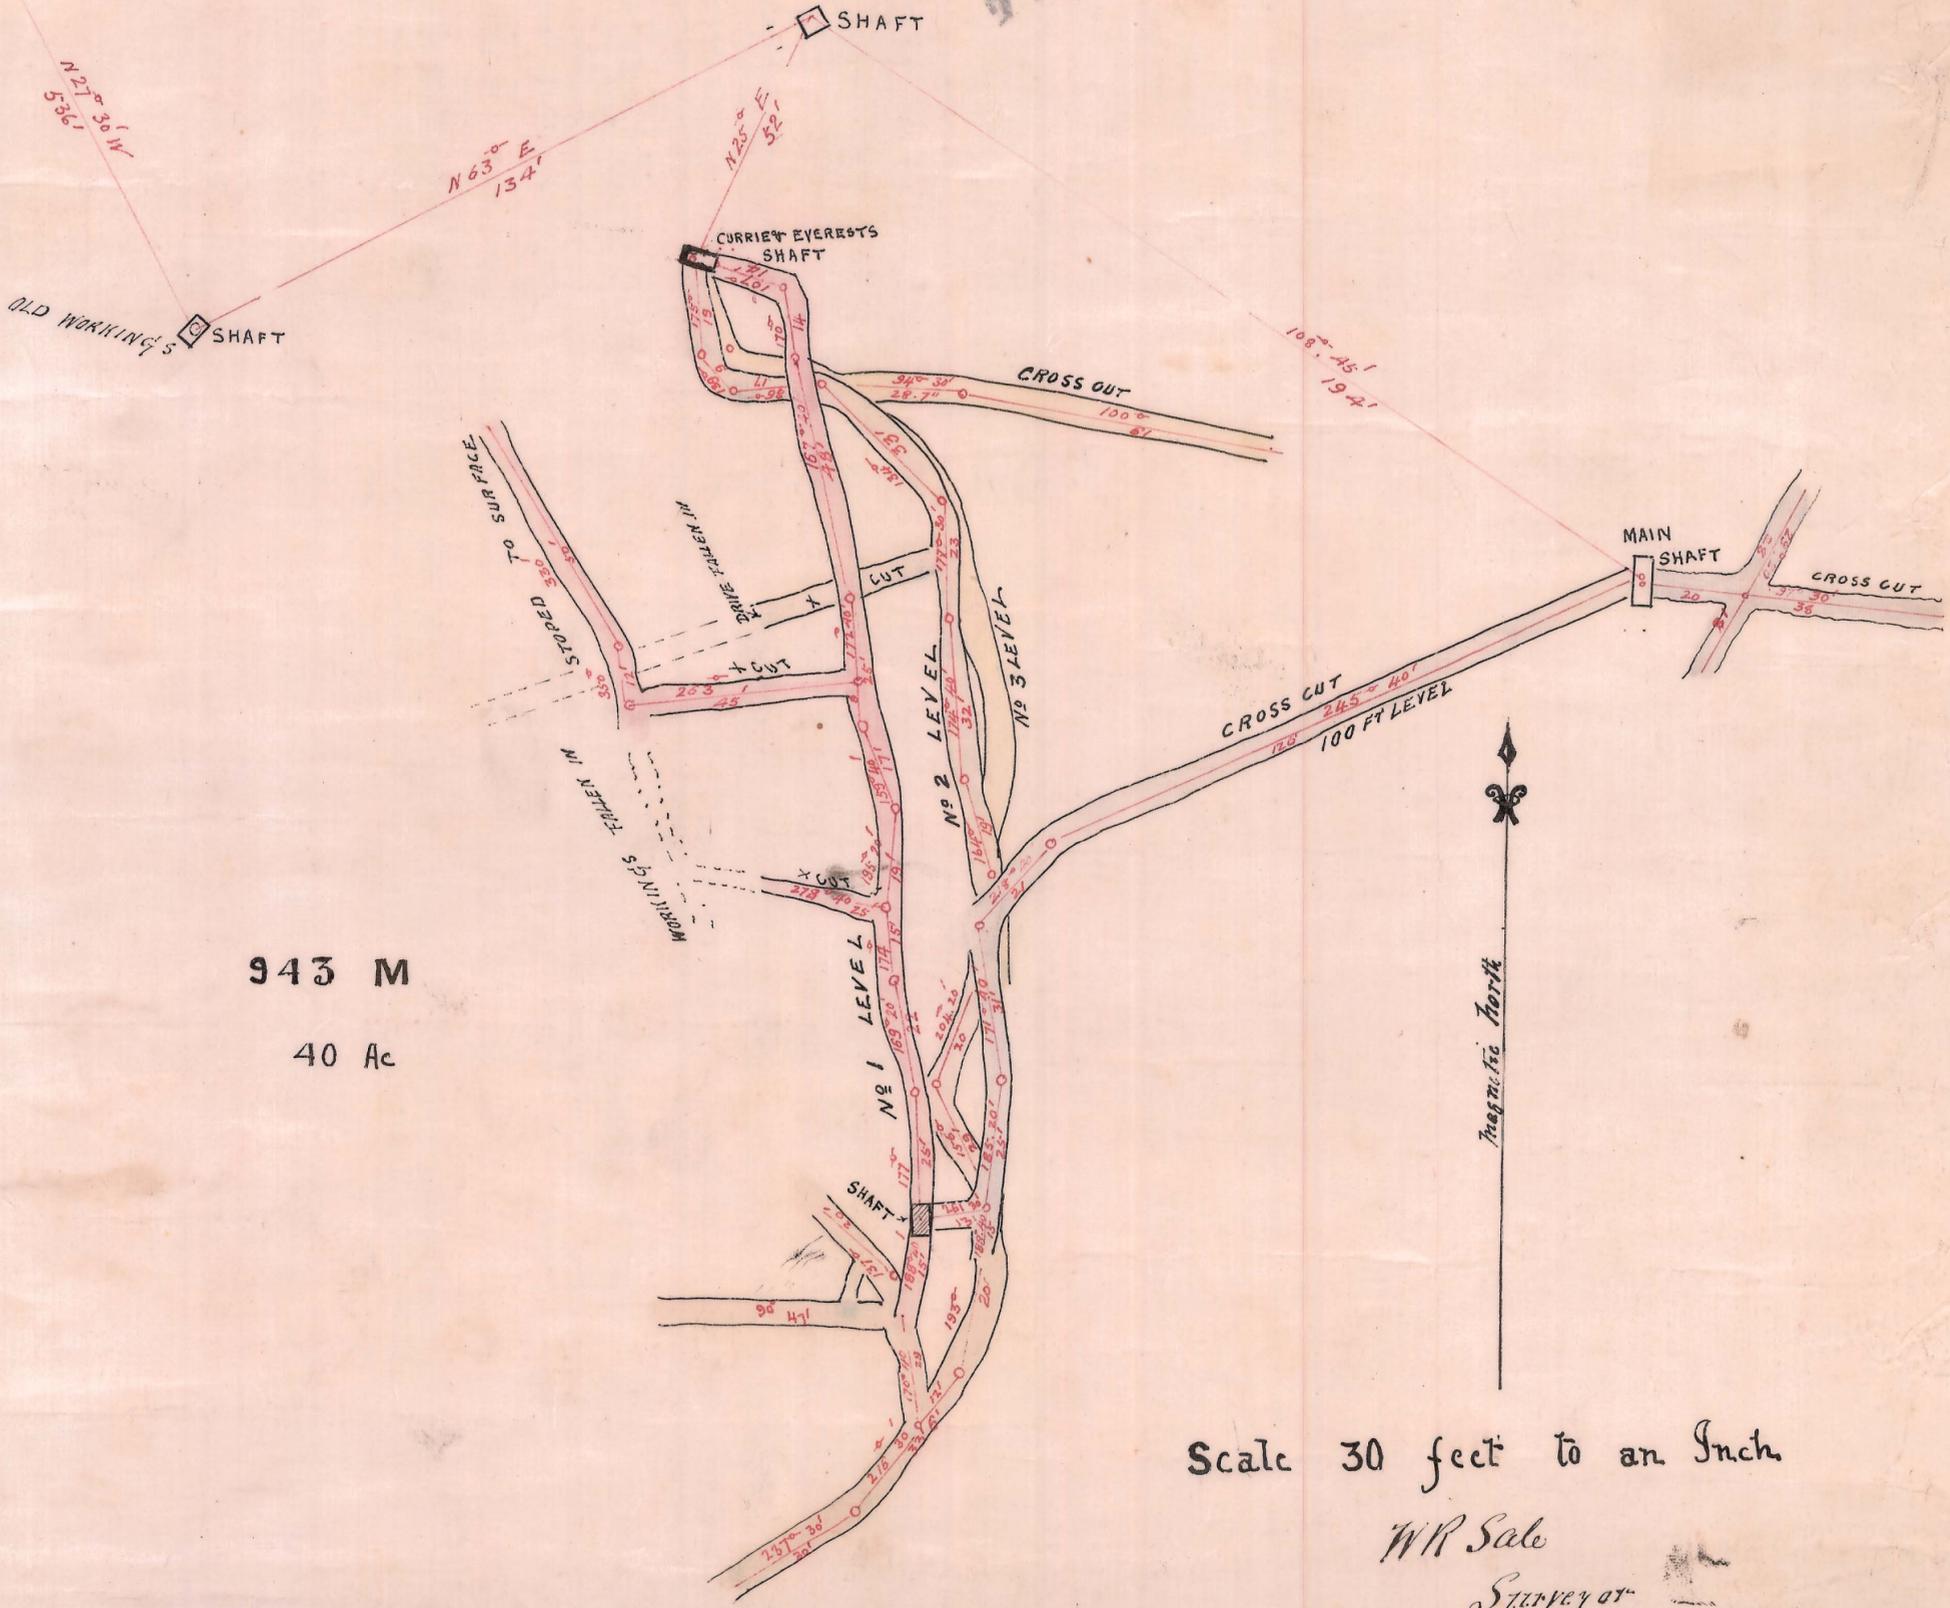

943 M
40 Ac

Scale 30 feet to an Inch
W.R. Sale
Surveyor

88

88