

5 cm



276-01

$\frac{80}{7.3}$



# Plan. Portland. S.M.C.

— Cross Section —

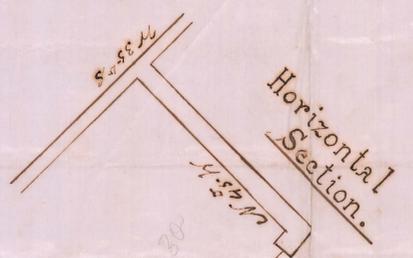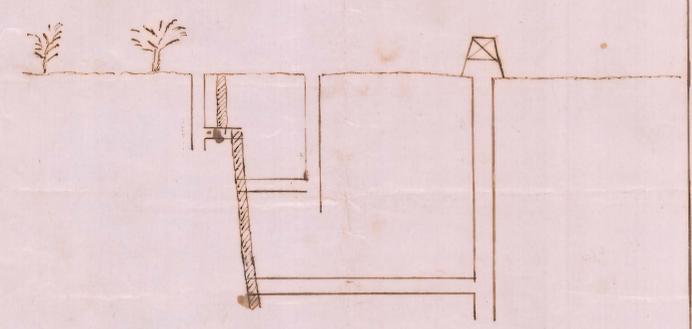

*Connecting line from S.W. corner peg of Case's distance 250 from intersection*

REFERENCES. --- Scale 20 ft. to one inch  
Survey made with Prismatic  
Compass

Corrected George Young, M. G. Young  
Jan 20<sup>th</sup> 1897