

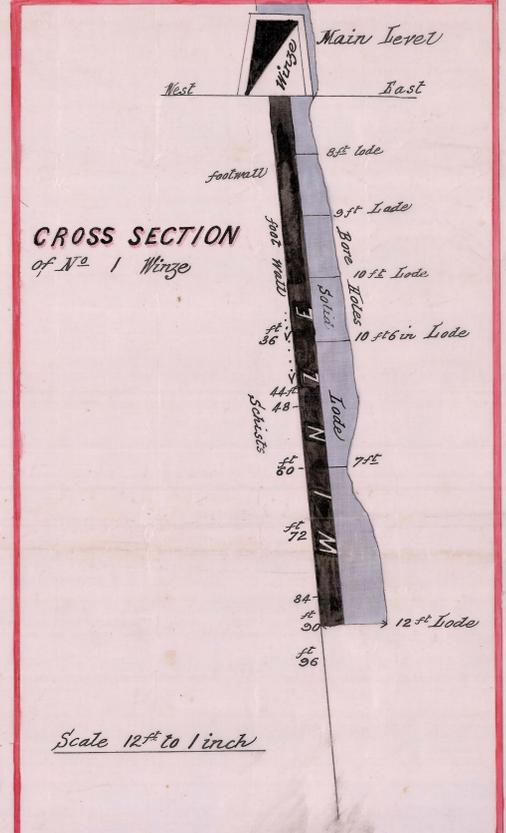


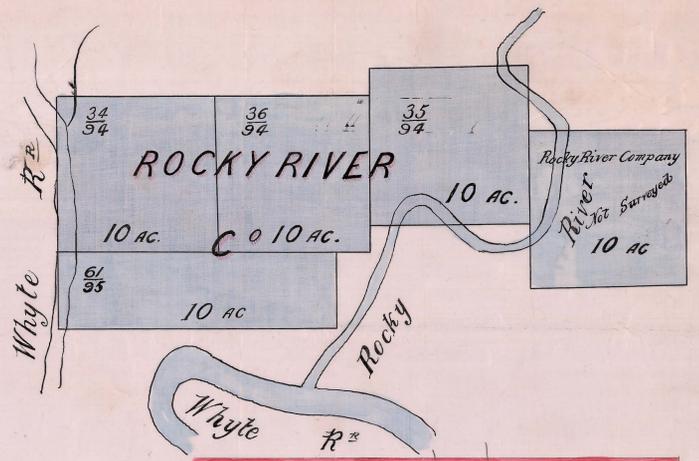


277-03


PLAN OF THE ROCKY RIVER C^o MINE TASMANIA

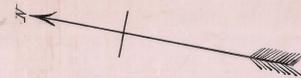

PLAN OF WORKINGS UNDERGROUND

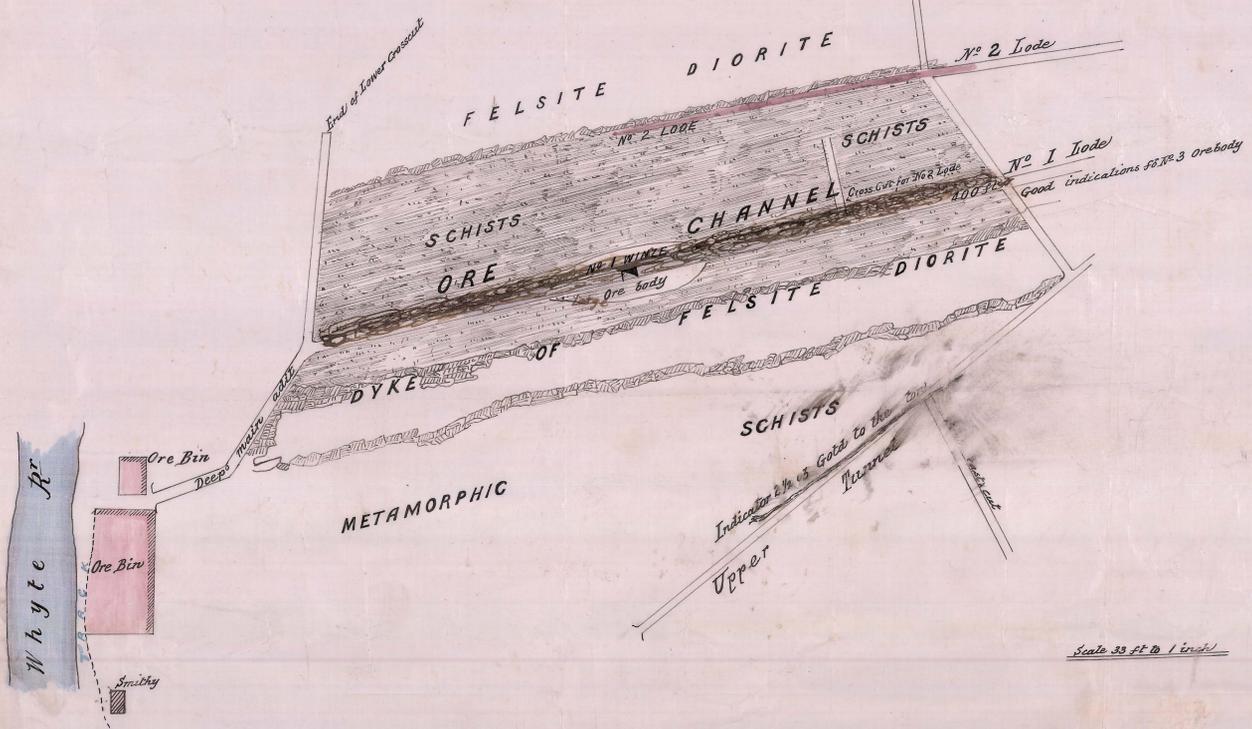

LONGITUDINAL SECTION

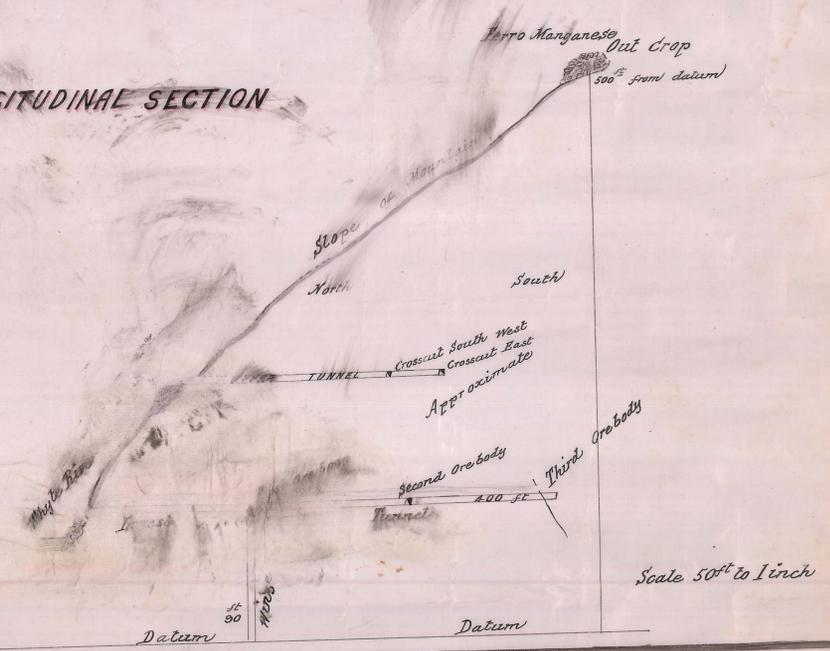

W. H. Manton M.E.
 Certified Comptroller
 No. 16 Lane,
 Mining Manager
 Date 28/1/1898