


5 cm

277-04

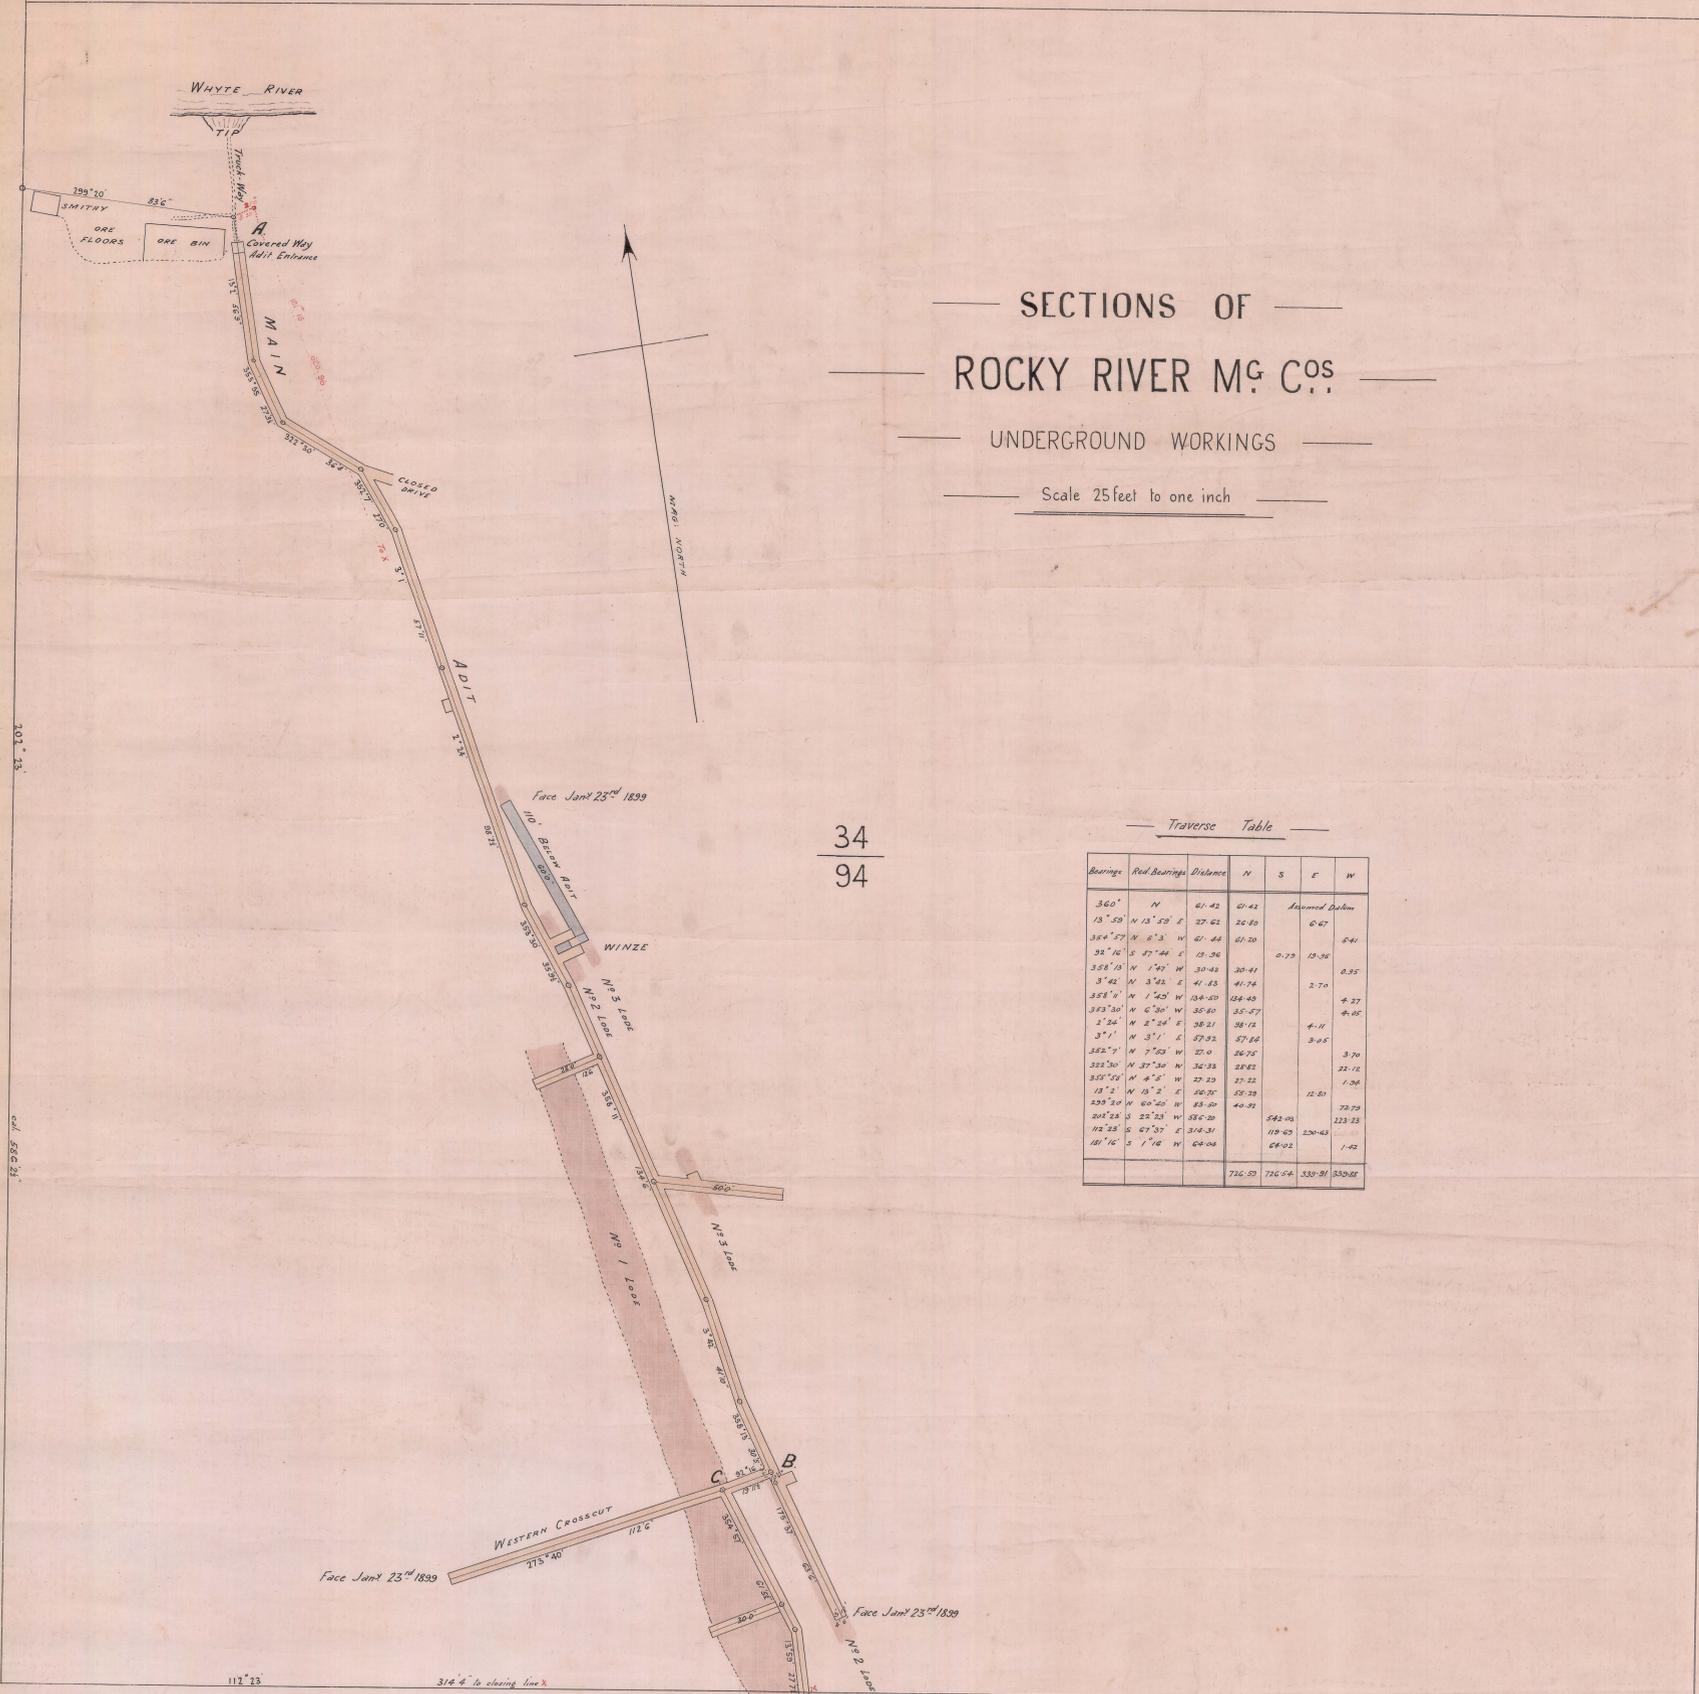

SECTIONS OF  
ROCKY RIVER M<sup>C</sup> CO'S

UNDERGROUND WORKINGS


Scale 25 feet to one inch

34  
94


Traverse Table

Bearings	Real Bearings	Distances	N	S	E	W
3.60'	N	61.42	61.42			Assumed Datum
18° 59'	N 13° 59' E	27.62	26.80		6.67	
354° 57'	N 6° 3' W	61.44	61.20		5.84	
92° 16'	S 47° 46' E	13.24		0.79	12.35	
358° 15'	N 1° 42' W	30.43	30.41		0.85	
3° 42'	N 3° 42' E	41.83	41.74		2.70	
358° 16'	N 1° 42' W	104.40	104.40		4.27	
343° 30'	N 6° 30' W	35.80	35.57		4.05	
1° 34'	N 2° 34' E	28.21	28.12		4.11	
374° 1'	N 3° 1' E	27.32	27.26		3.45	
322° 9'	N 7° 23' W	22.0	22.0		3.70	
322° 30'	N 7° 30' W	34.33	34.22		2.12	
315° 23'	N 4° 56' W	27.23	27.22		1.56	
18° 2'	N 18° 2' E	50.20	50.20		12.80	
209° 50'	N 10° 50' W	88.00	88.00		23.23	
304° 23'	S 22° 23' W	35.00		24.40		
112° 23'	S 47° 37' E	314.31		112.67	230.43	
181° 16'	S 1° 16' N	64.04		64.02	1.42	
			716.59	726.54	339.81	830.82

Section along line A.B.C.D.  
looking east  
Scale 80 ft to 1 inch

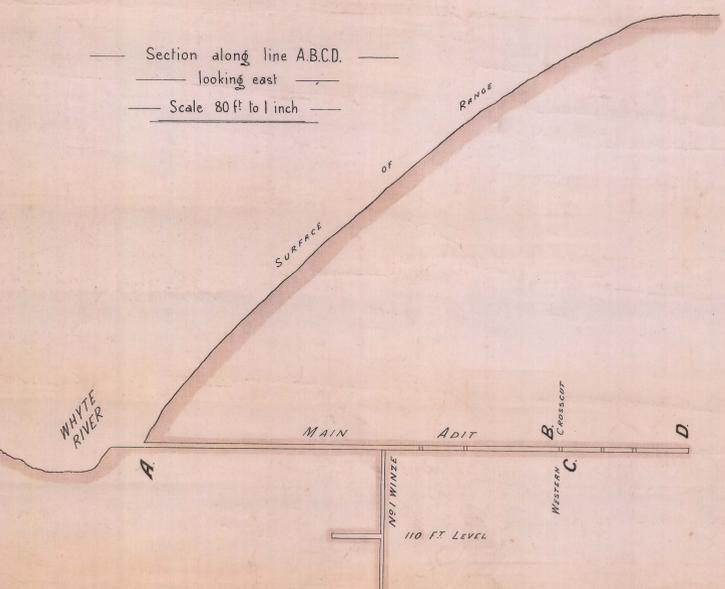

36  
94

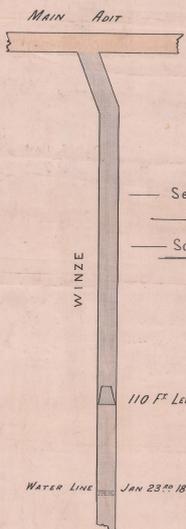

Section of Winze  
looking north  
Scale 20 ft to 1 inch

I Certify that this is a correct  
plan of work done to date.  
*Michael Blaney*  
Mine Manager  
Jan 23<sup>rd</sup> 1899