
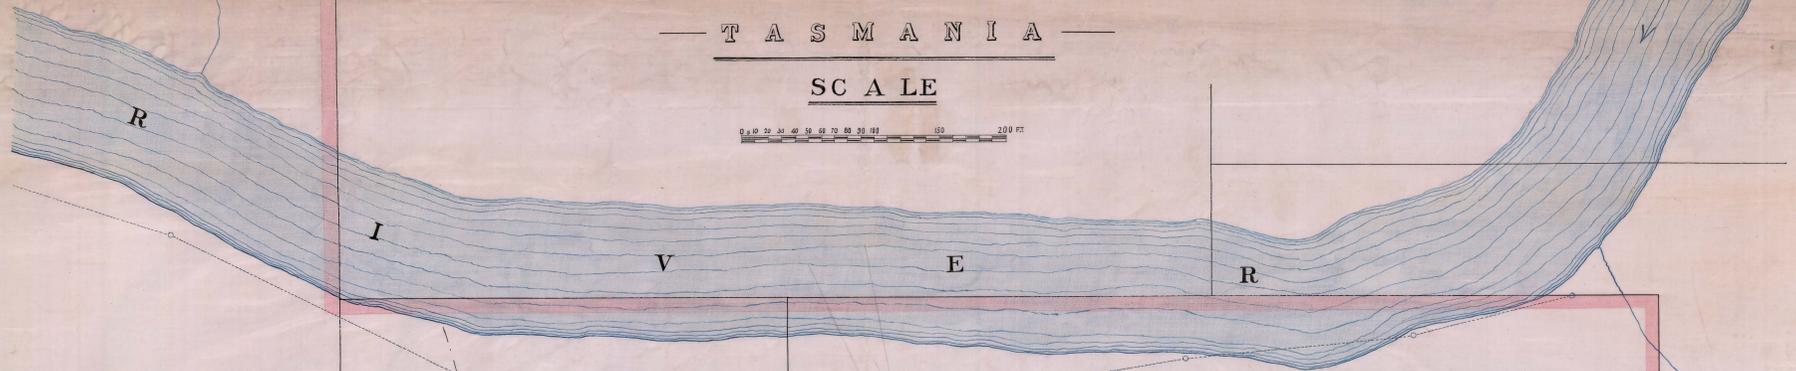 


ROCKY RIVER MINING CO. N. L.

TASMANIA

SCALE



3242 M
93


80

34
94

10

CL

36
94

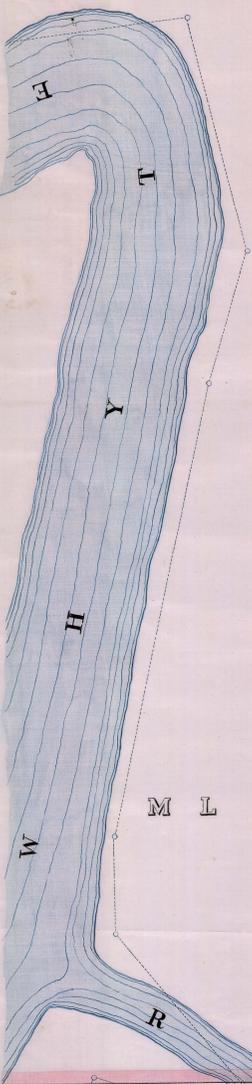

61
94

CL


10

CL

35
94

10

CL

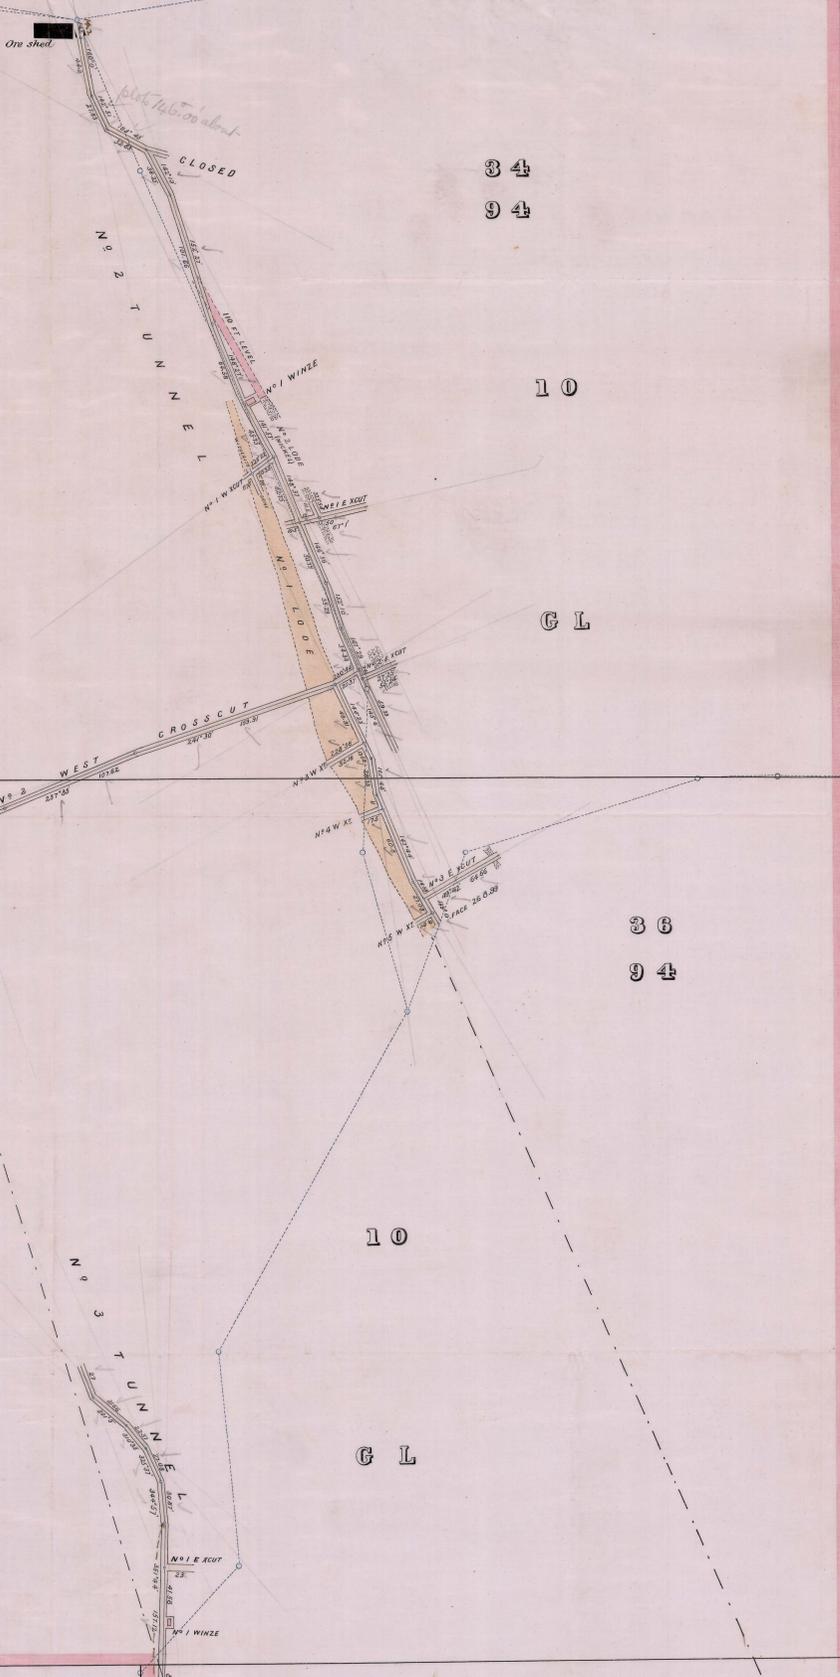

Joseph Wick B.C.E.
Sullivan's mine
20/1/99

Surveyed with a 6" Sigsbee chain theodolite
and soft steel tape.

30
IP 10-10-00
2/1/99