

ROCKY RIVER MINING CO. N. L.


TASMANIA SCALES

100 feet to 1 inch hor.
25 feet to 1 inch ver.

Handwritten note: See plan of the mine

27-06

27-06

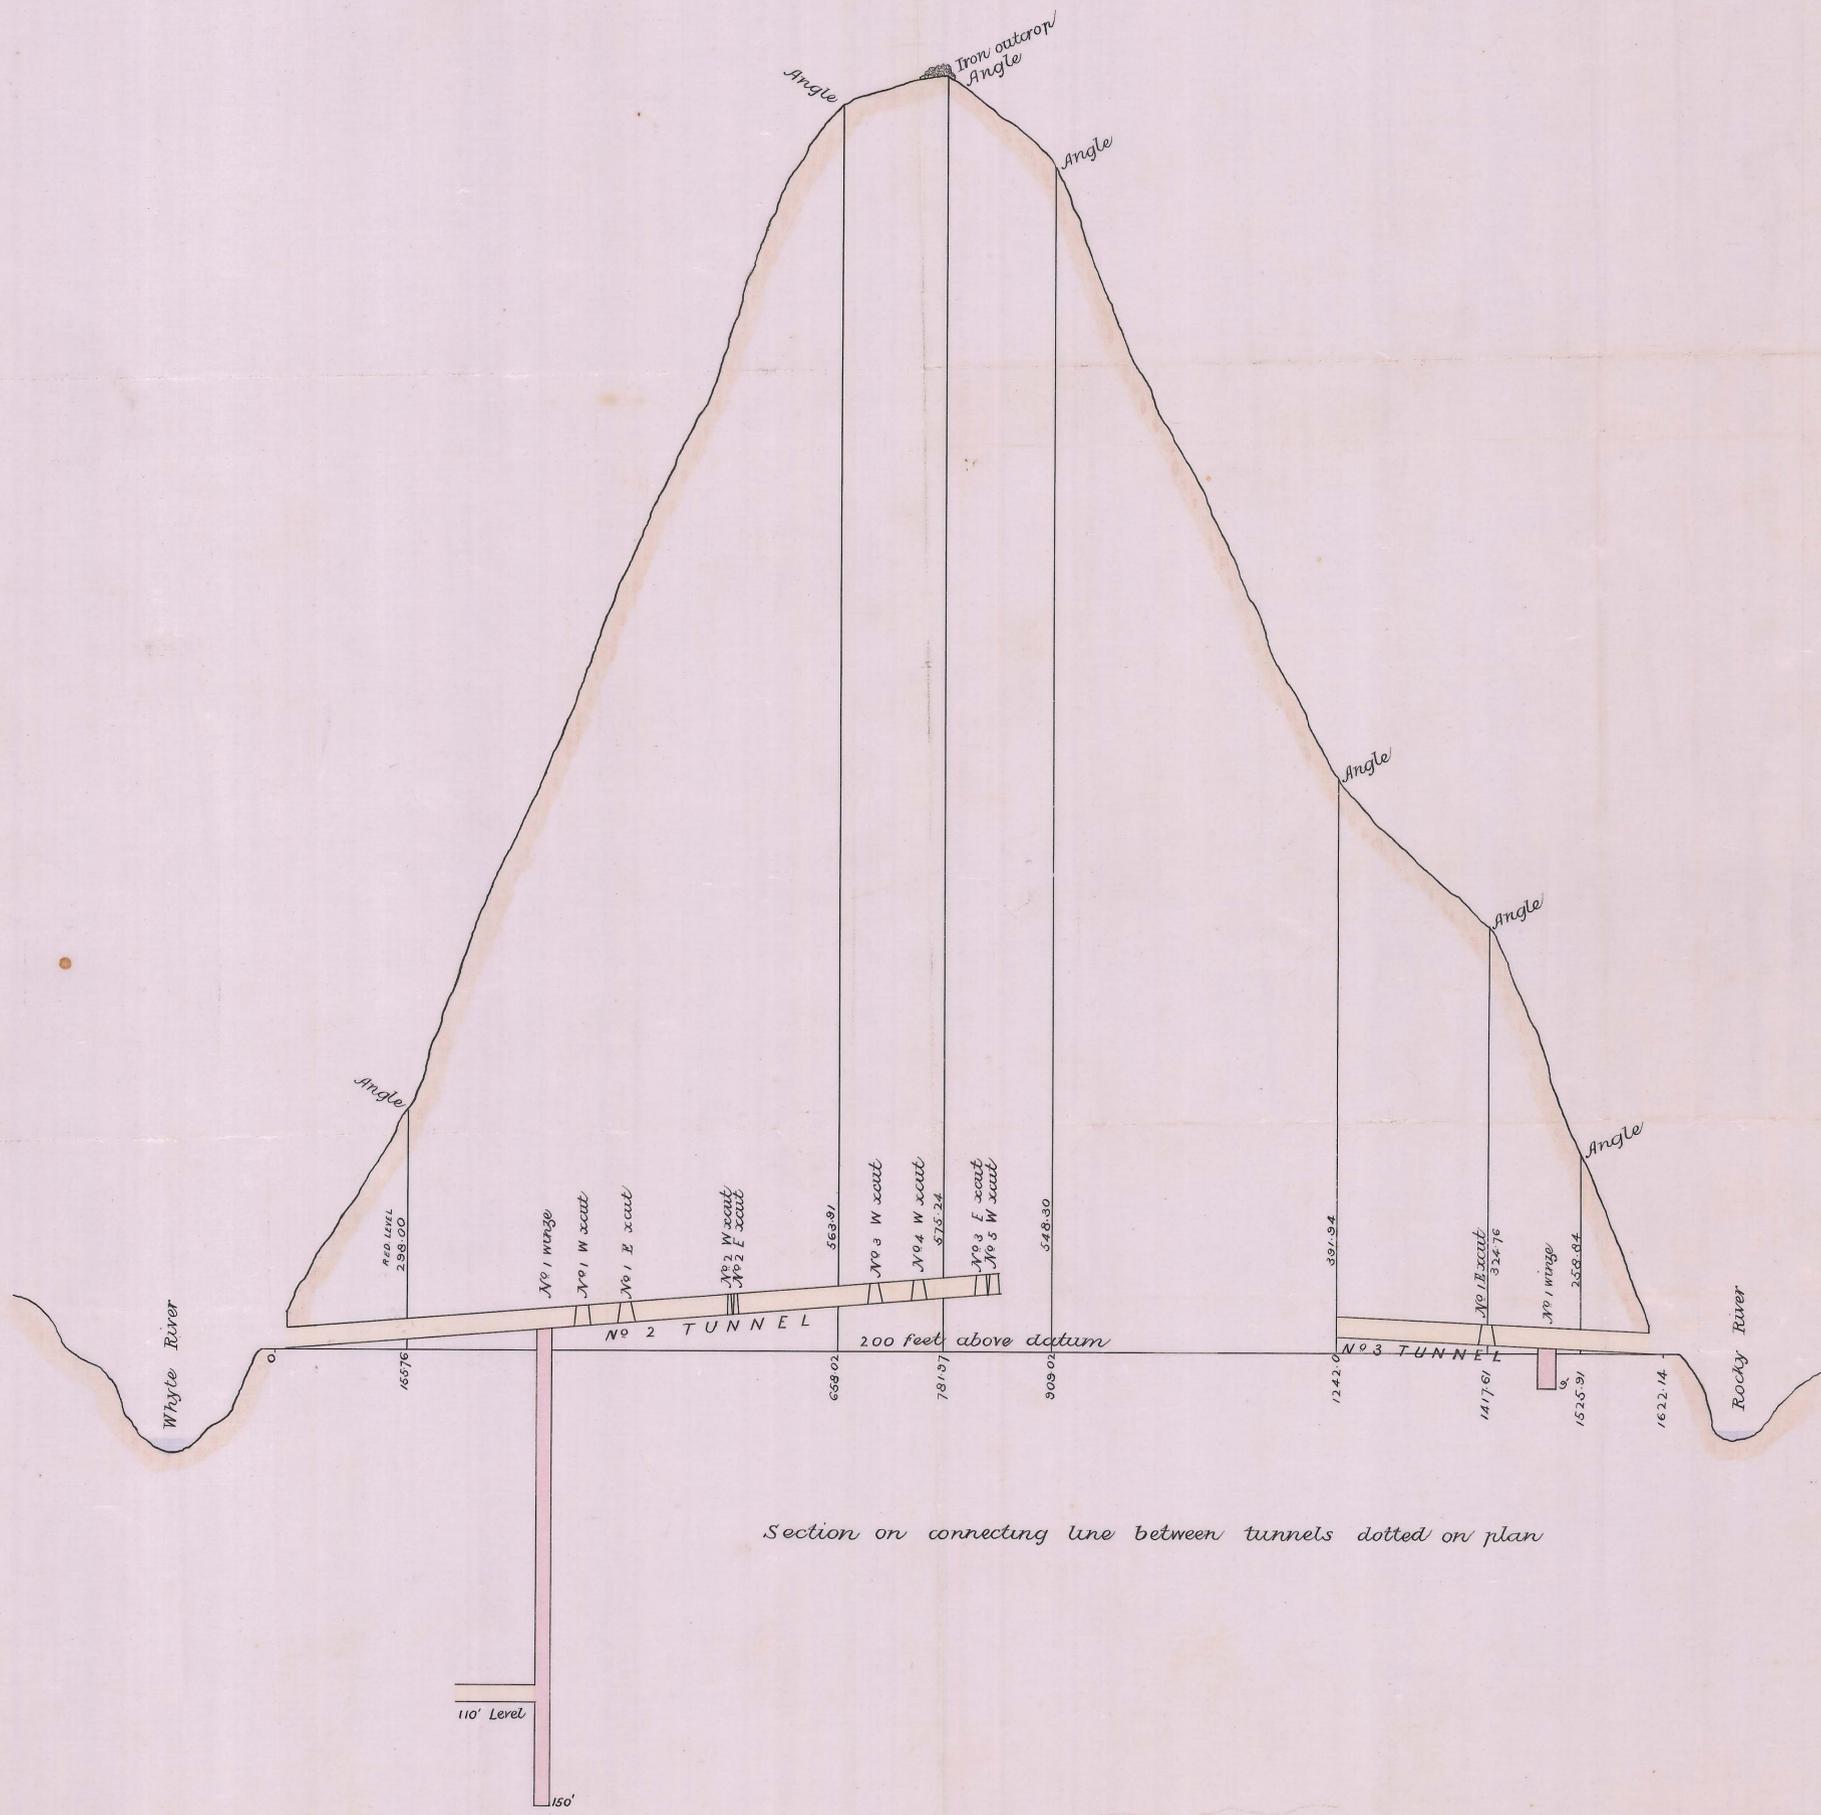

Section on connecting line between tunnels dotted on plan

Joseph Weeks Esq.
Authorized Surveyor
10th March 1900

