


PLAN of CHAMBERLAIN MINING Co's No 1A WORKINGS

Scale. 25 Feet to 1 Inch.

North

911
93 M


61 acres.

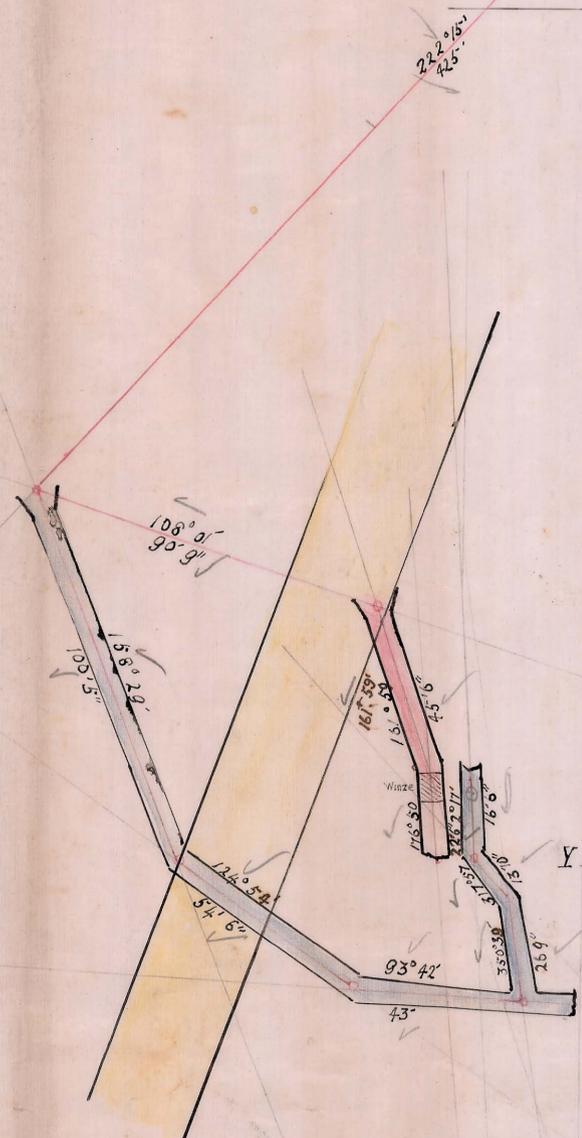


SECTION'S

SCALE 25 Feet to 1 Inch

5 cm

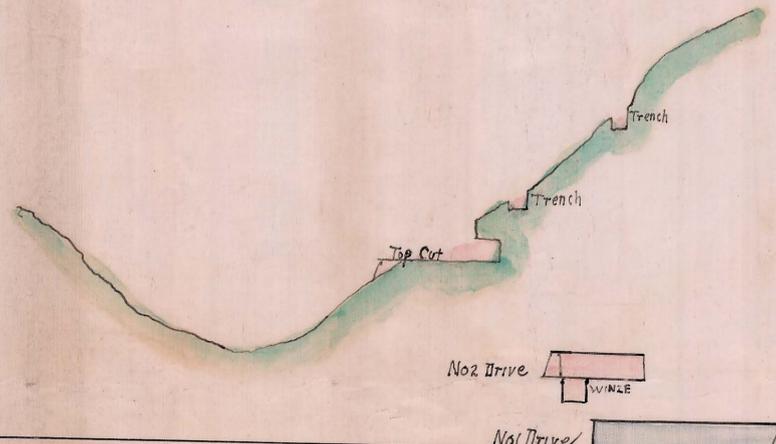

Longitudinal Section

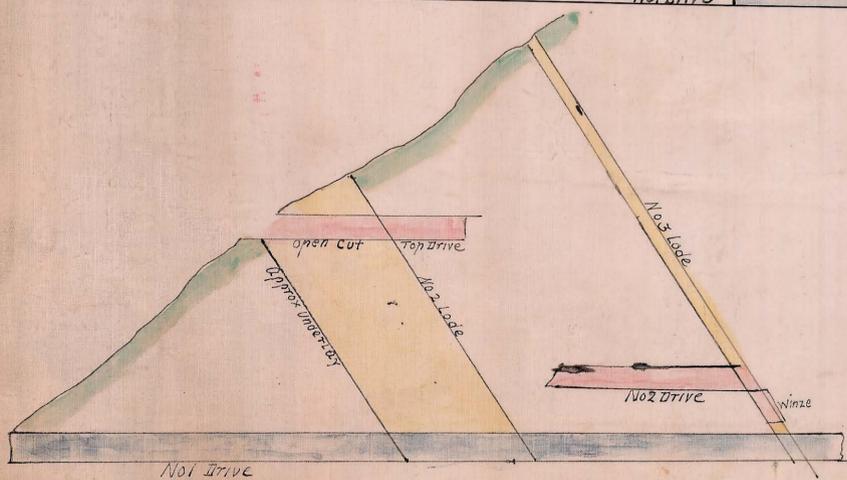

Cross Section

16 Dec 1899

9/11
30

278-01

278-01

Dec 1899