

Plan & Sections of Great Republic Mine.


Twenty-five Feet = One Inch.

Work done previous to January 1891.


Work done from Jan. 1891. to December, 1892.

Sully Bldg.
Dec. 31. 1892.

PLAN.

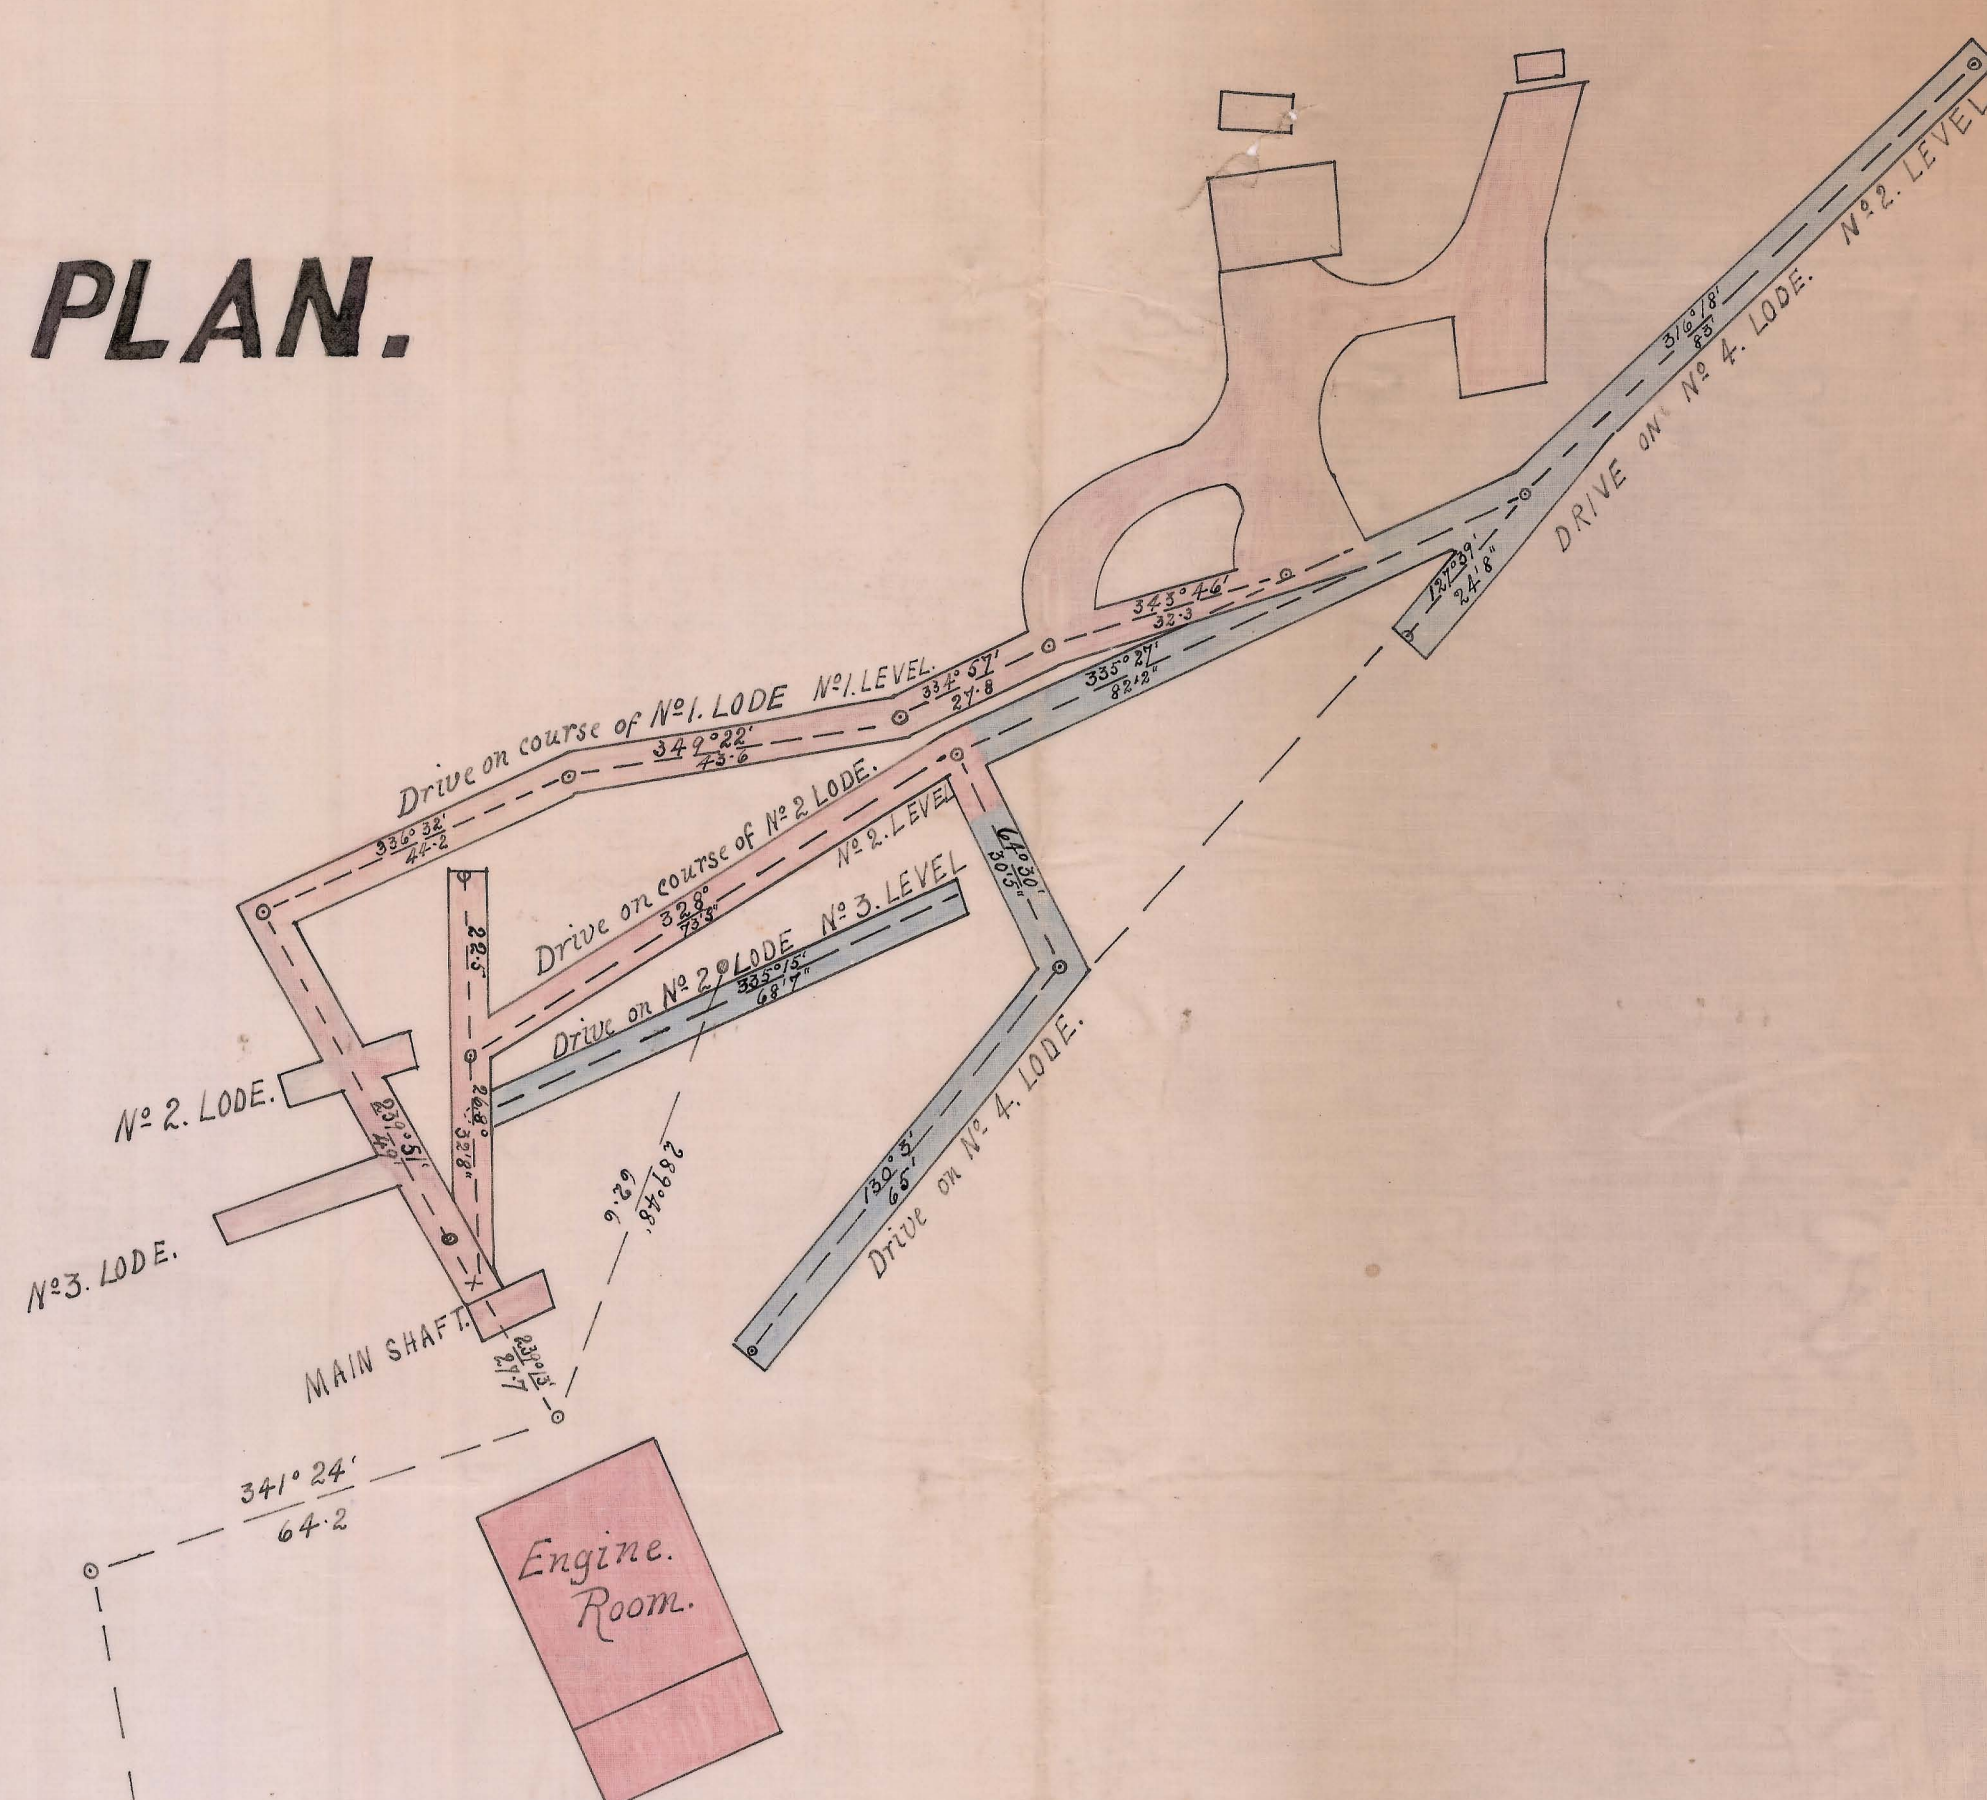

LONGITUDINAL SECTION.

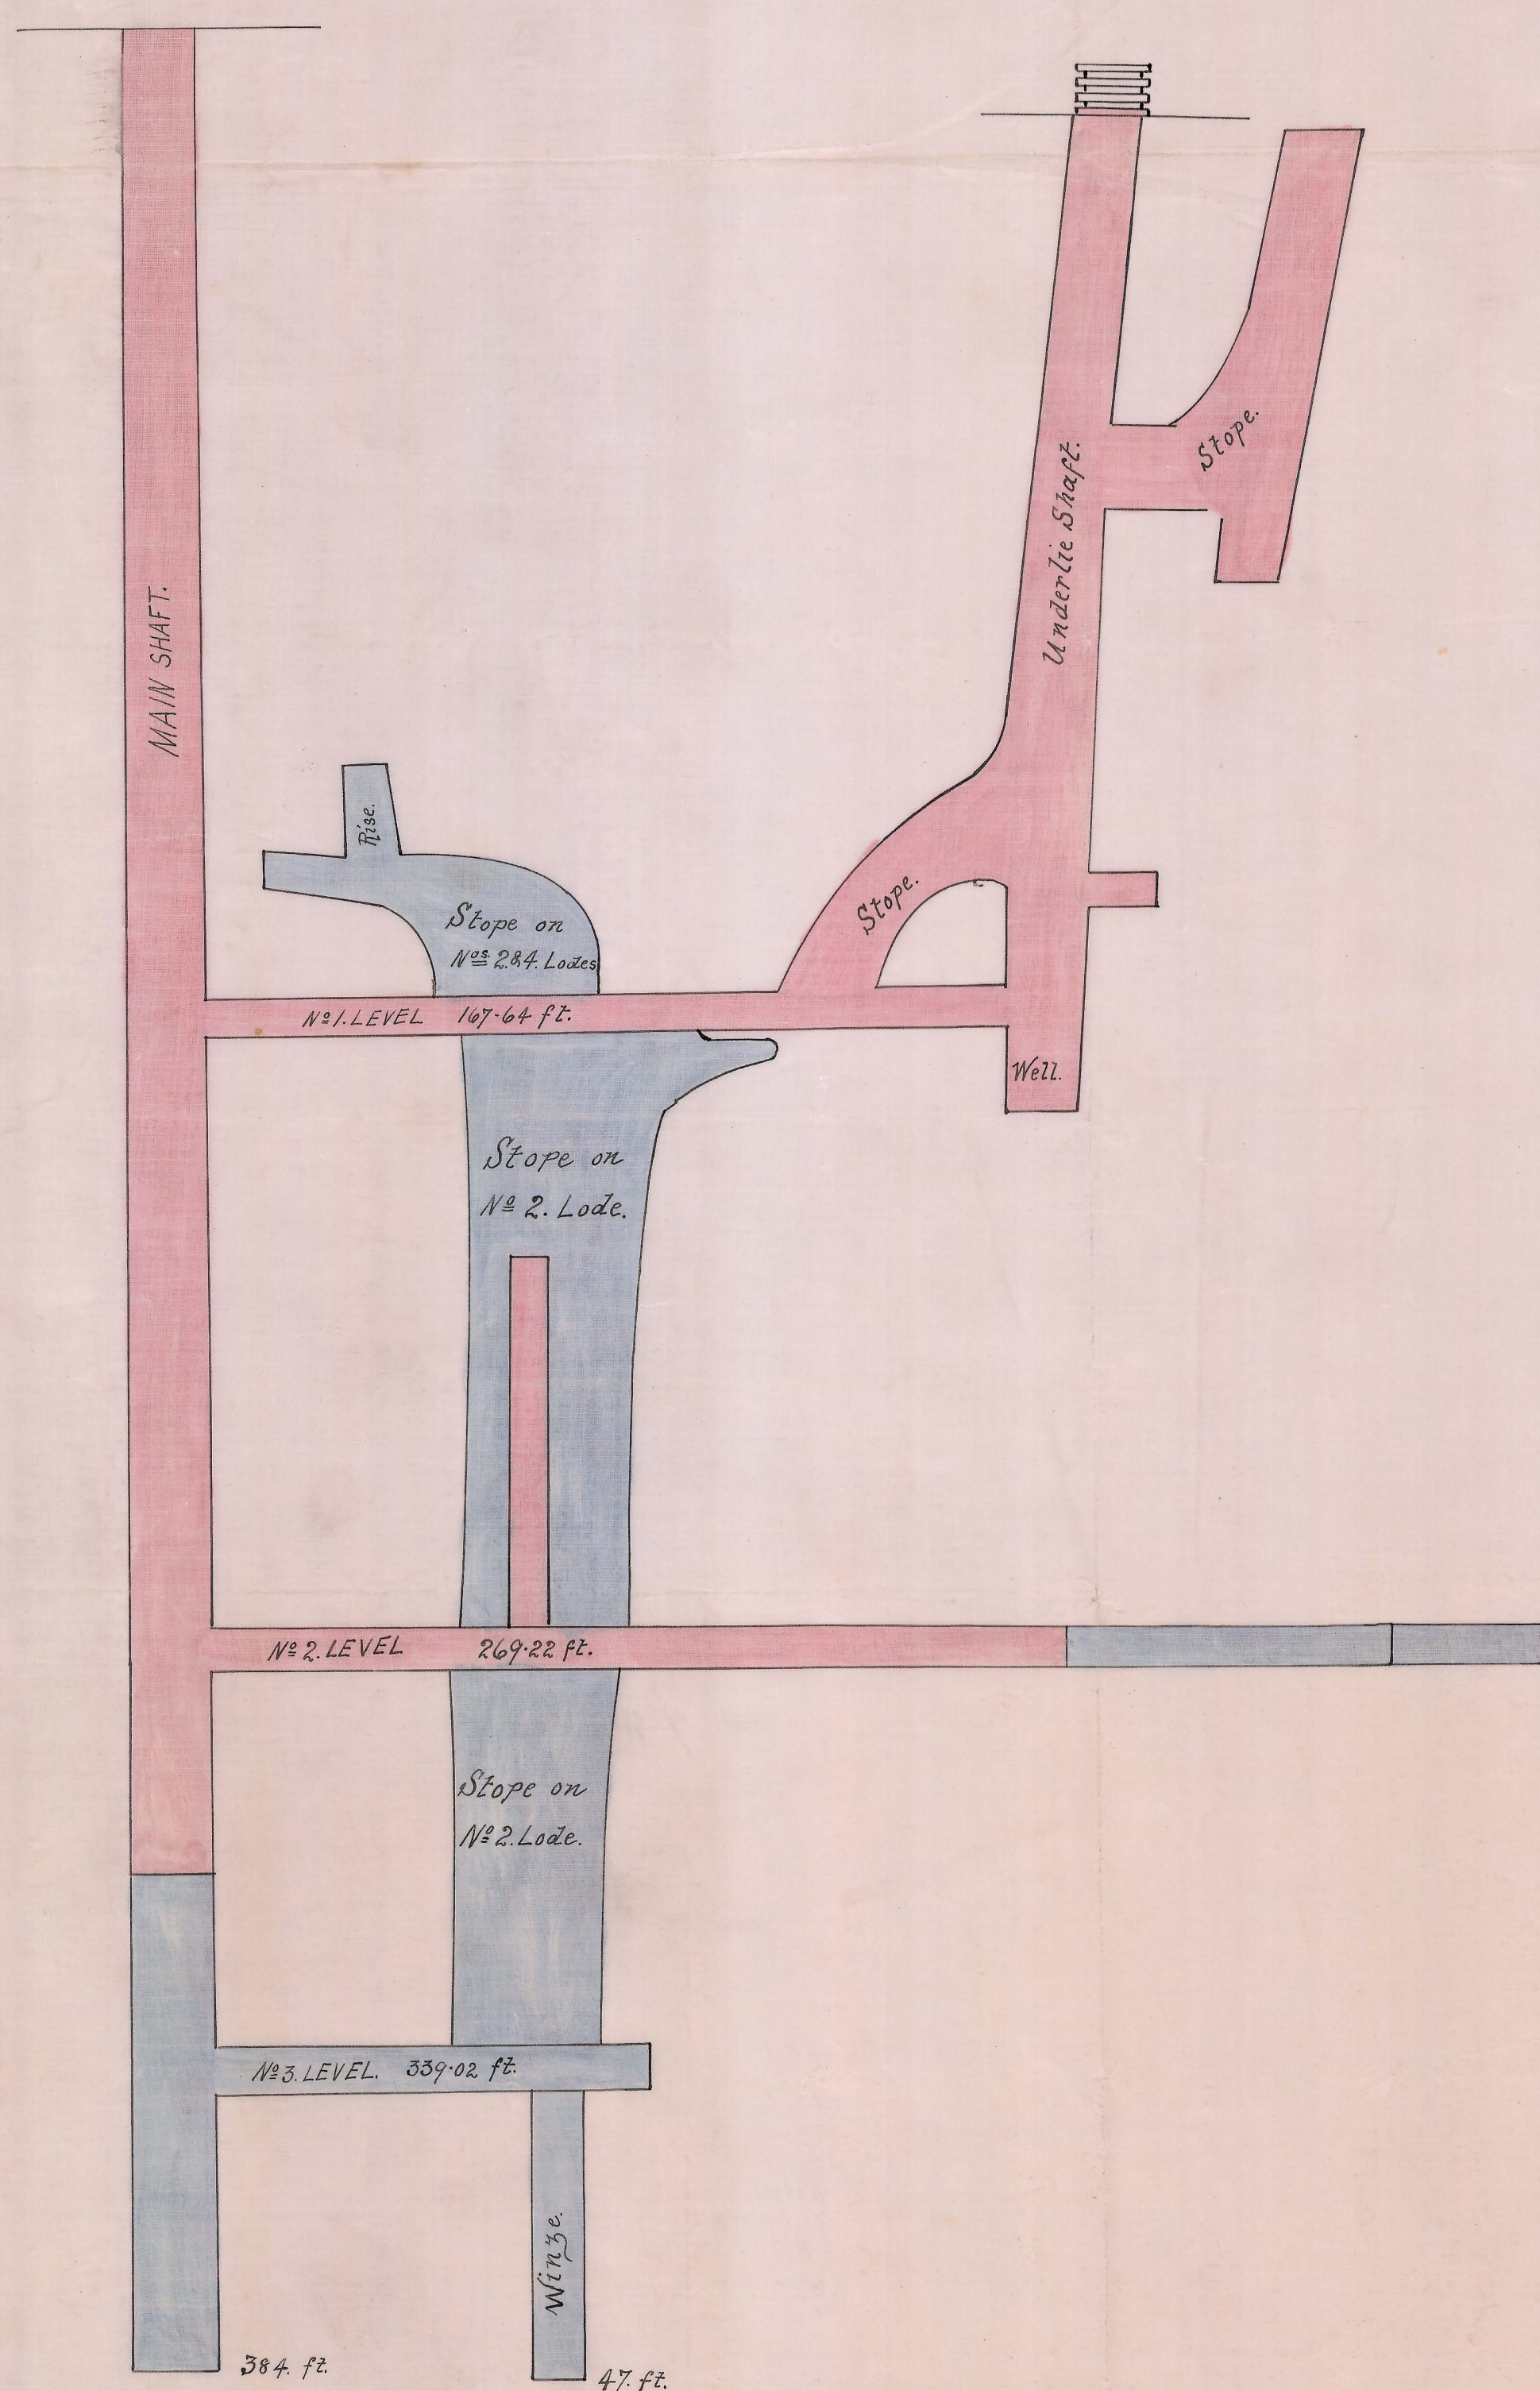

TRANSVERSE SECTION.

