


# The GREAT REPUBLIC TIN MINE

## BEN LOMOND


Plan of Surface Works Underground Drives &

25 ft to an inch

Survey finished 18<sup>th</sup> Jan 1890  
Geo. Eadie  
24<sup>th</sup> Jan 1890

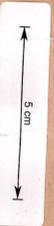

279-03

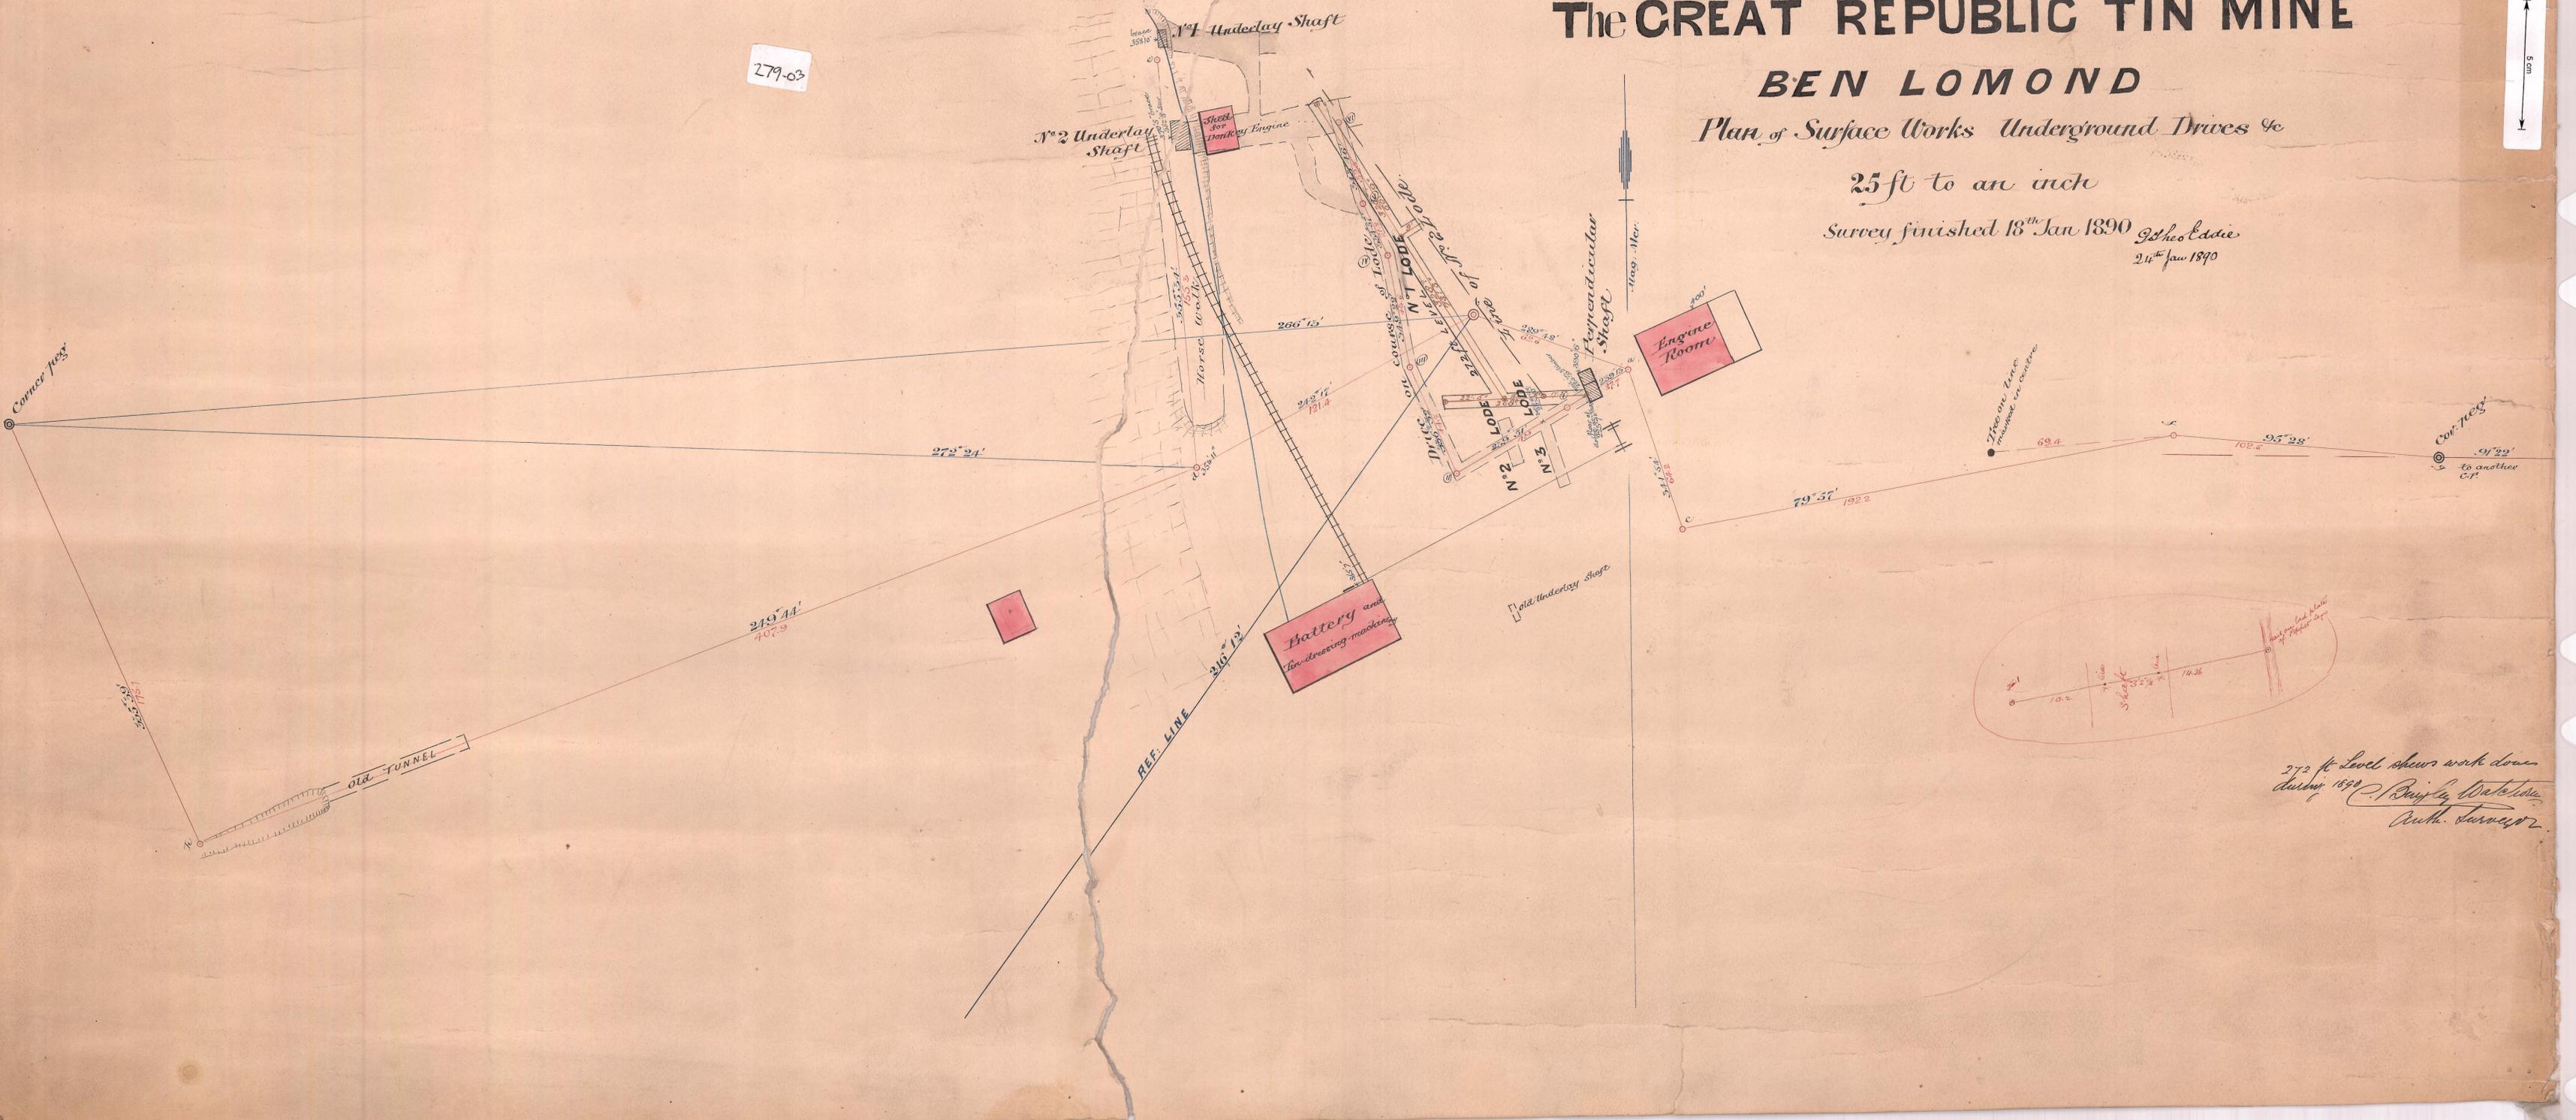

272 ft Level shows work done  
during 1889  
By J. W. Watson  
Auth. Surveyor