

The GREAT REPUBLIC TIN MINE

BEN LOMOND


Longitudinal Section of N°1 Lode

25 ft to an inch

Survey finished 18th Jan 1890

Schofield
24th Jan 1890

279-04

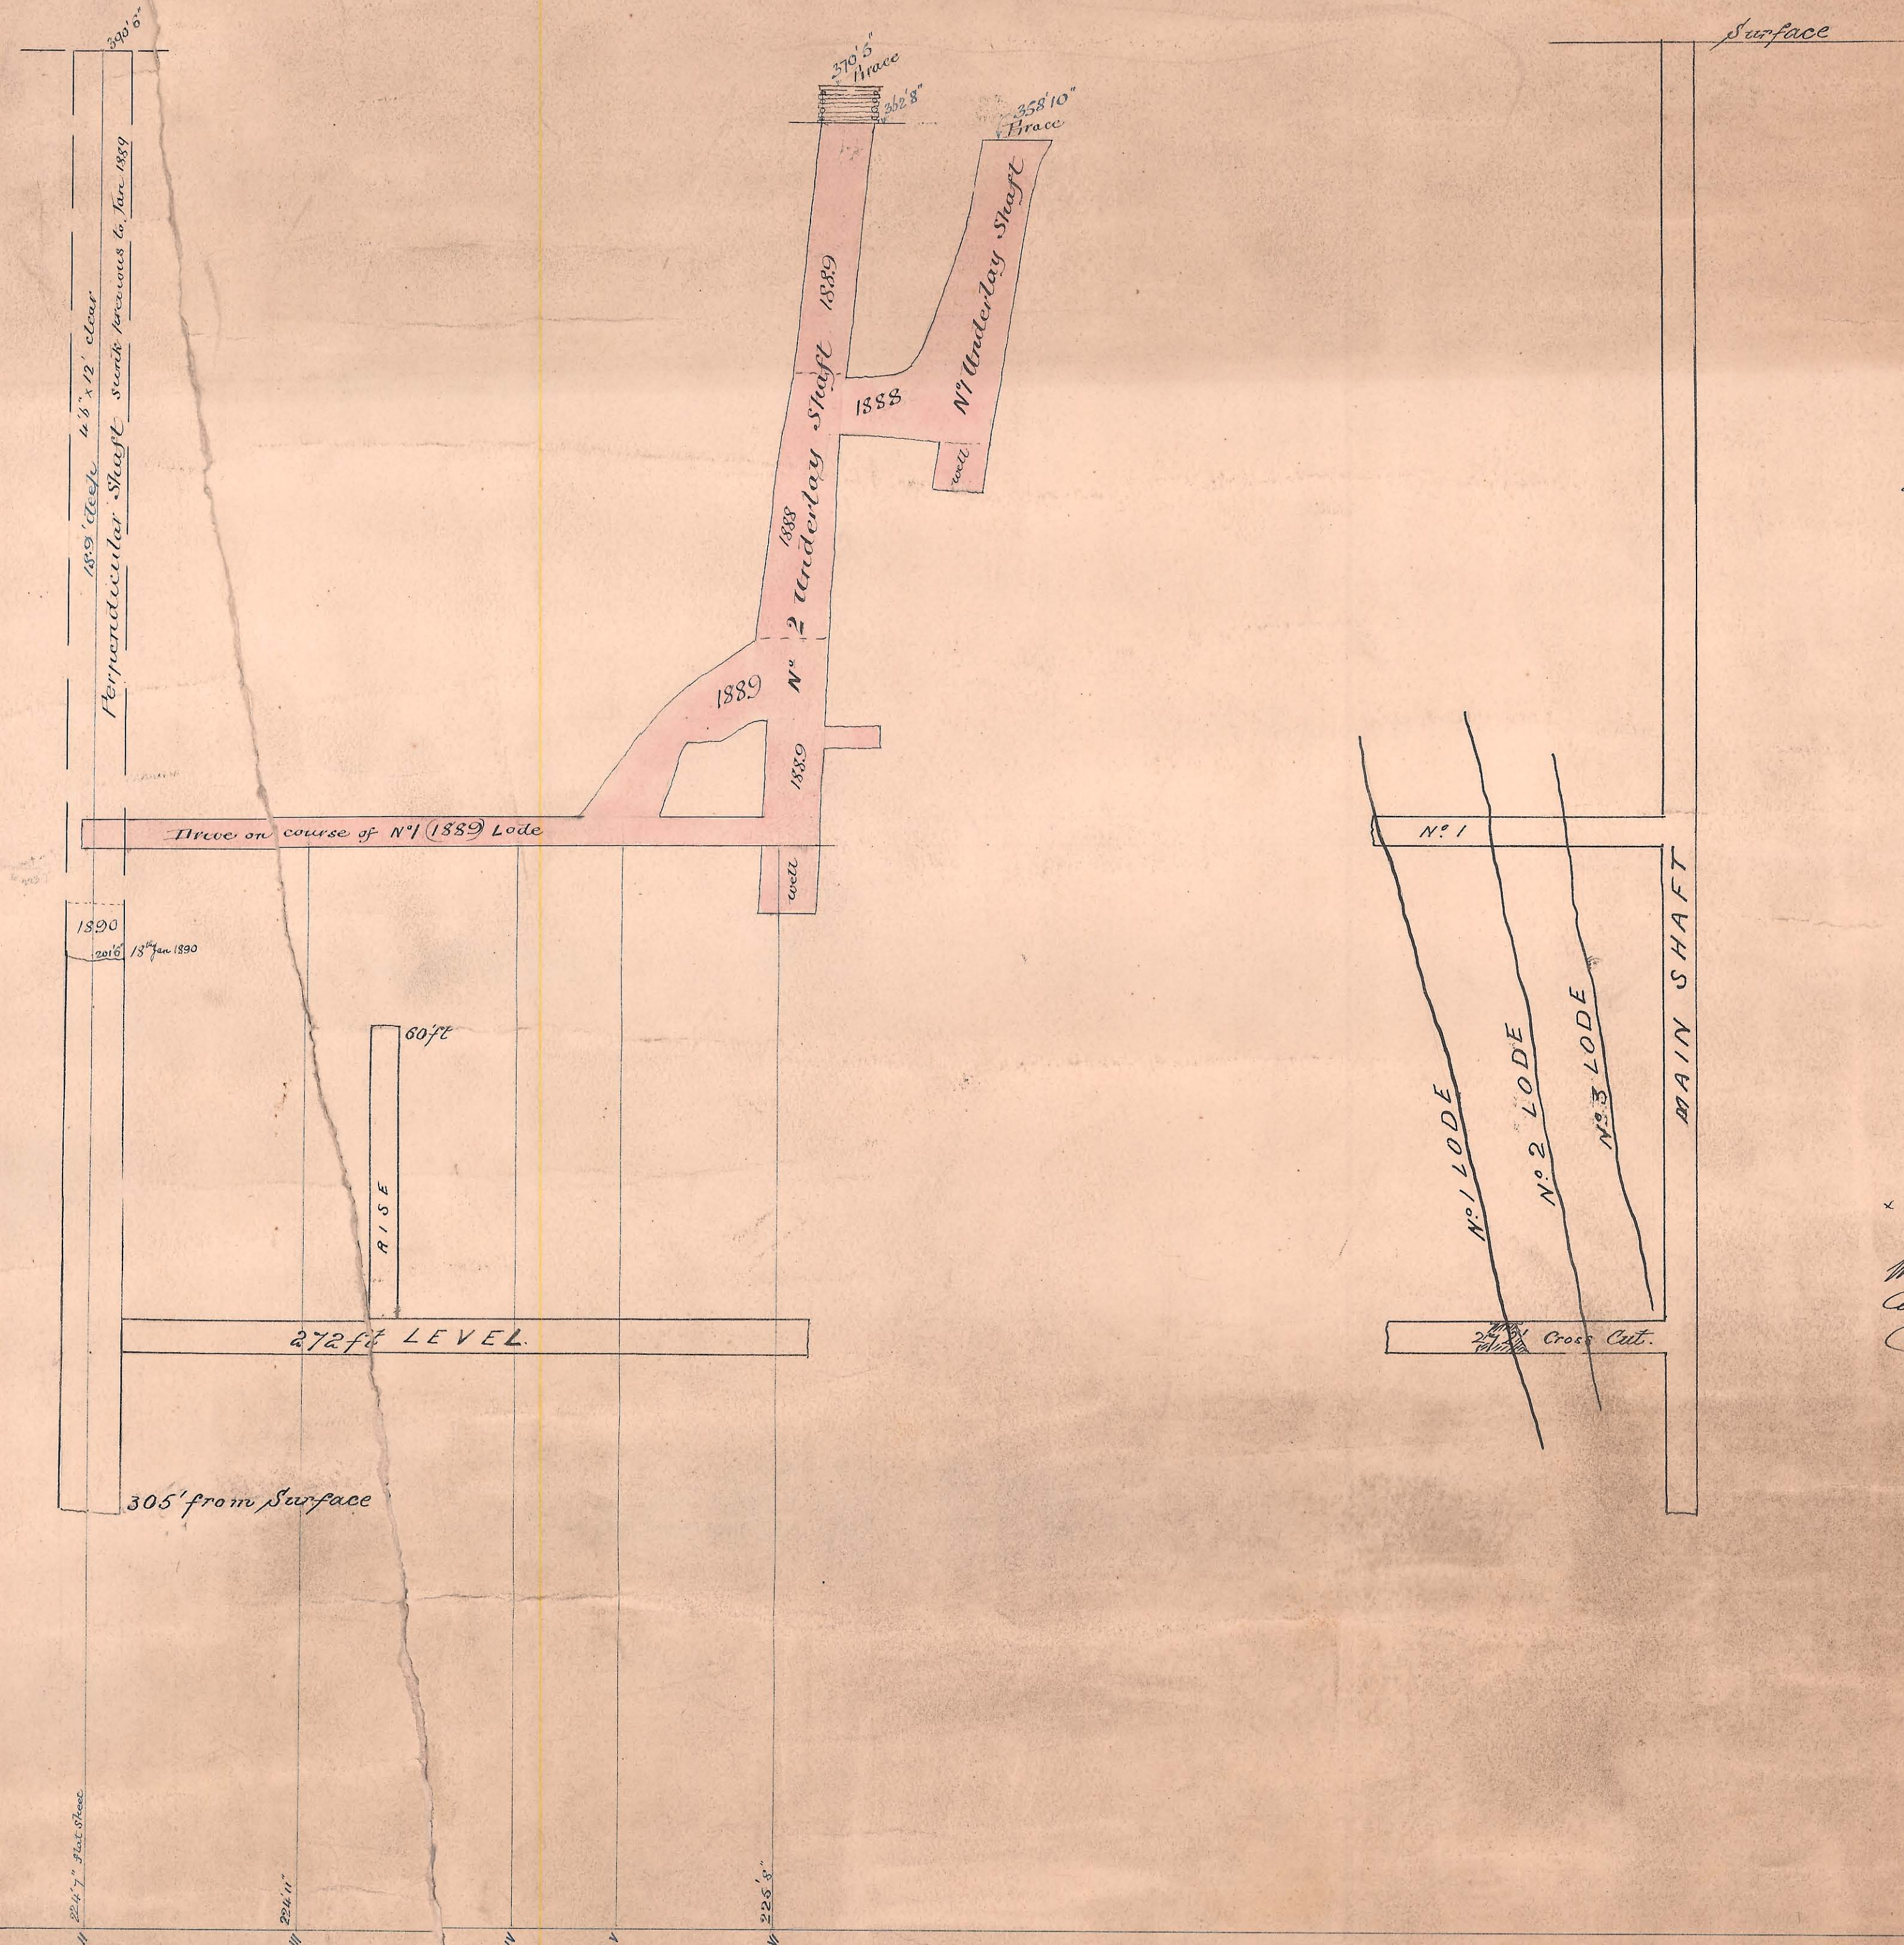

Work done during 1890
Schofield
C. Schofield
A. Schofield