

230-01

5 cm

WESTERN BOUNDARY

230-01

DATUM PEG BOUNDARY


27th March 1894

REX HILL TIN MINING COMPANY  
Scale 25' to 1"


I hereby certify this Plan and Section to be correct  
Surveyed and Drawn by me S. C. Richards  
M.S.M.  
Instrument used Hoedly Dial made in 1894

N 26° 30' W  
547

PLAN

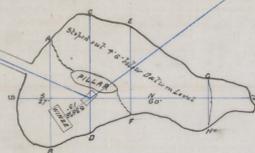

LONGITUDINAL SECTION  
ON NS

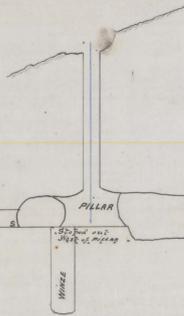

TRANSVERSE SECTIONS  
ON A C E G  
B D F H LOOKING NORTH

