


280-03

*Mr. J. W. ...
Dec 1895*

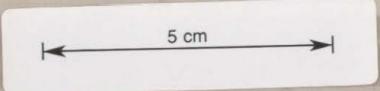



290-03

— REX HILL TIN MINING COMPANY —

— Scale 25 feet to an Inch —


*Surveyed and Drawn by
E. Richards
9/16/95*

PLAN

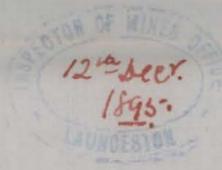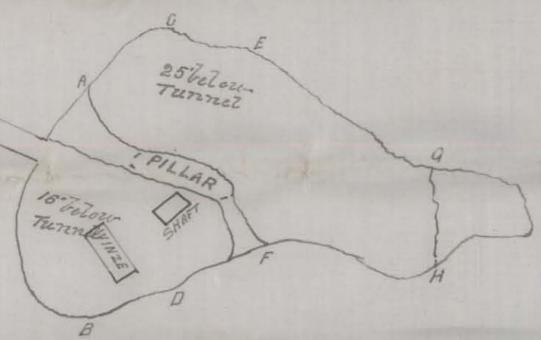


*This plan
not have been
till January*

LONGITUDINAL SECTION

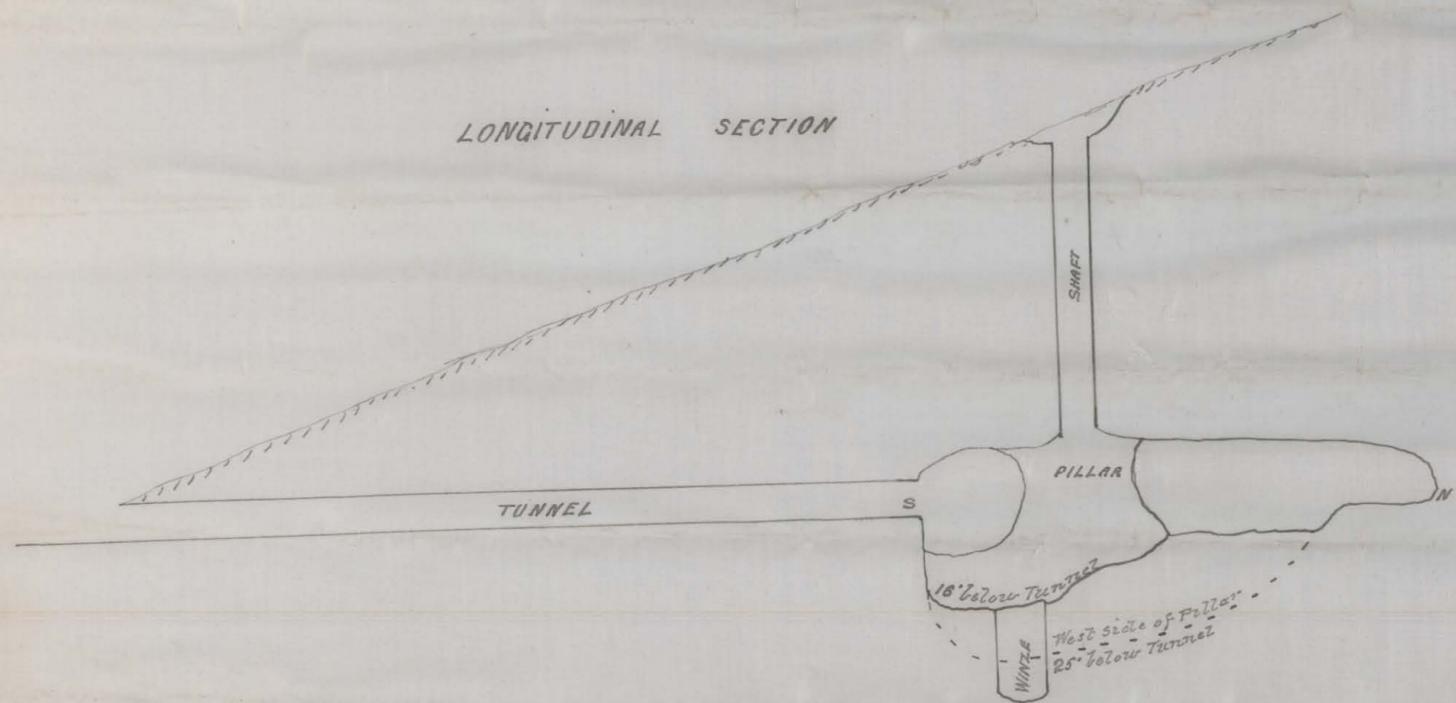

TRANSVERSE SECTIONS

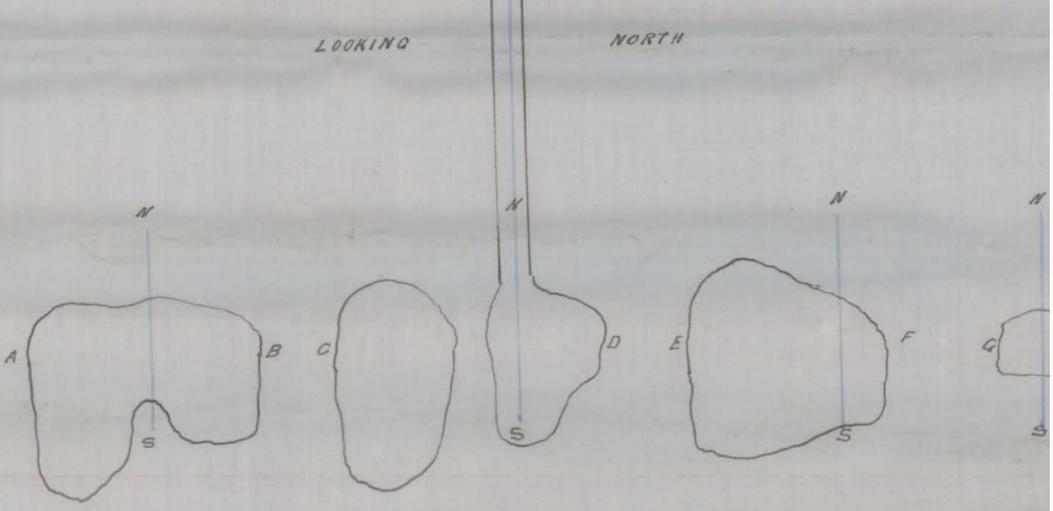

10