


280-04

5 cm


280-04

— PLAN AND SECTION —  
 — OF —  
 — UNDERGROUND WORKINGS —  
 — REX HILL T.M.C<sup>o</sup> LIM —  
 — PARISH OF MALVERN —  
 — COUNTY OF CORNWALL —


SECTION AT AB

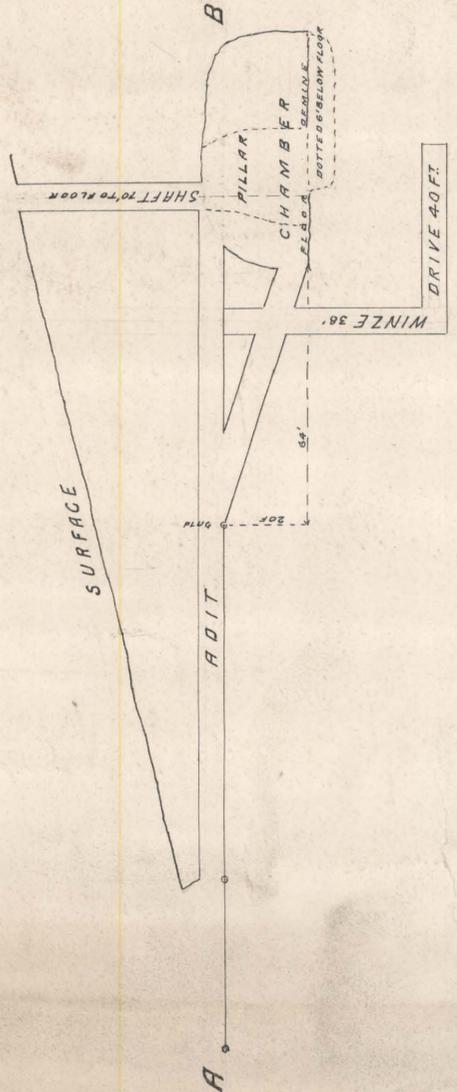

SCALES HORZ. and VERT. — 25 FEET TO 1 INCH

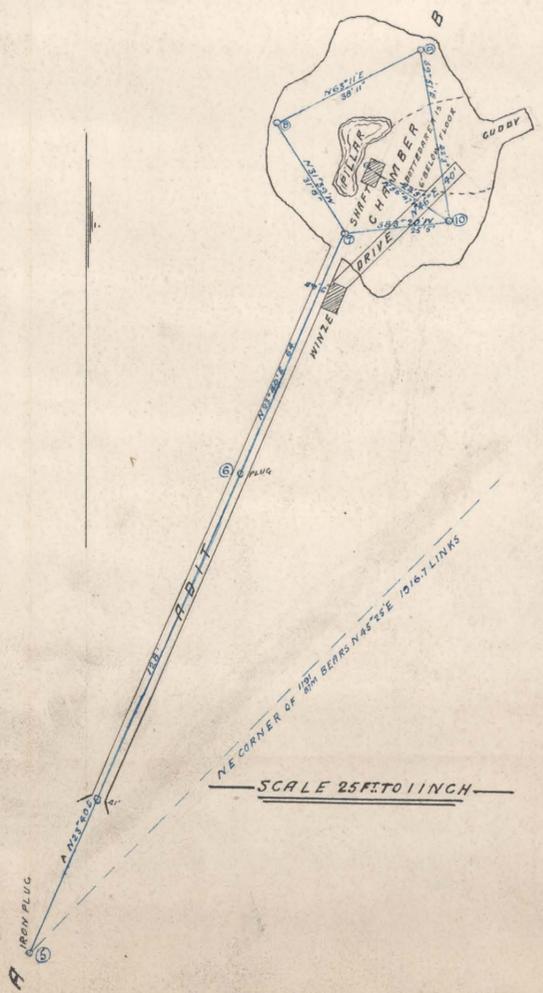

SCALE 25 FT TO 1 INCH

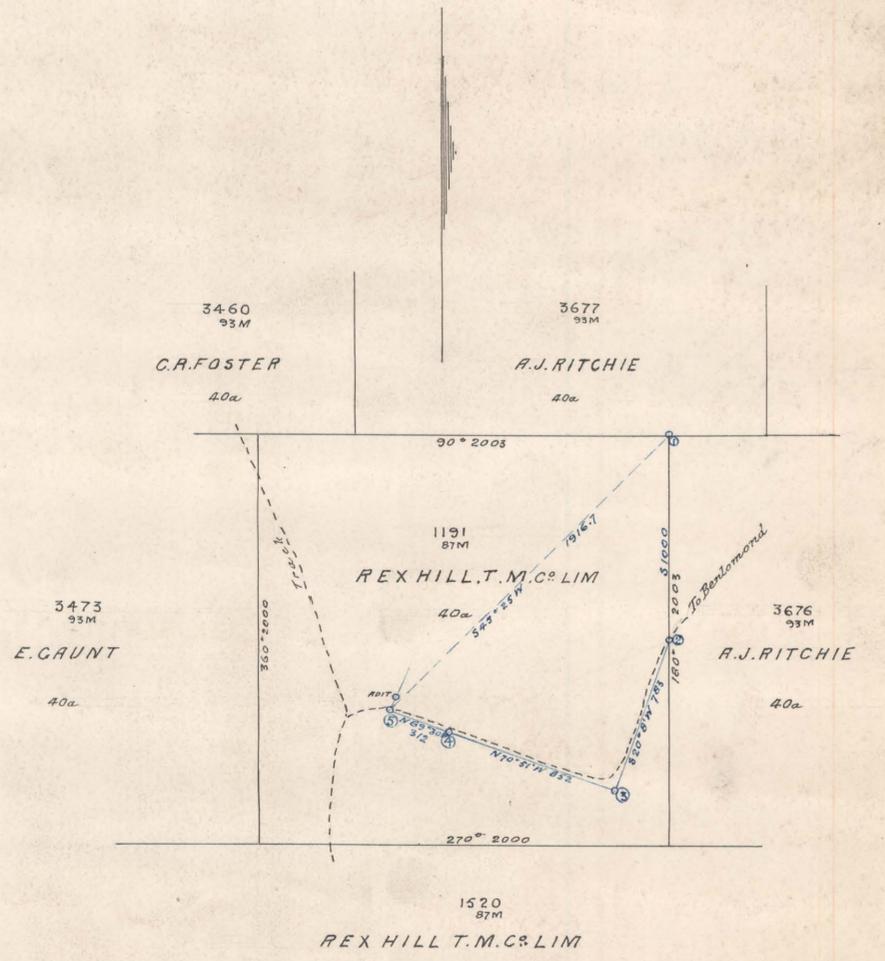

SCALE 5 CM TO 1 INCH



W. J. Bourne  
 Mining Surveyor  
 15<sup>th</sup> Feb 1900  
 Theodolite used