


280-05




280-05

THE CHIEF INSPECTOR  
OF MINES


SECTION AT A.B.

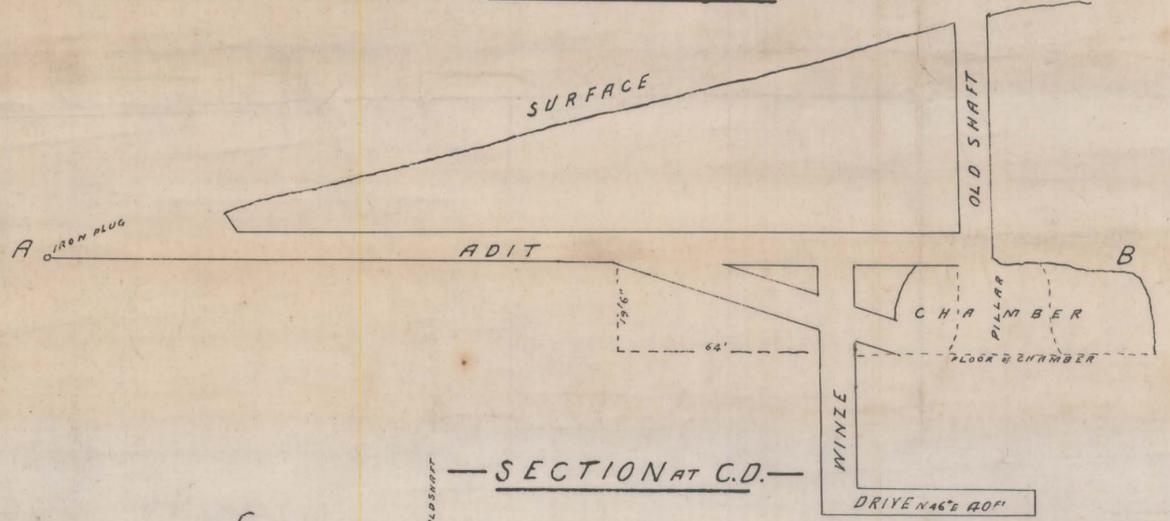

SECTION AT C.D.

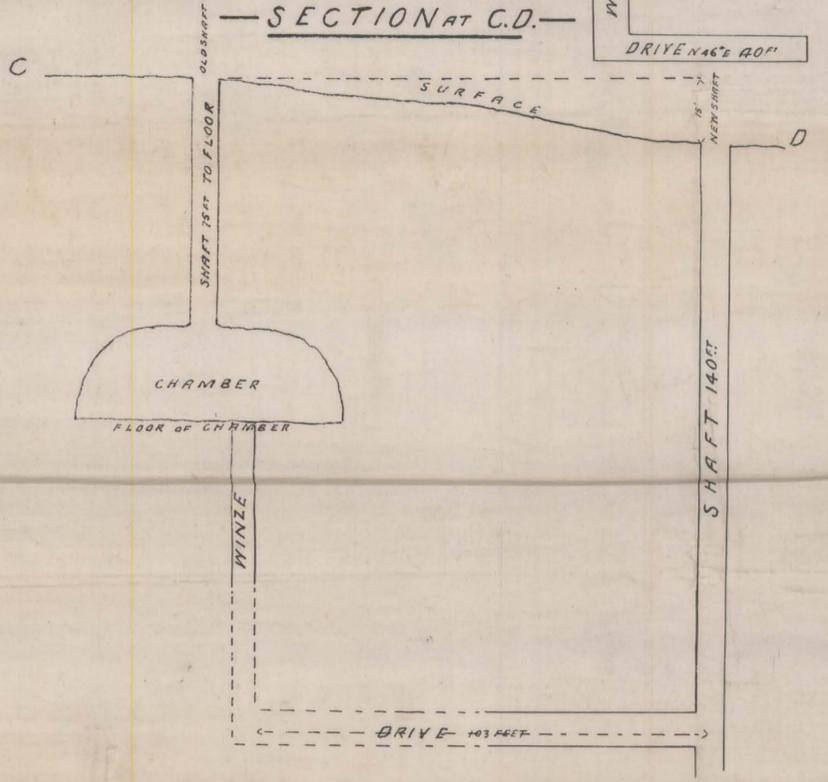

PLAN

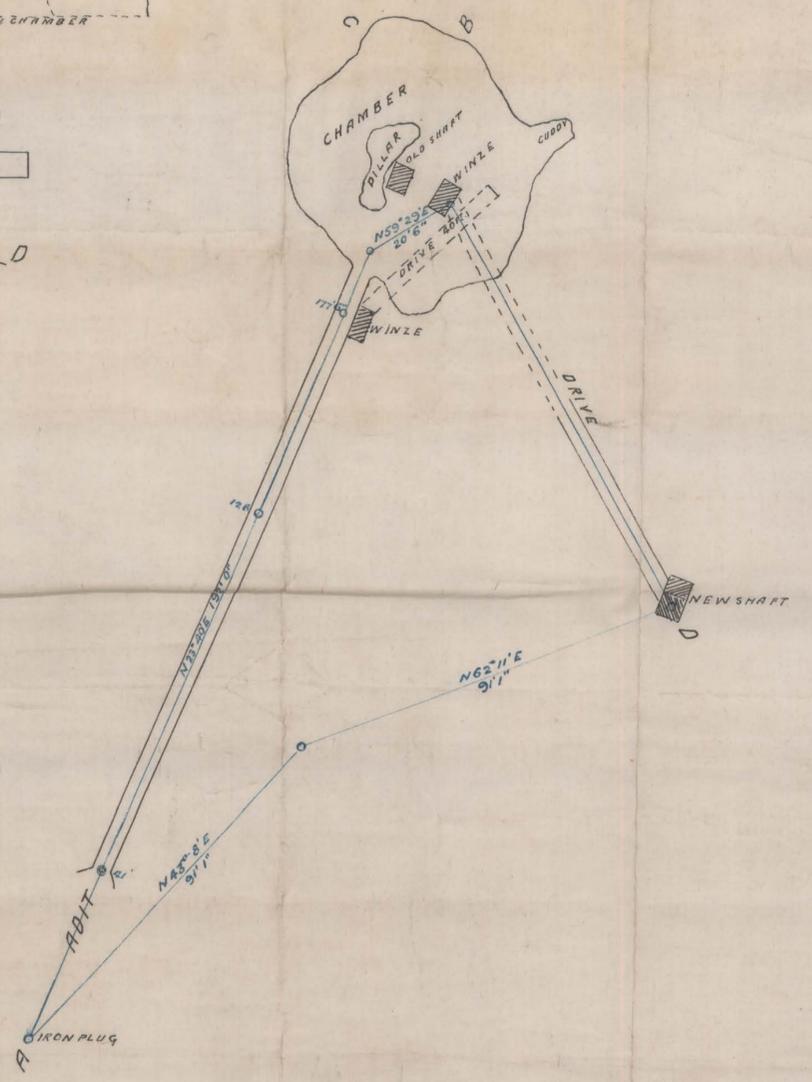

PLAN AND SECTIONS  
OF  
UNDERGROUND WORKINGS  
THE M<sup>r</sup>. REX T.M.C<sup>o</sup>. N.L.

COUNTY CORNWALL  
SCALE 25 FEET TO 1 INCH  
INSTRUMENT USED THEODOLITE


Wm. J. Burrows  
Authorized Mining Surveyor  
14<sup>th</sup> January 1901



SCALE 5 CM TO 1 INCH

3460  
93M  
C. R. FOSTER  
40a  
3473  
93M  
E. GAUNT  
40a

3677  
93M  
A. J. RITCHIE  
40a

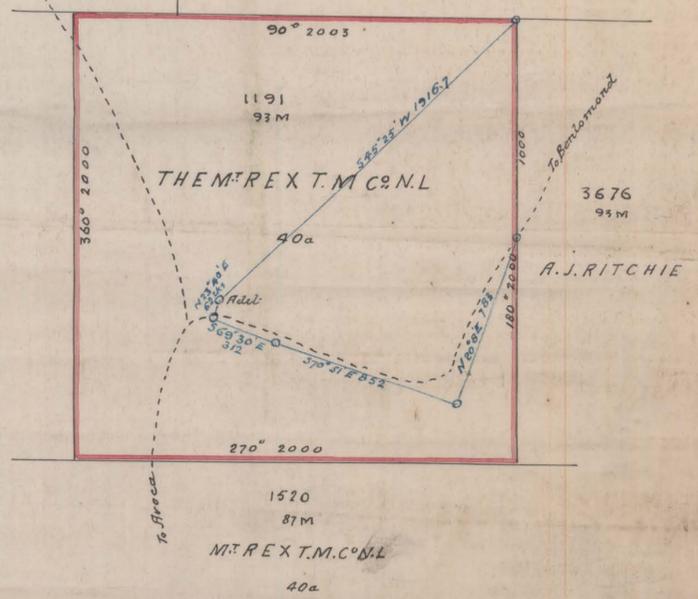

Jan 1901  
Wm. J. Burrows