

William
J. M. J.

230-07

230-07





5 cm

M^T REX MINE

PLAN

SCALE

1 in = 25 ft

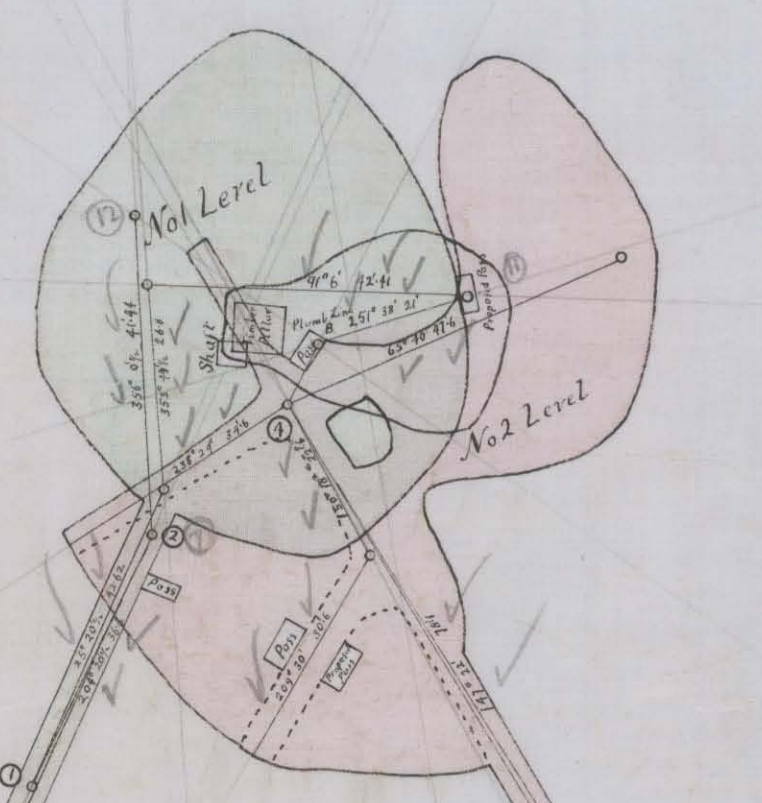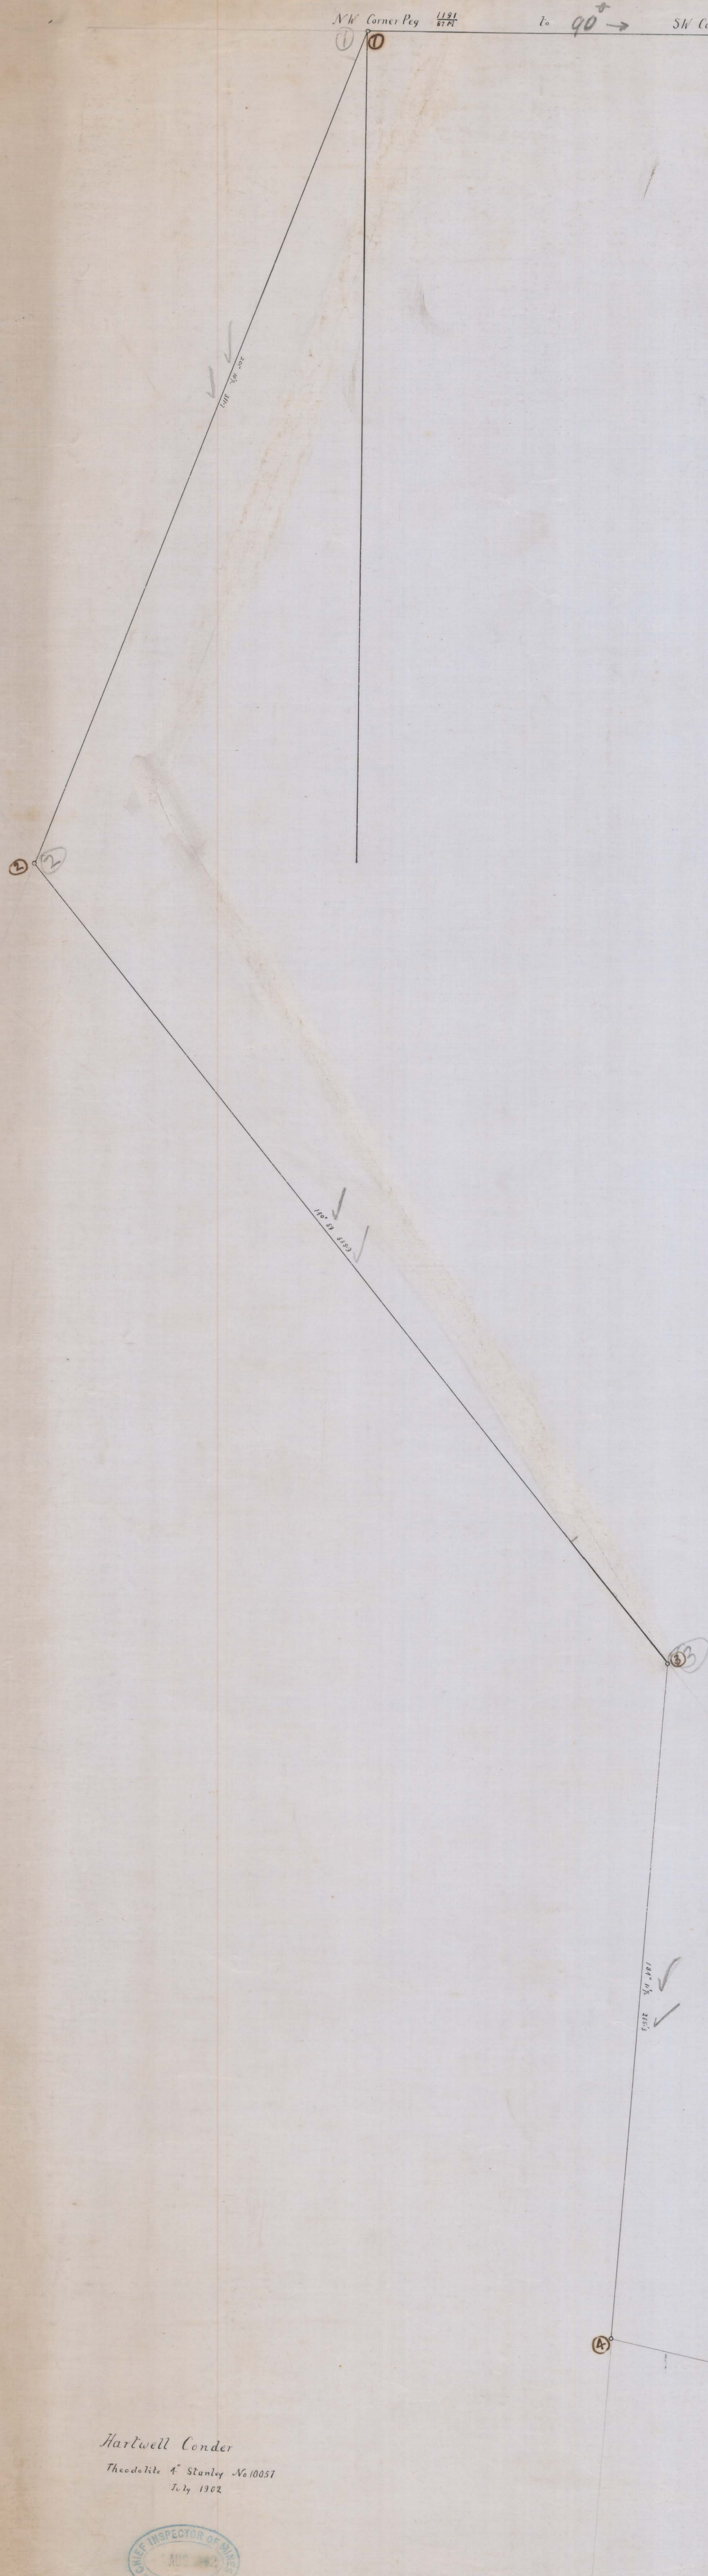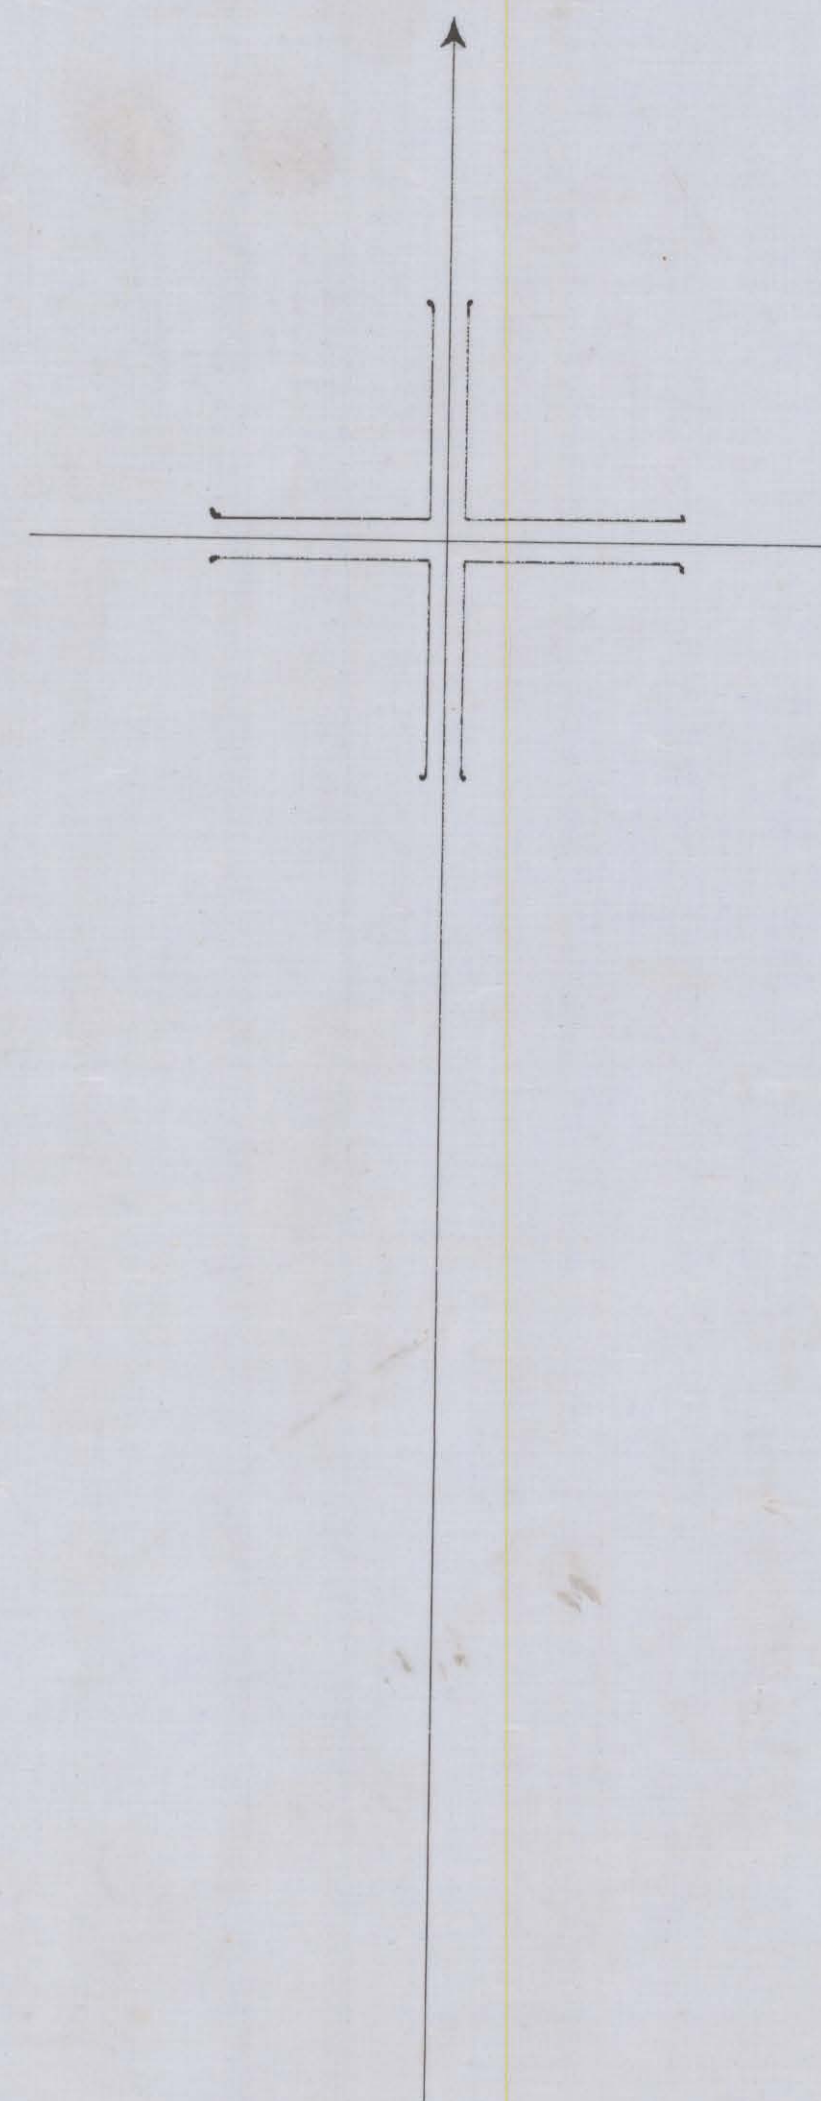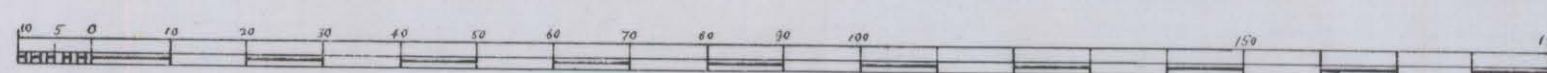

Hartwell Corder
Theodore & Stanley No. 0057
July 1902

