


M^t Rex Mine

Plan

Scale 1 in = 25 ft

5 cm

280-08

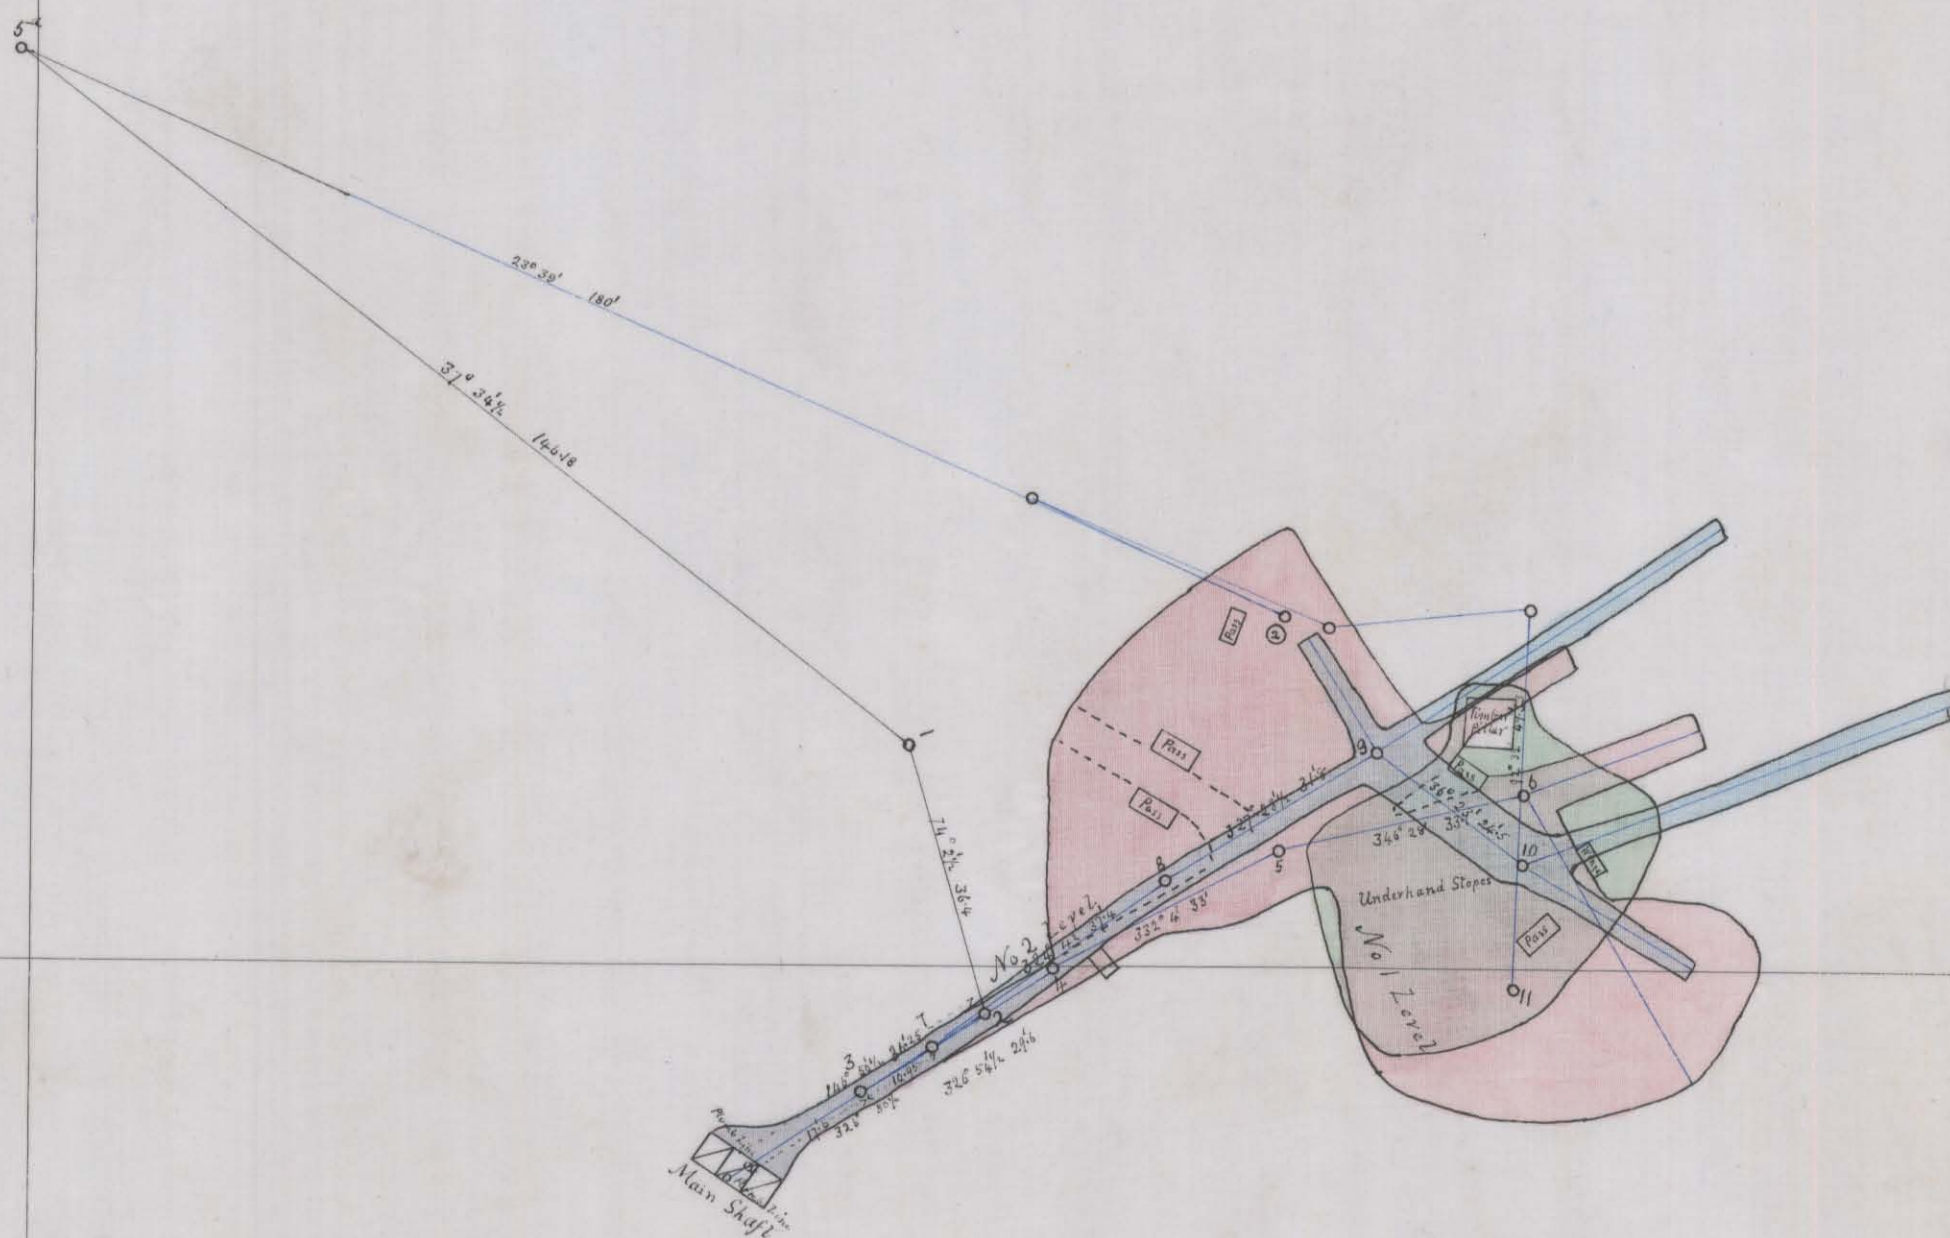

HARTWELL CONDER
MINING ENGINEER

8 JUL 03
LAUNCESTON

Hartwell Conder.
MA. ARSM
7th July 1903

280-08

100