

280-09

5 cm

280-09



Mt Rex Mine

Sections

Scale 1 in = 25 ft

S-N

W-E

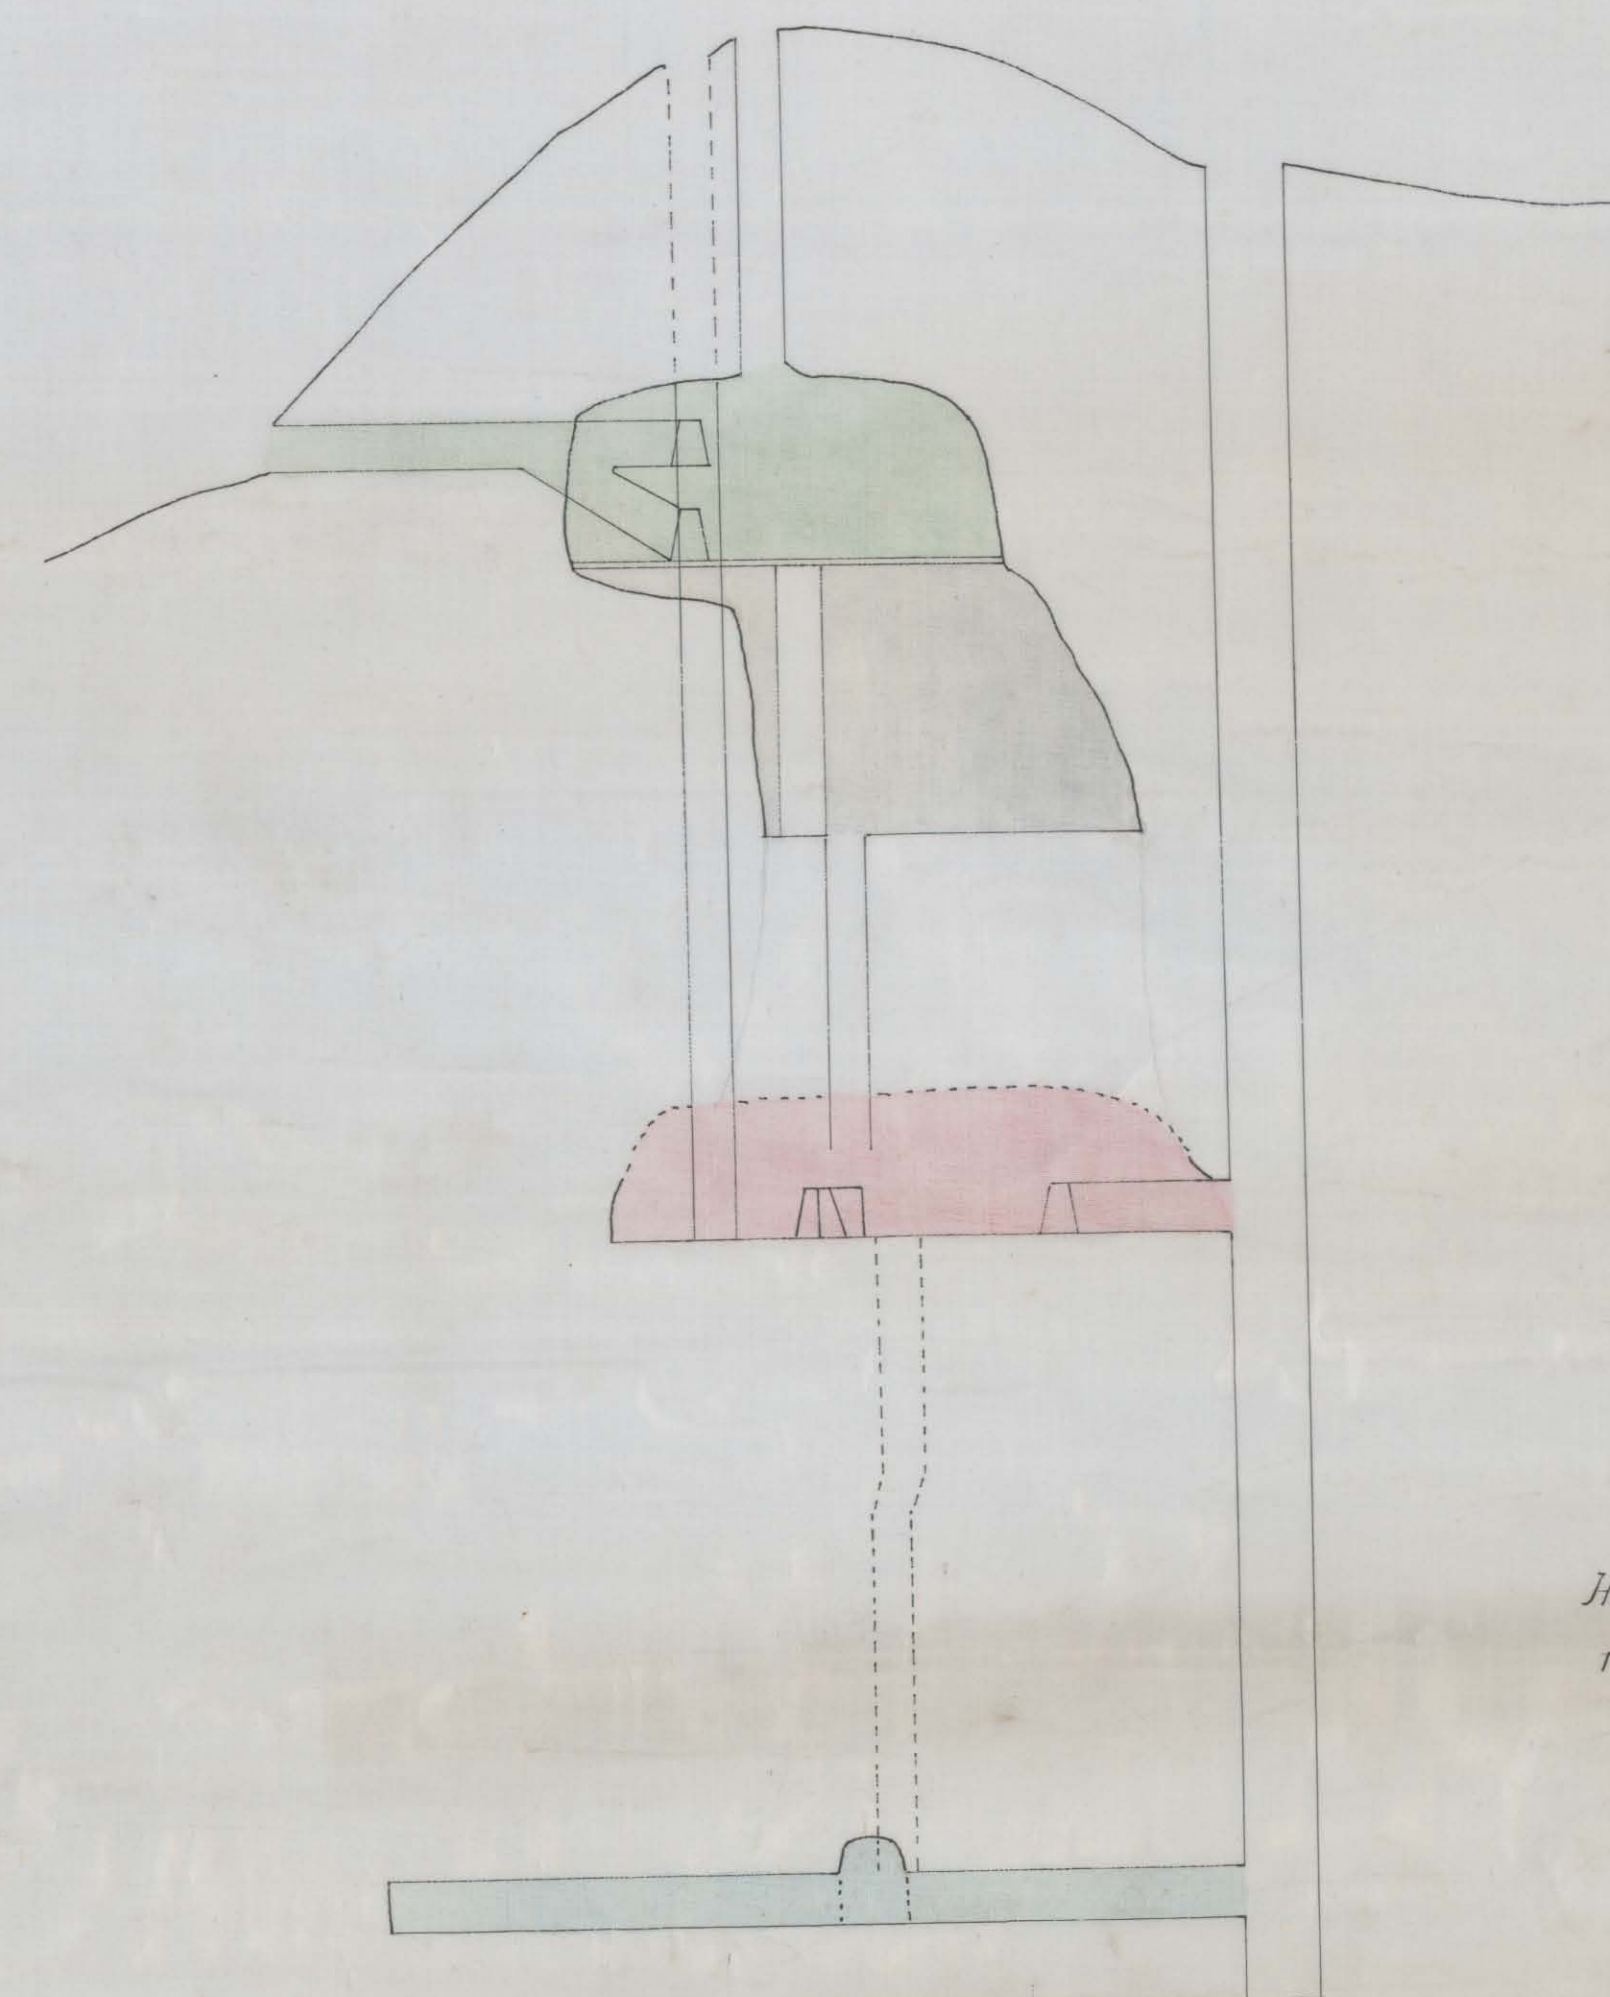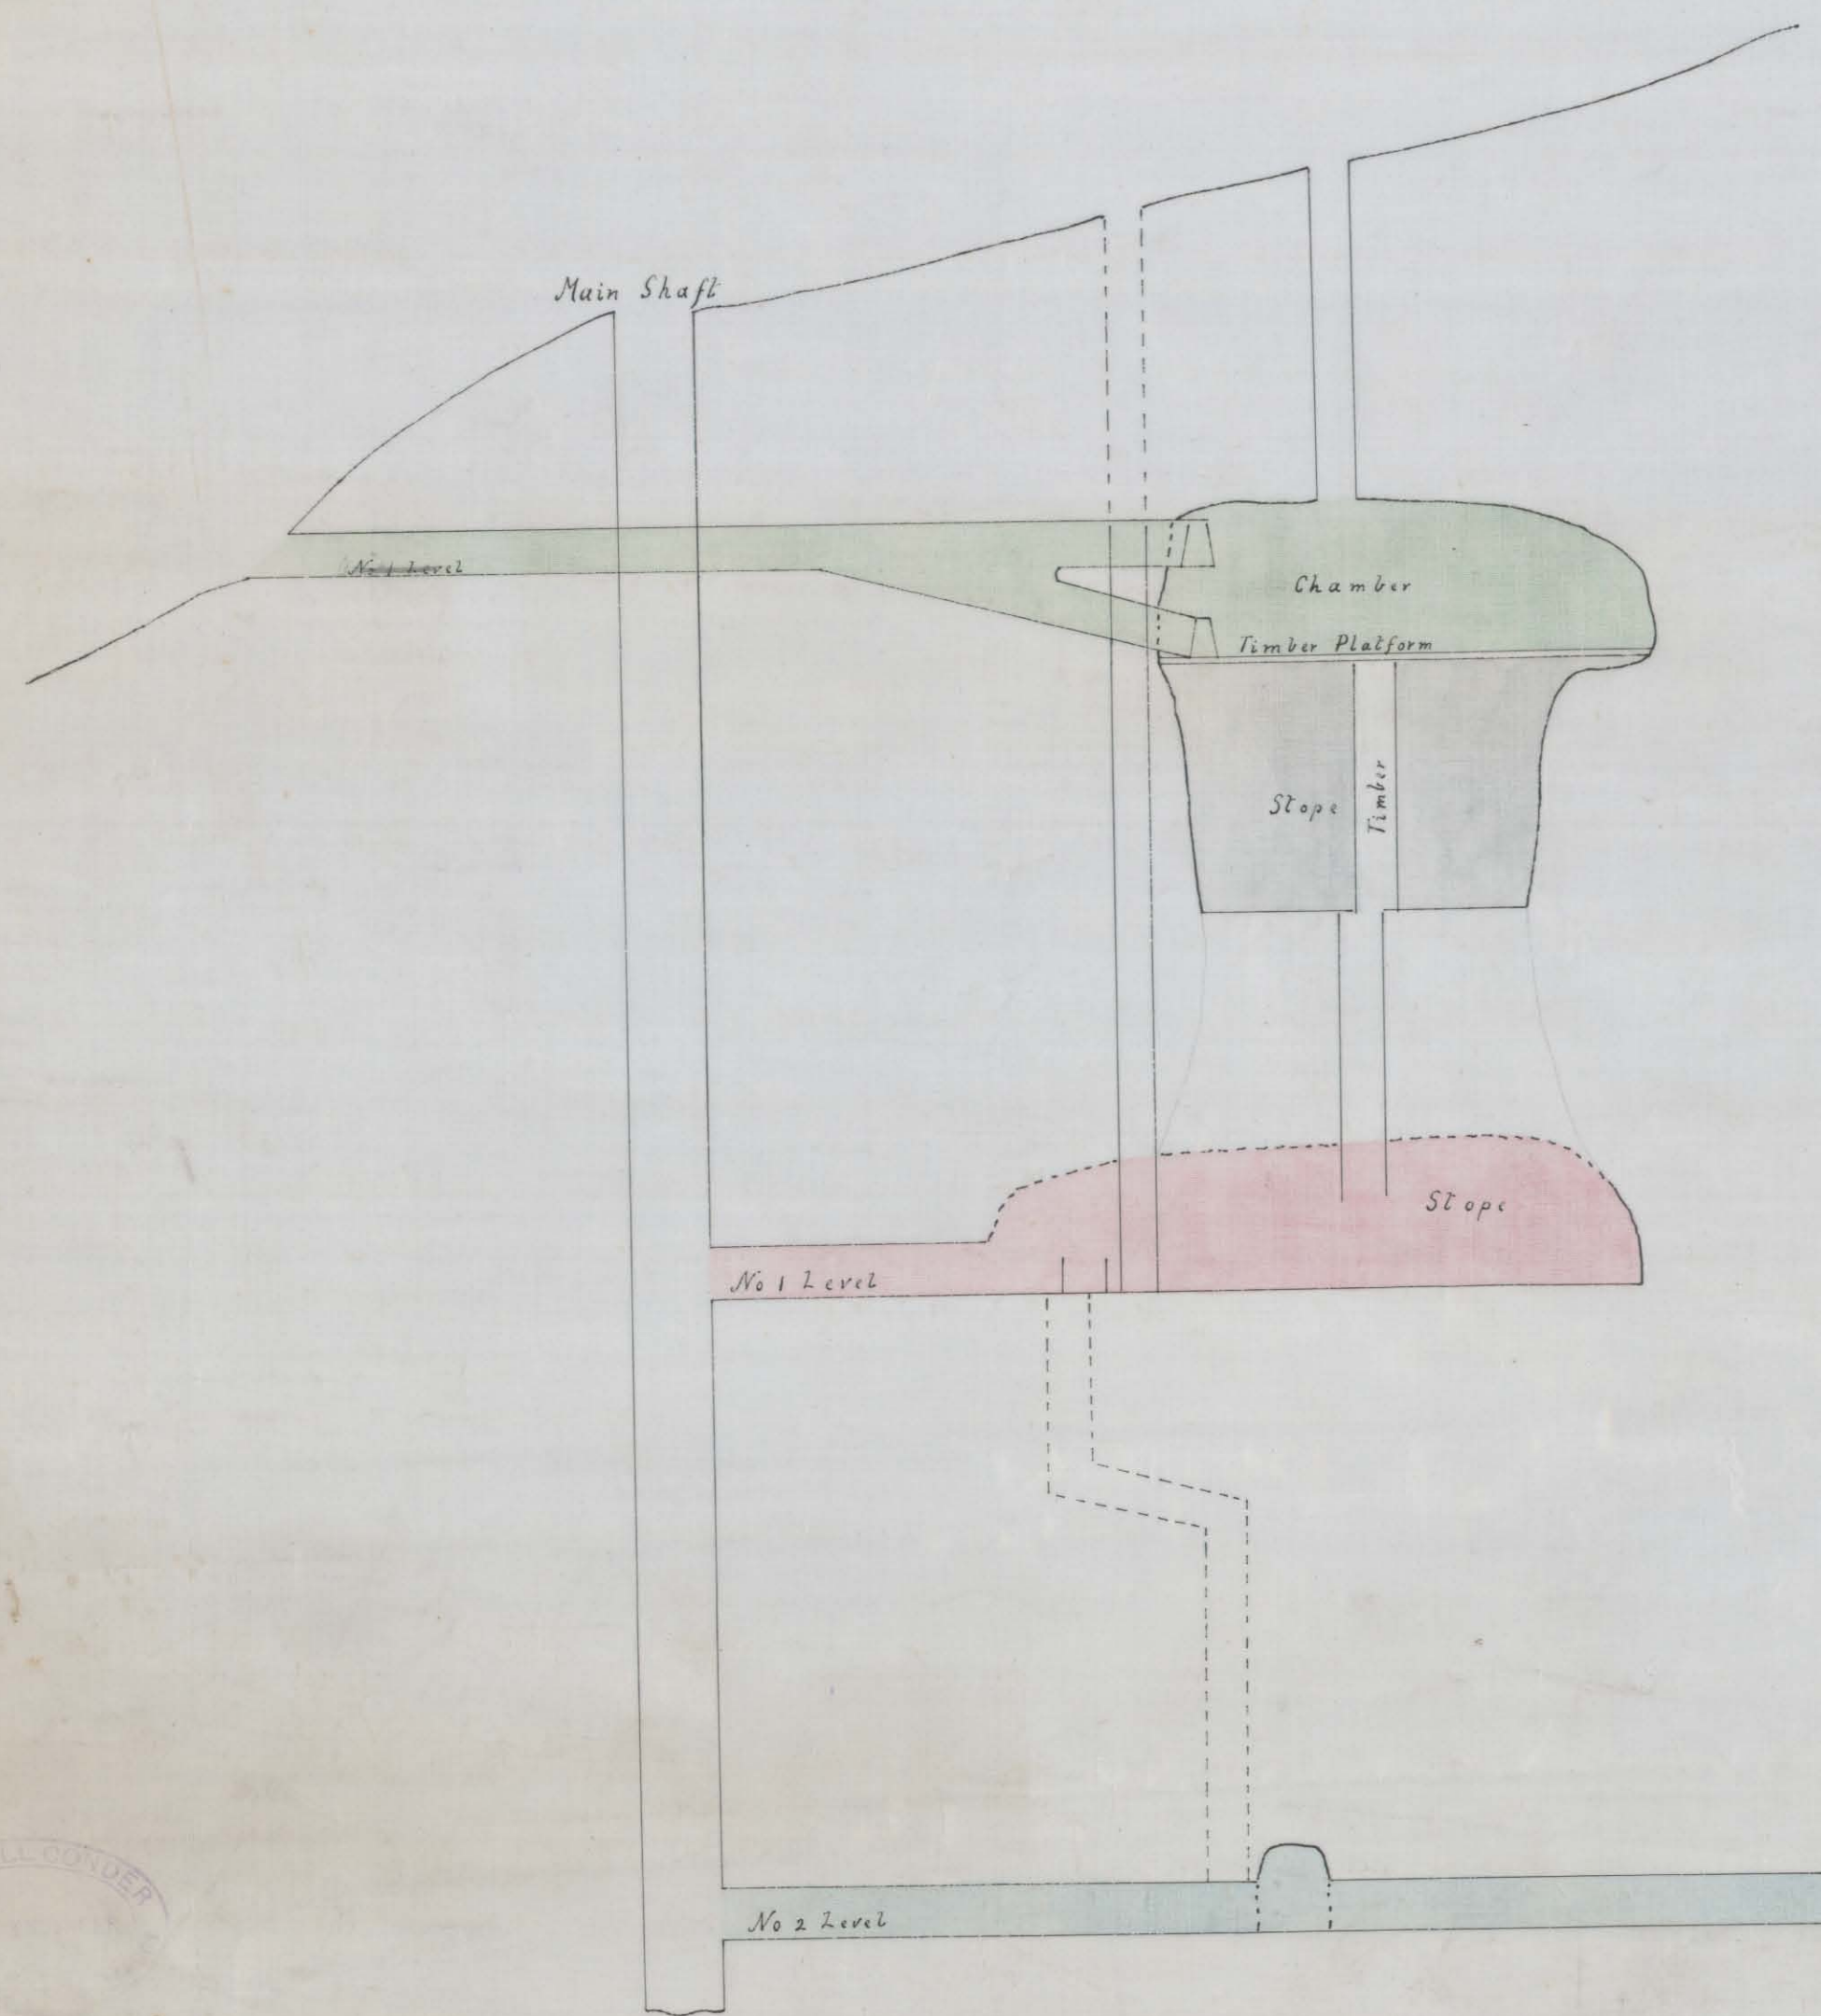

Hartwell Conder
Theodolite 4" Stanley No 10037
July 1903

