

122



Mt Rex Mine

Sections

Scale 1 in = 25 ft

S-N

W-E

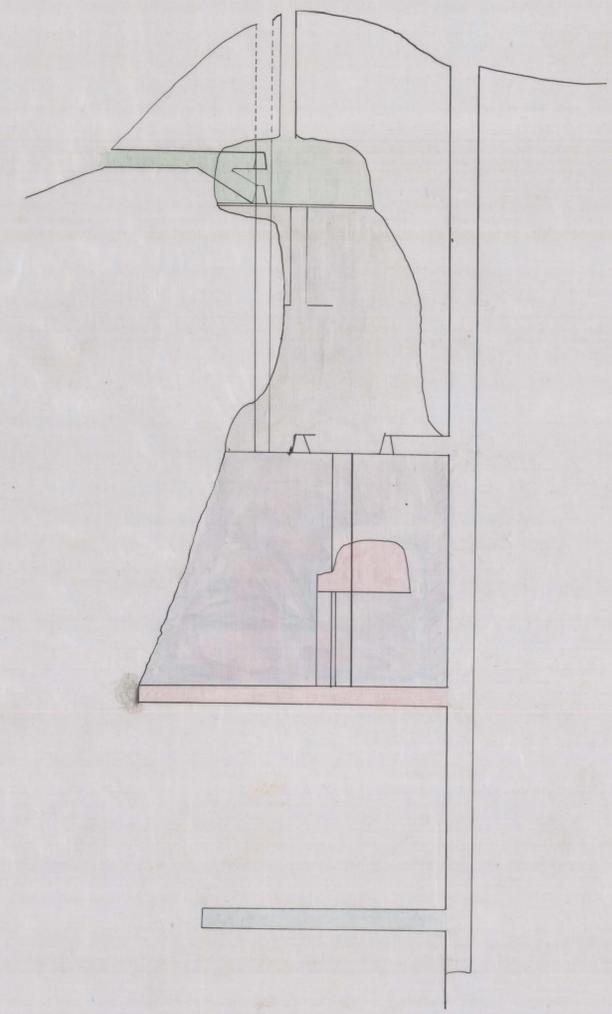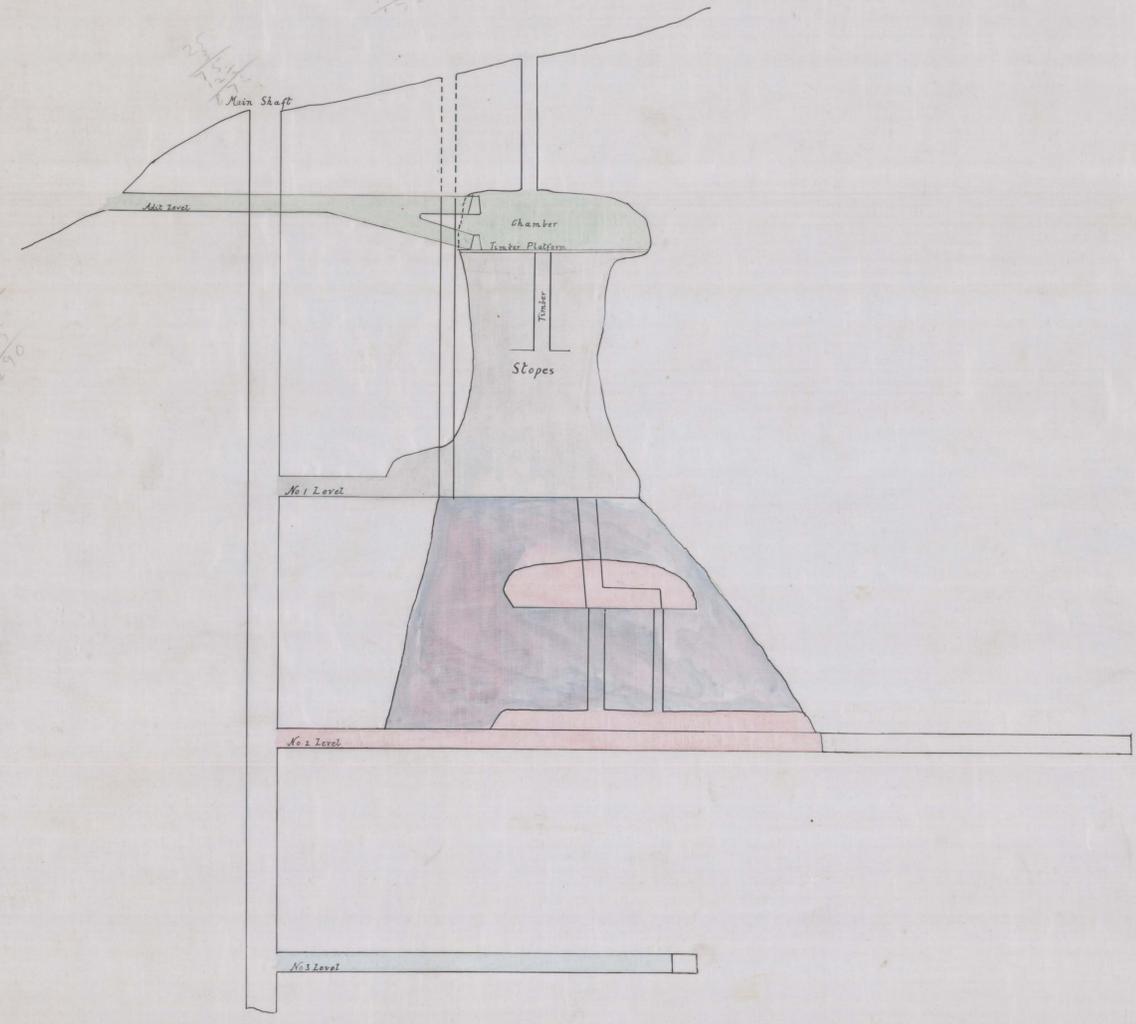

122
21
22
23
5m

280-10

280-10


 Hartwell Conder
 MA ARSM
 23 Feb 1904

122
21
22
23
70