
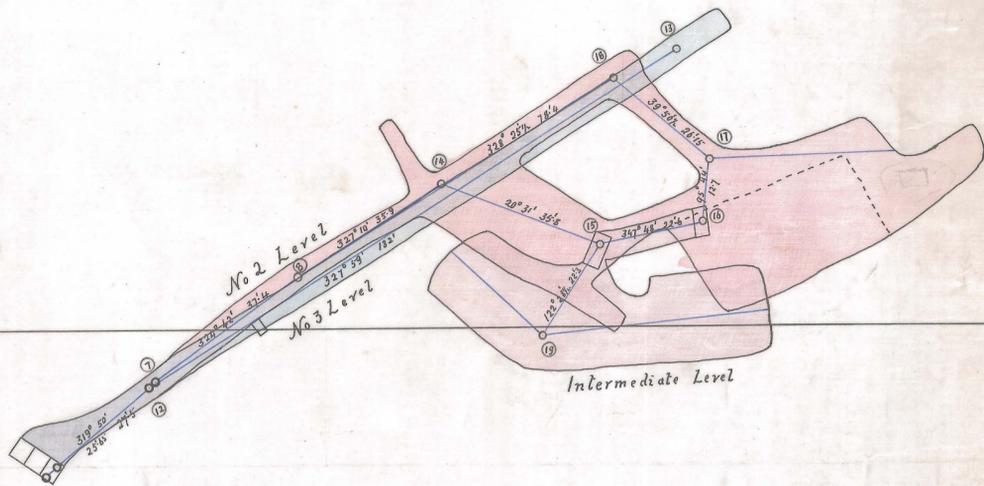


280-11

M^t Rex Mine

Plan

Scale 1 in = 25 ft

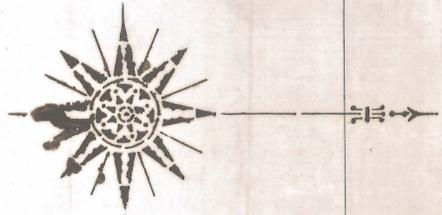

280-11

5 cm

INSPECTION
25 Feb 1904
CHAUNCEY

Hartwell Conder
M.A. ARSM
23 Feb. 1904