

281-01

M. J. Attemall

600 Ac.  
A. Nicholas Pur.  
Right of Way  
Wire fence  
315° 30'

Lot 280  
Z. Williams Pur.

50 Links wide

COUNTY OF DEVON  
PARISH OF SPREYTON  
SCALE - 20 FEET TO AN INCH  
Underground Workings  
Ilfracombe Colliery  
S. H. H. H. H.  
Surveyor  
West Devonport


owner

Lot 328  
500  
D A V I D S O N

Right of Way  
Wire Fence  
50 Links Wide

W. B. Dean  
Pur.  
29th April  
Surveyed

Surveyed  
1st August  
1891

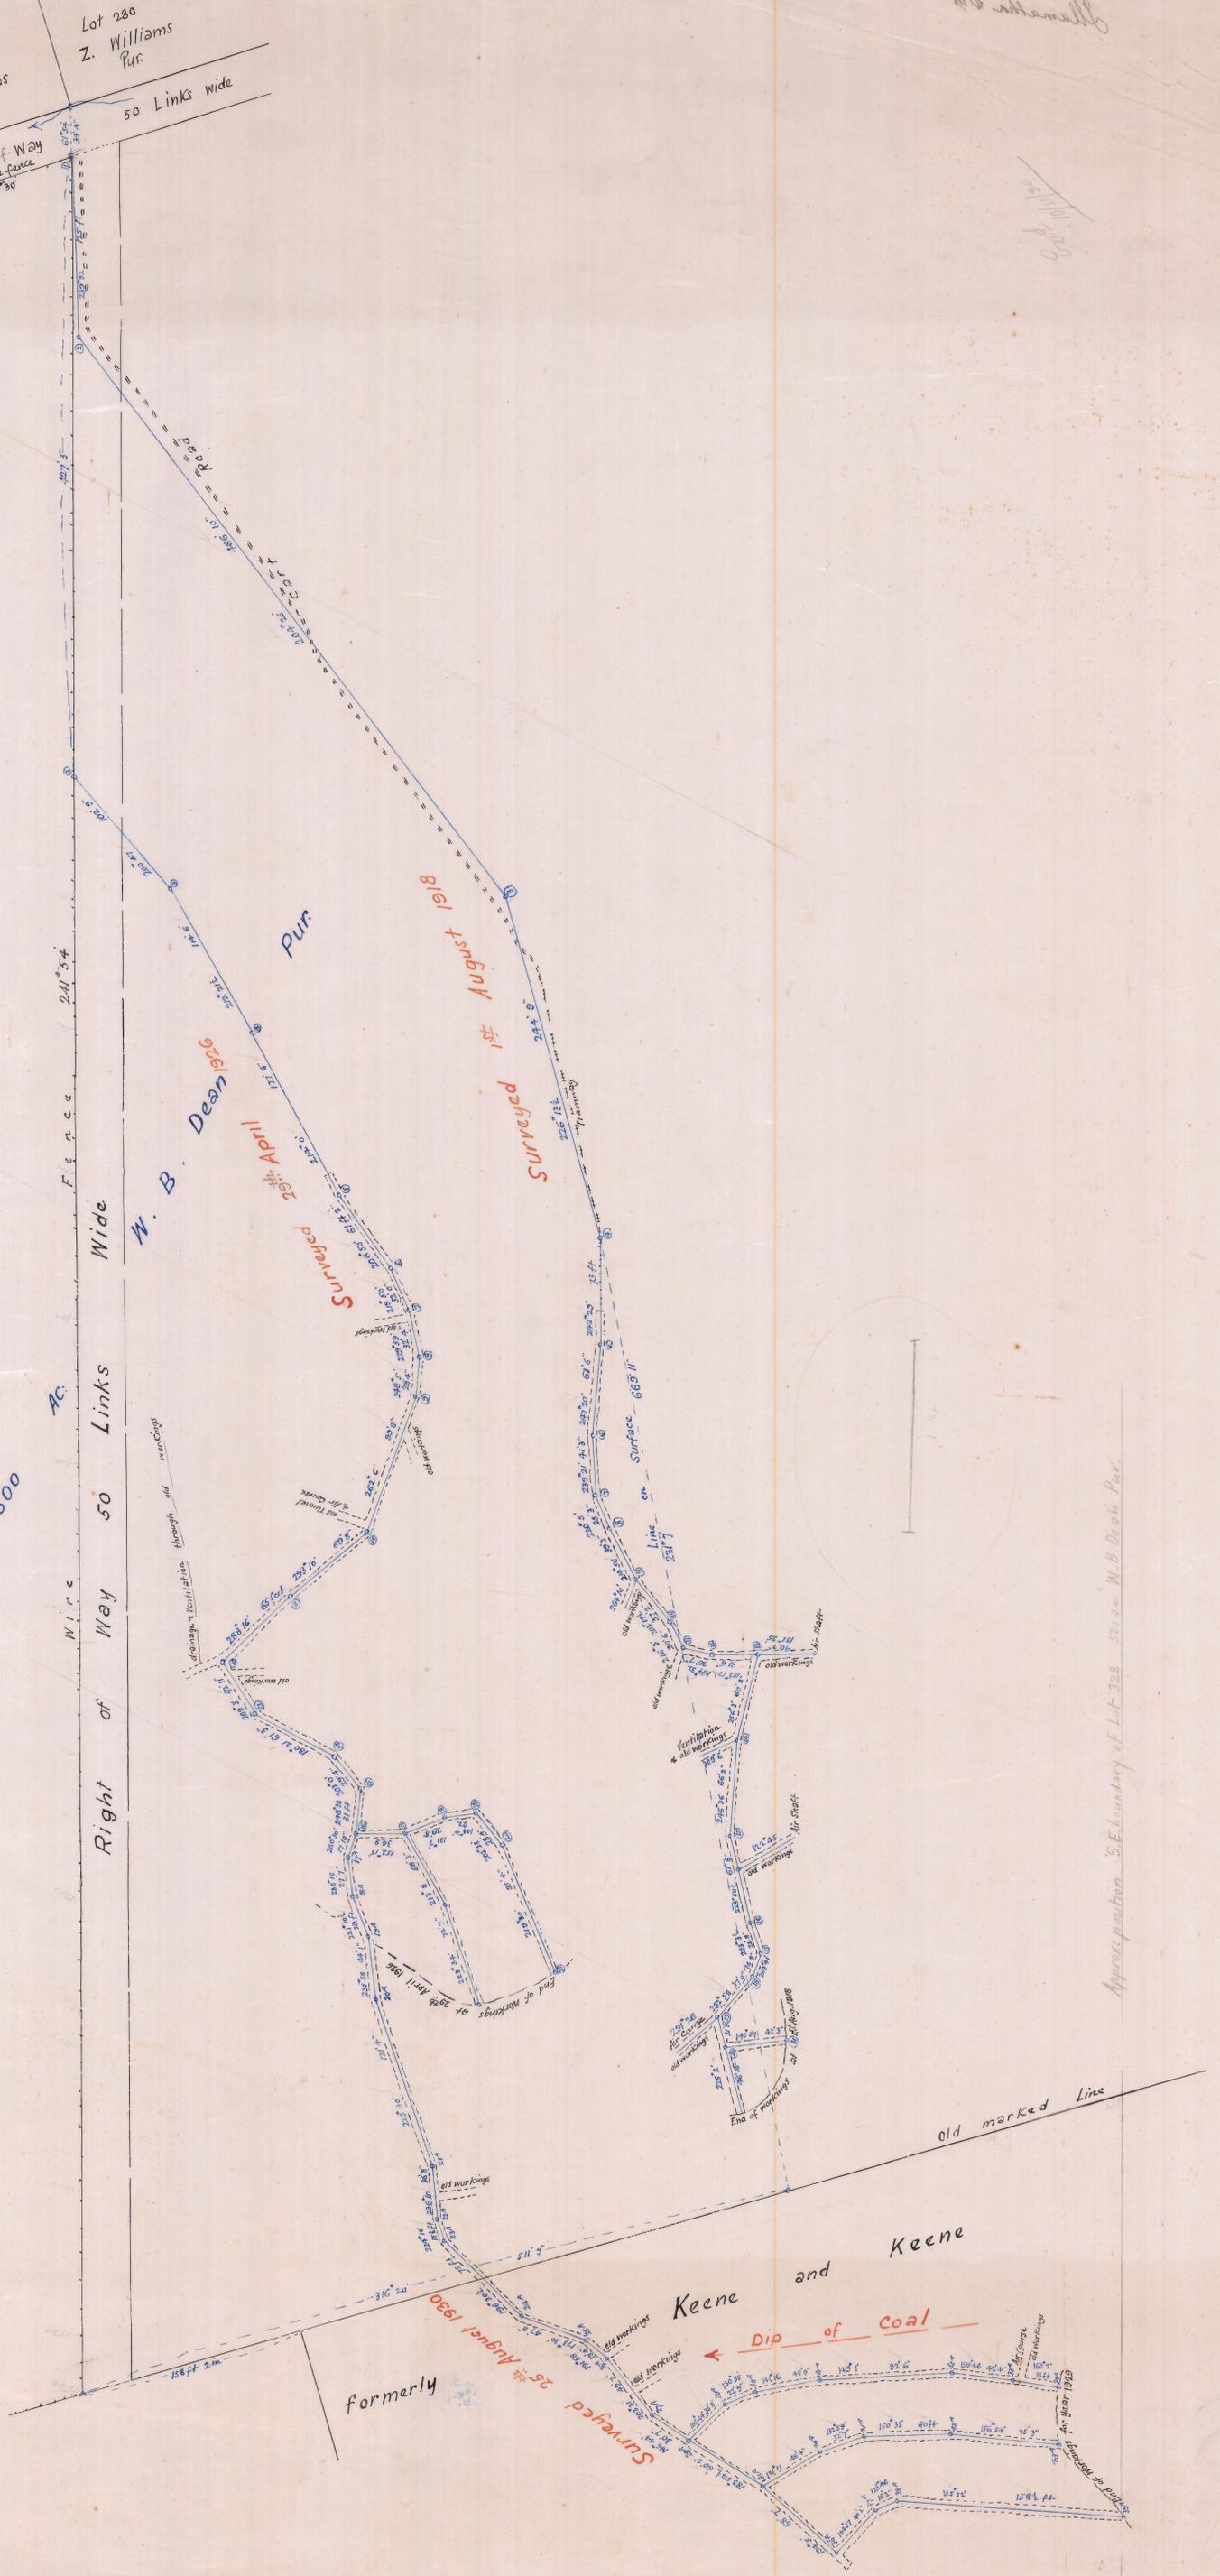

Approximate S.E. boundary of Lot 328 since W.B. Dean Pur.

Old marked Line

Keene and Keene  
Dip of Coal

formerly

Surveyed 25th August 1898

Surveyed 26th April 1895

M. J. Attemall

05/11/1898