



PLAN OF W BAYNTON'S COAL MINE AT JERUSALEM

Scale 25 feet to an inch

21st May 1895
LONDON

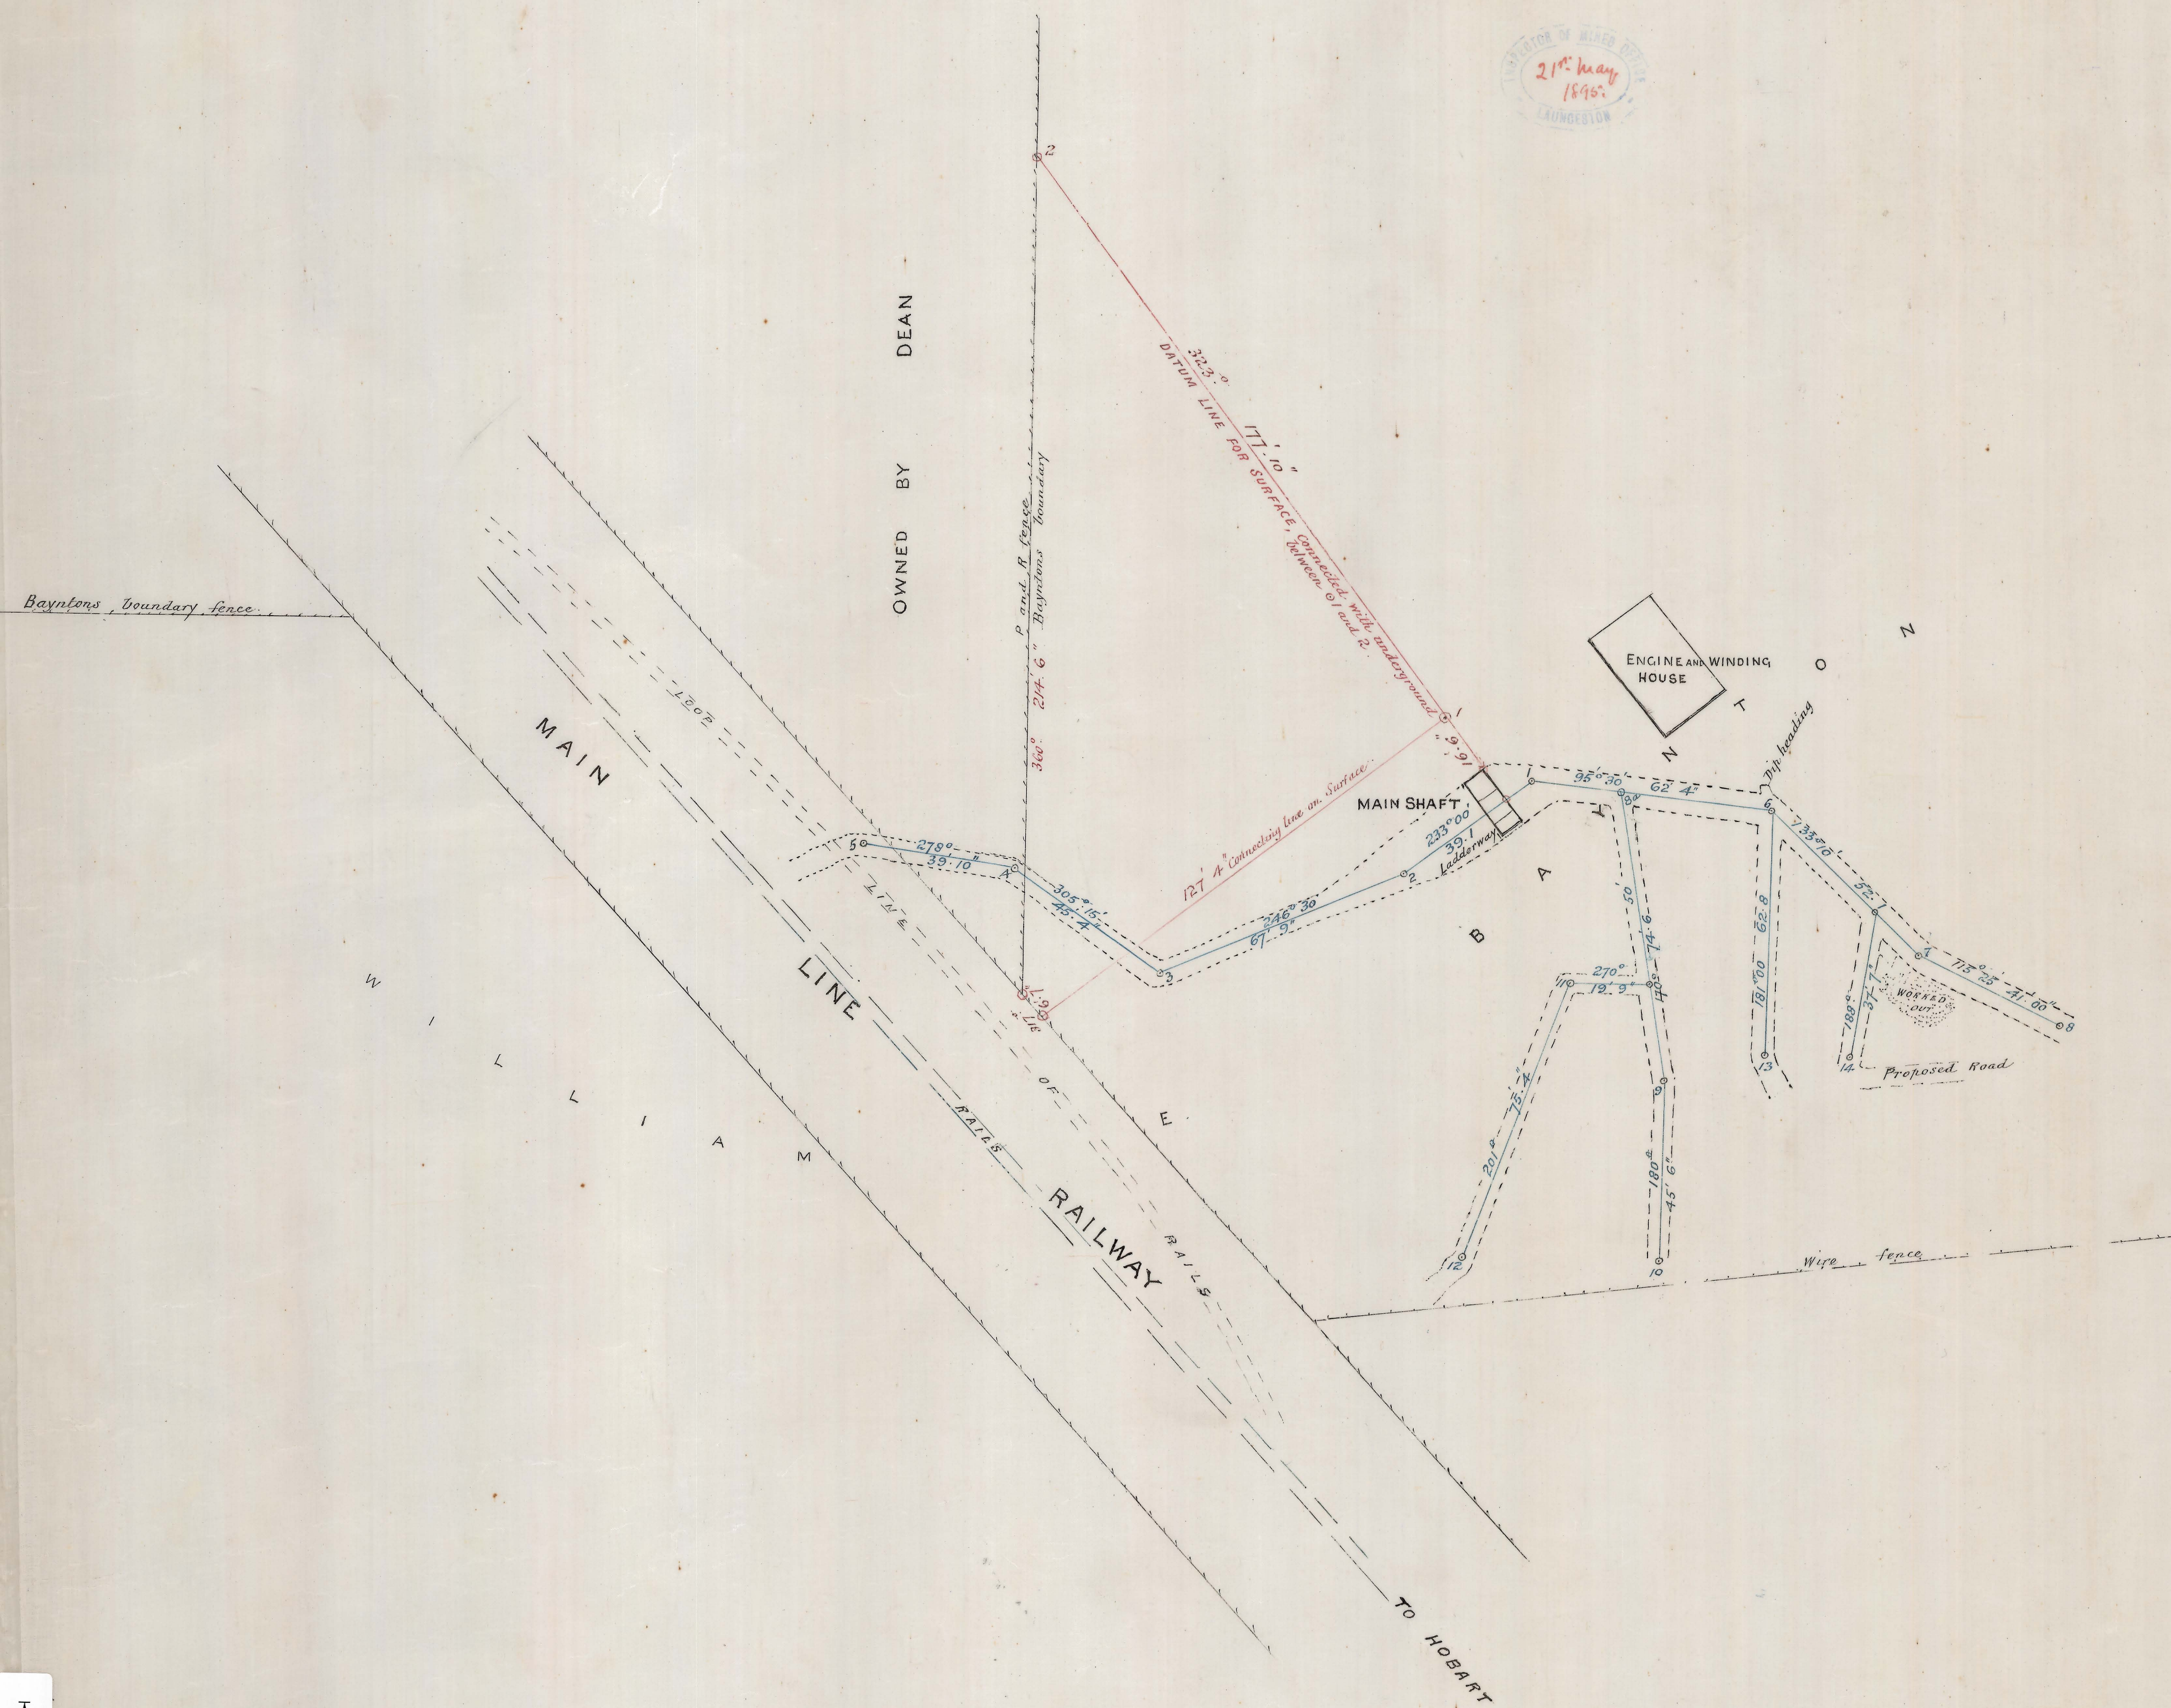

TRANSVERSE SECTION LOOKING NORTH

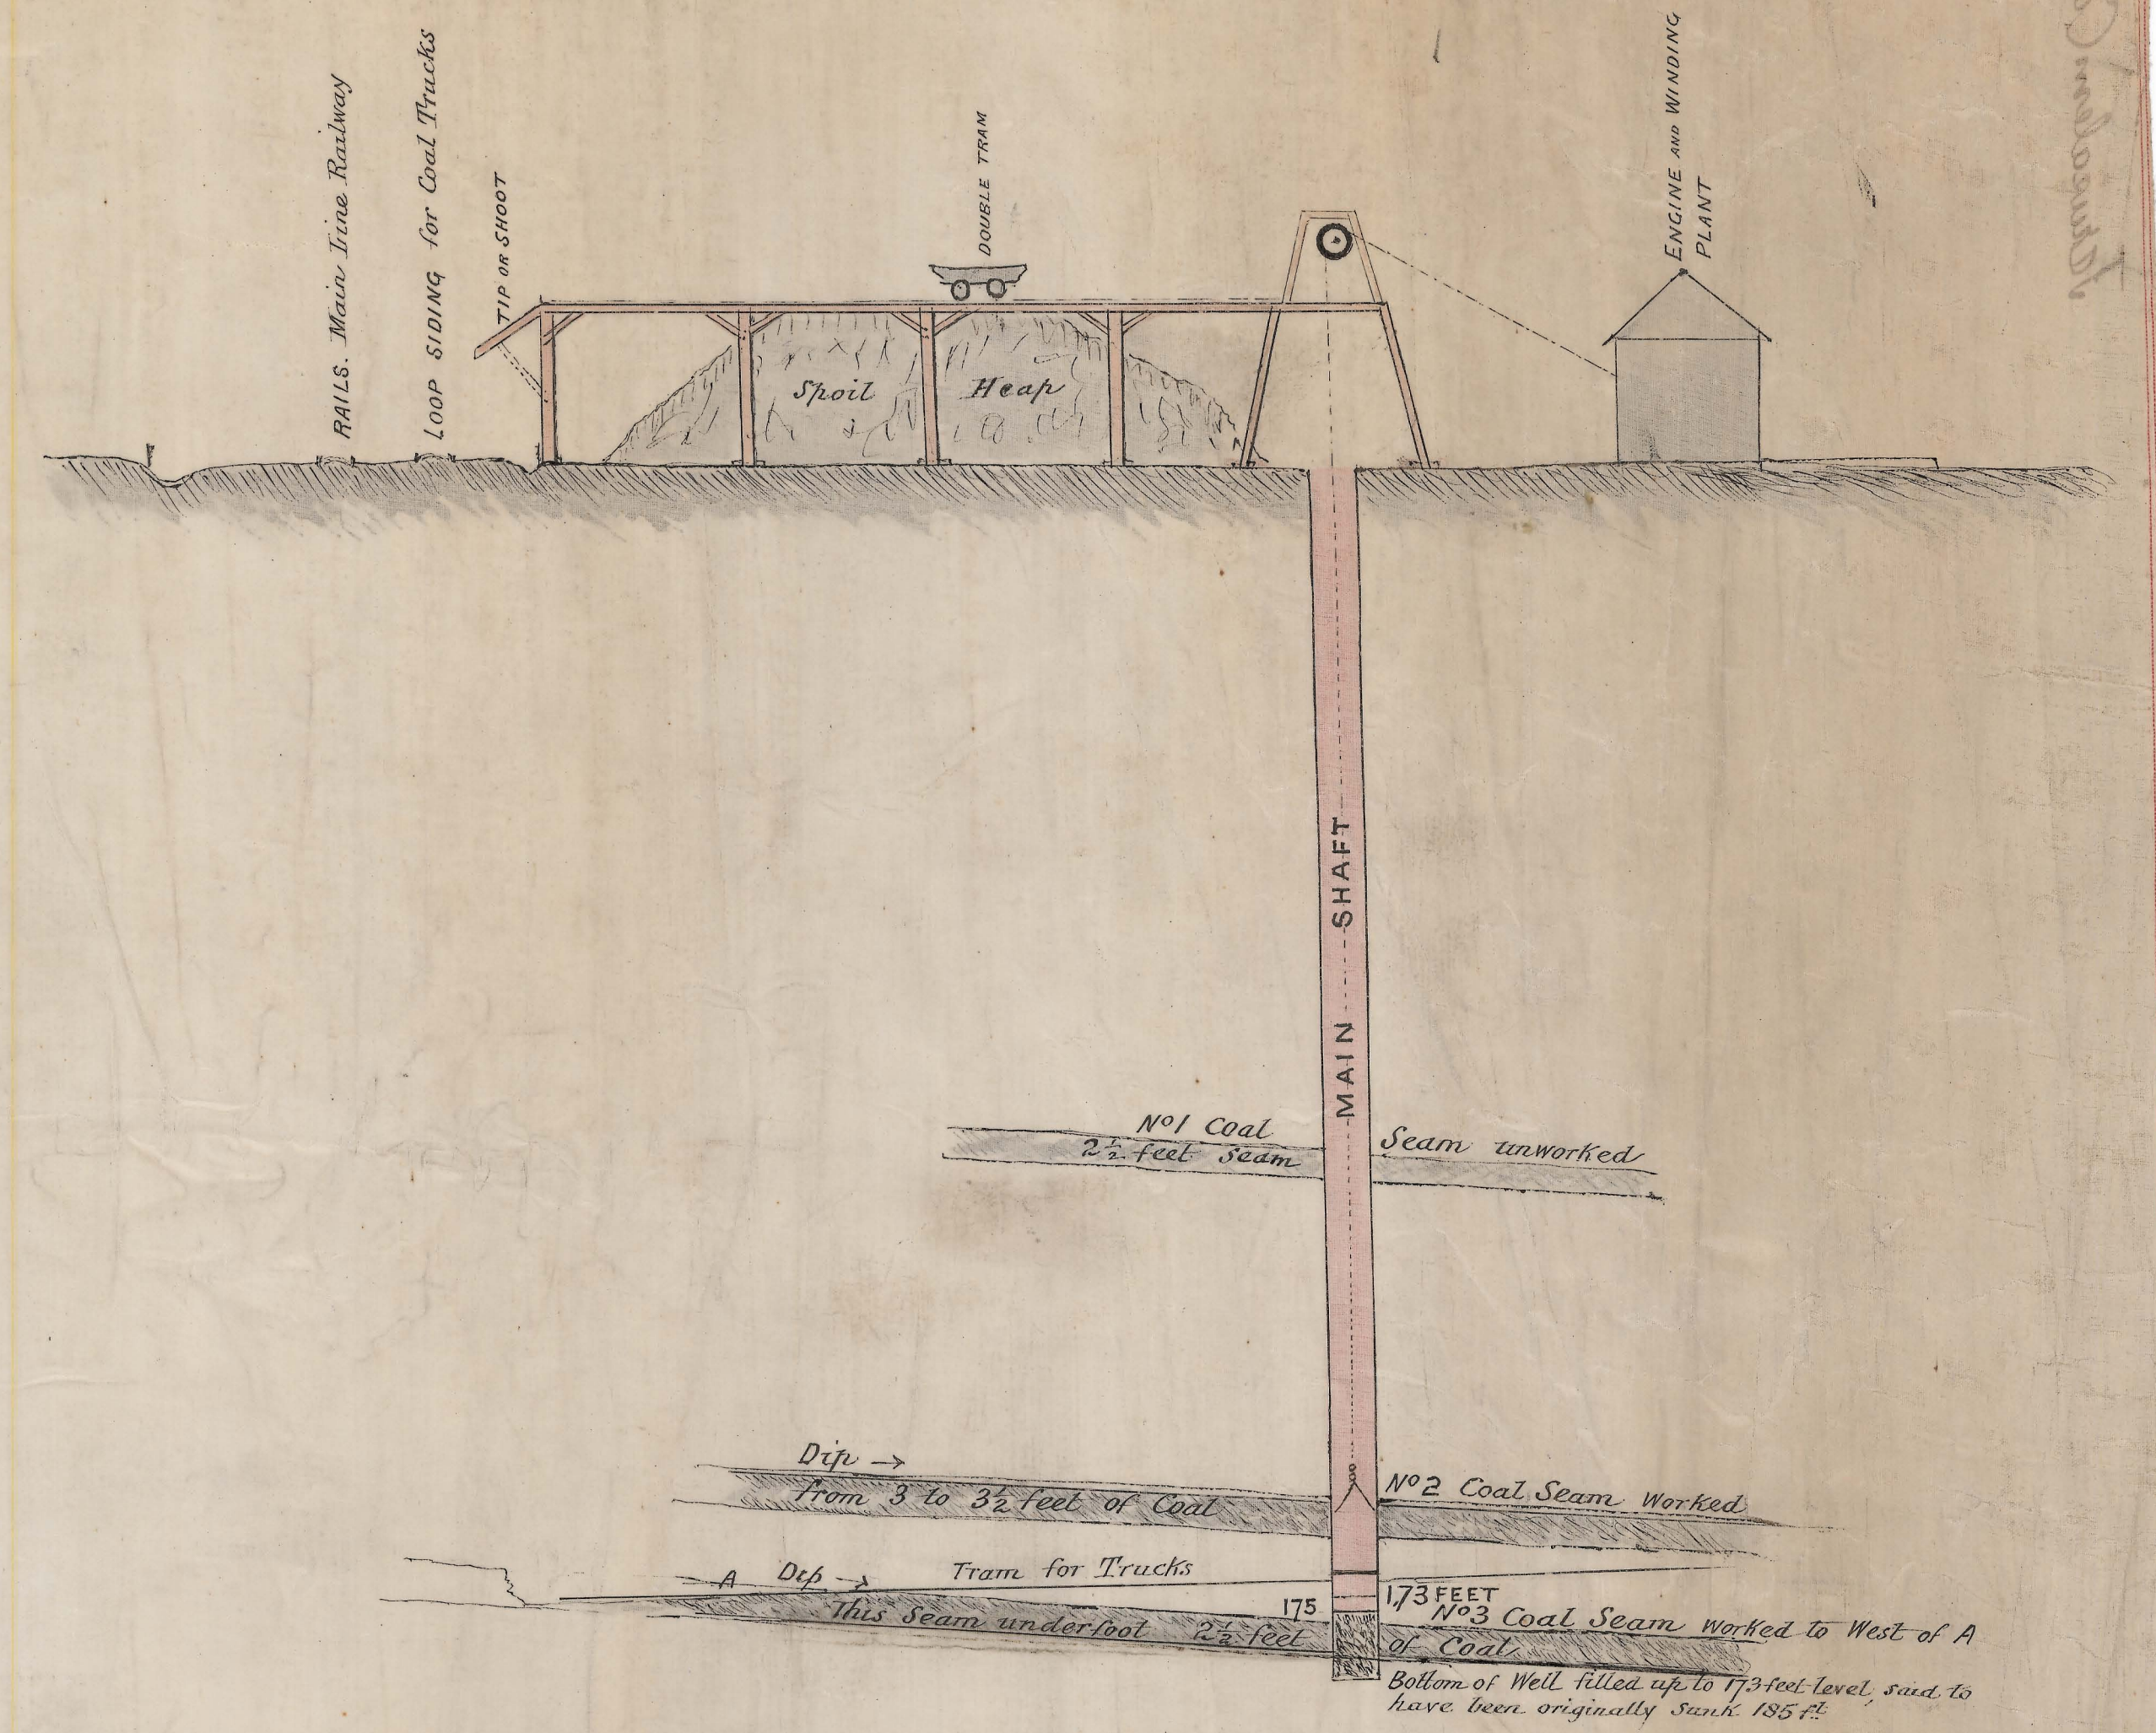

Reference. Black lines denote Existing fences &c. on the Surface, thus
Blue, Traverse lines, of Underground Drives &c.

Drawn by George J. Smith
Authenticated Surveyor
April 1895