
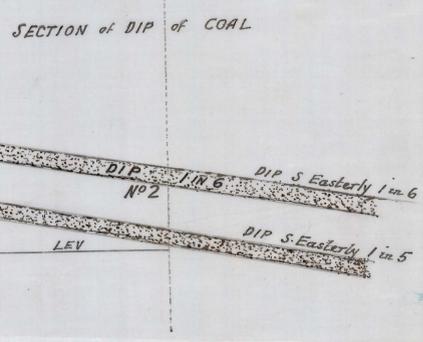


# MARIALVA COAL MINING CO. N.L. NEAR COLEBROOK.

SECTION  
HOR SCALE 2 chs to an inch  
VER. do 20 feet to an inch

PLAN  
Scale 2 chs to an inch

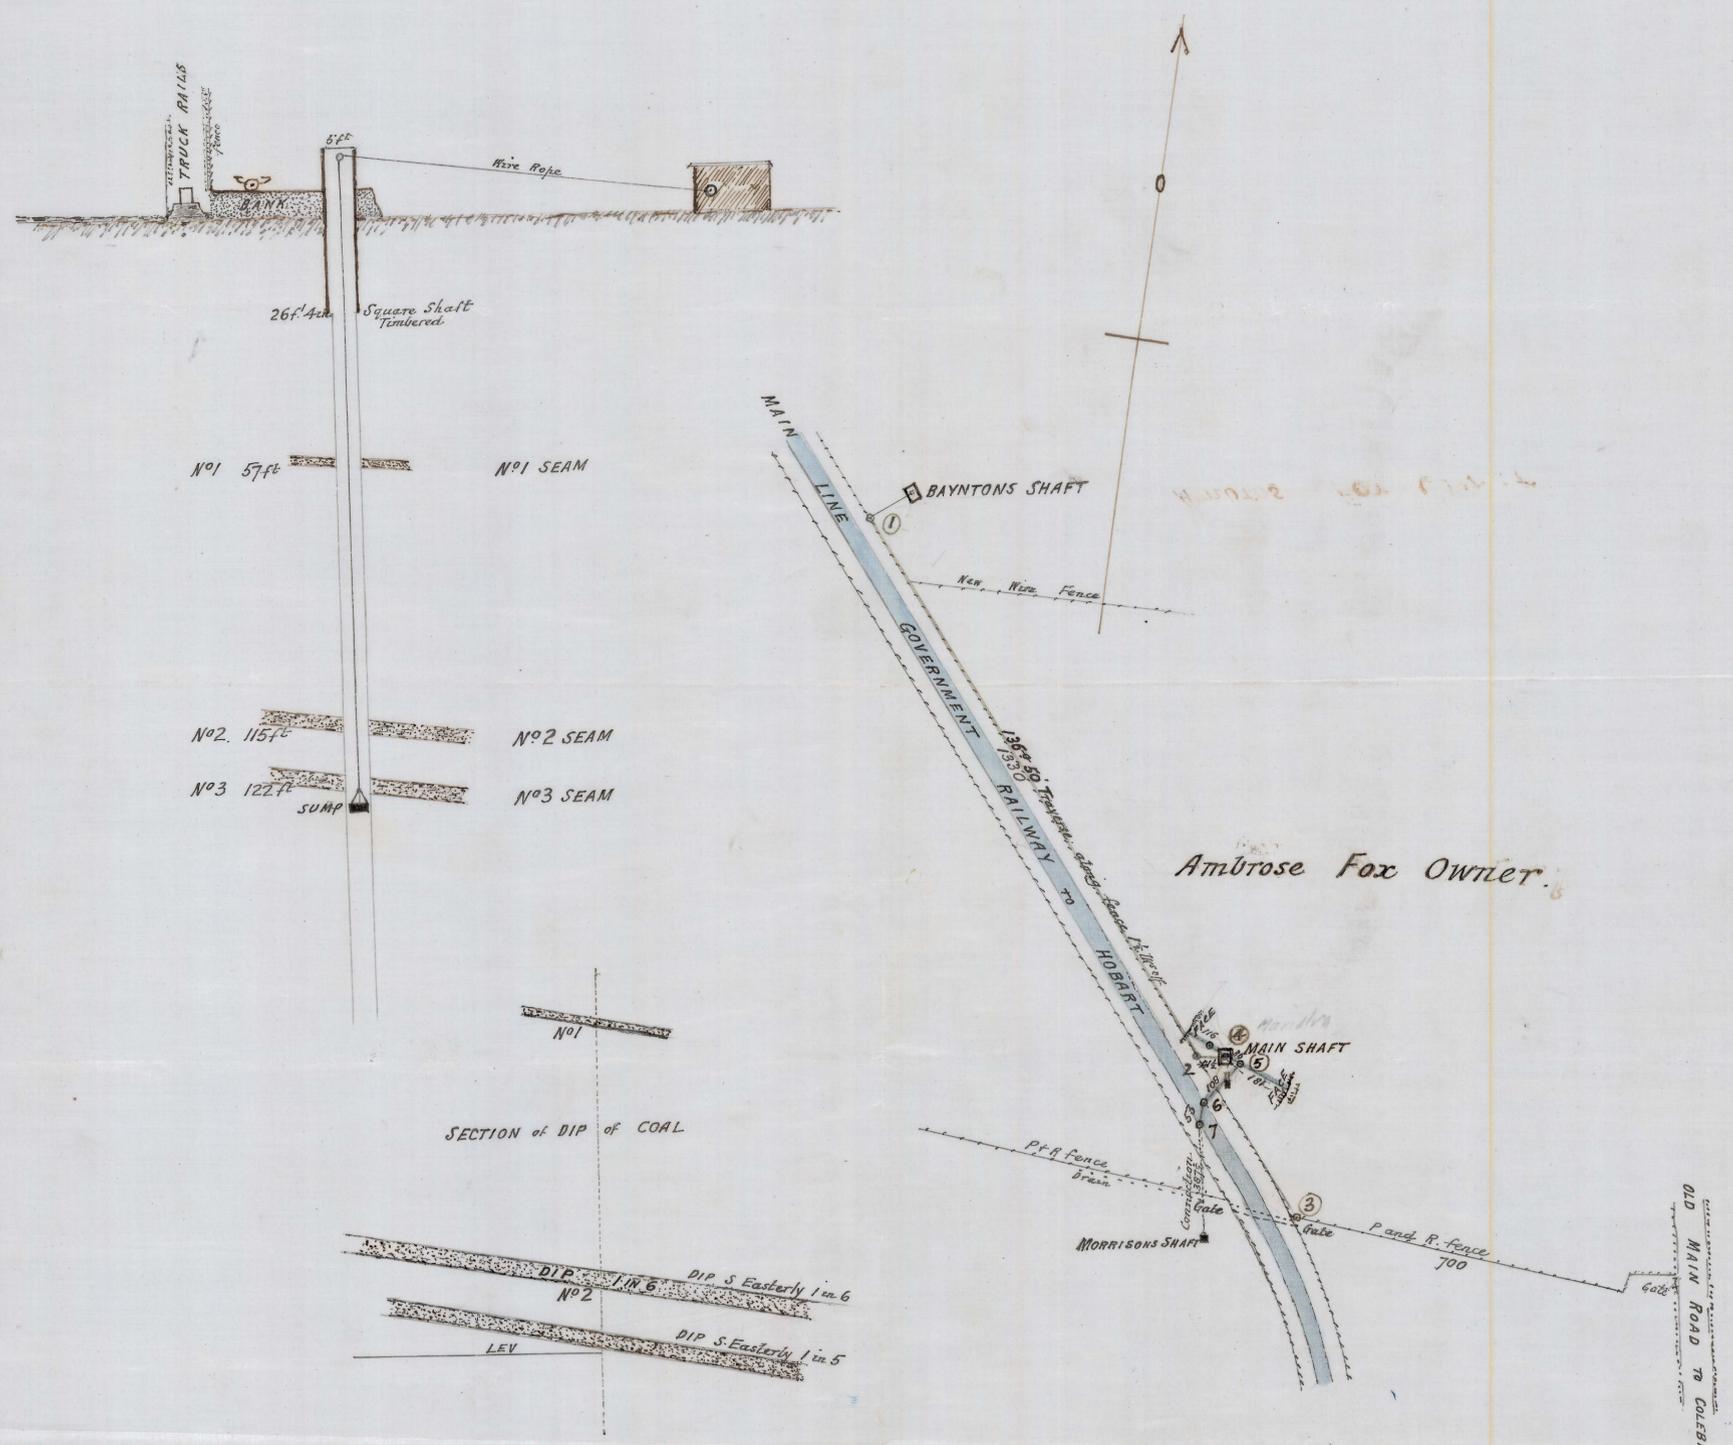

5 in Theodolite and PRIS COMPASS to  
Steel Band Chain

*George J. Lenth*  
Professional Surveyor  
April 1904

