


PLAN OF W. BAYNTON'S COAL MINE
AT JERUSALEM.


Scale. '25 feet to an inch.

REGISTERED
27th April
1896
LAURENCE

TRANSVERSE SECTION LOOKING NORTH

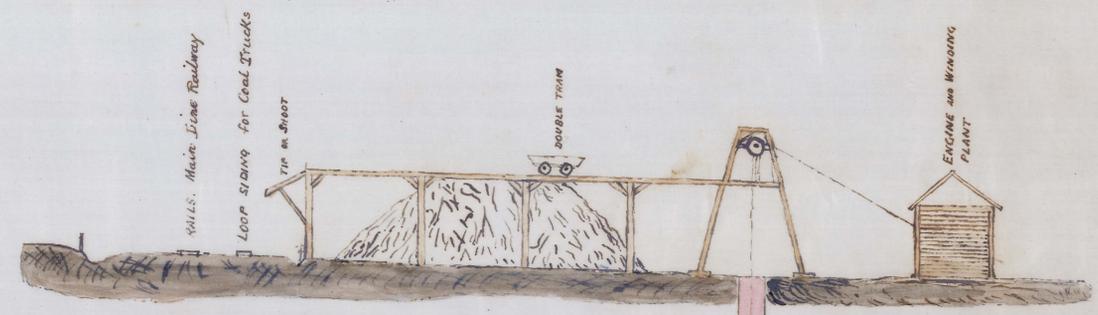

50m

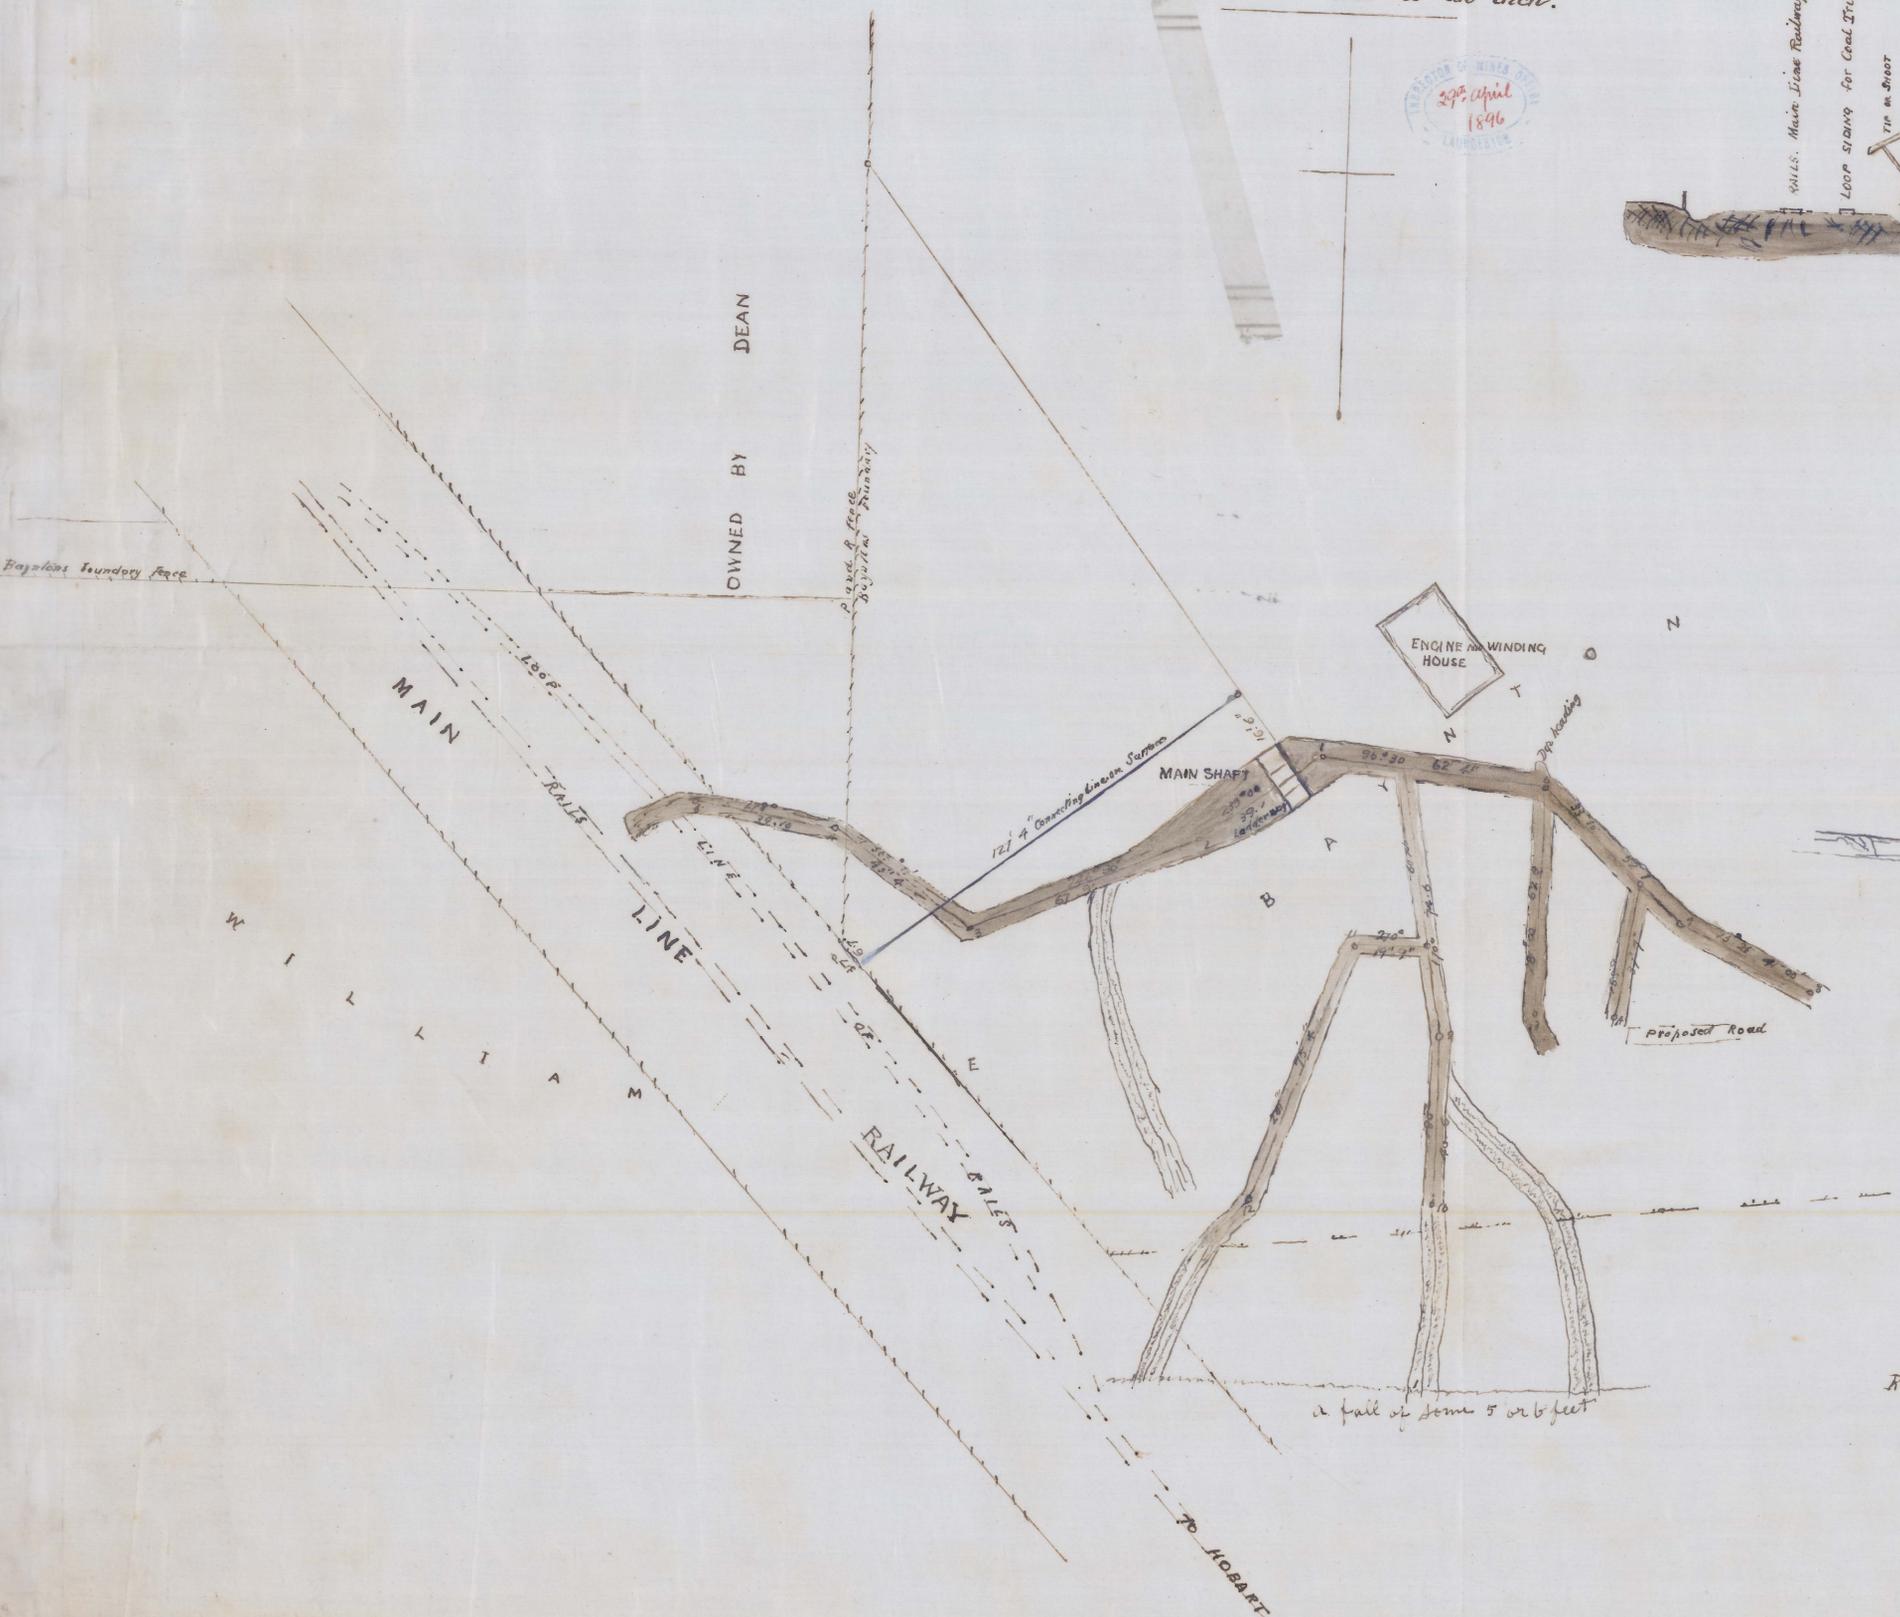

Reference. Black lines denote Existing fences on the surface, blue lines, underground workings.

282-50