



RING VALLEY M. CO. L^{IM}

SECTION


Scale 1 in = 25 ft.

REFERENCE


ON SURFACE	UNDERGROUND
1 Entrance to Main Adit Lev.	1 Main Adit Level
2 Drive on lode from River	2 Drive on lode
3 Prospecting Shaft	3 Winze from Main Adit
4 Main Shaft	4 End of Main Adit
5 Entrance to Low Lev. Tunnel	5 Drive South
6 Xcut East	6 Xcut East
7 Prospecting Tunnel	7 Drive North
8 High Lev Tunnel	8 Xcut West
9, 10, 11 Trenches	9 Winze in Low Lev. Tunnel
	10 Xcut West
	11 Xcut West
	12 Drive North from (11)
	13 Xcut East
	14 Xcut West from end of Tunnel
	15 Drive South No. 1
	16 " " " 2

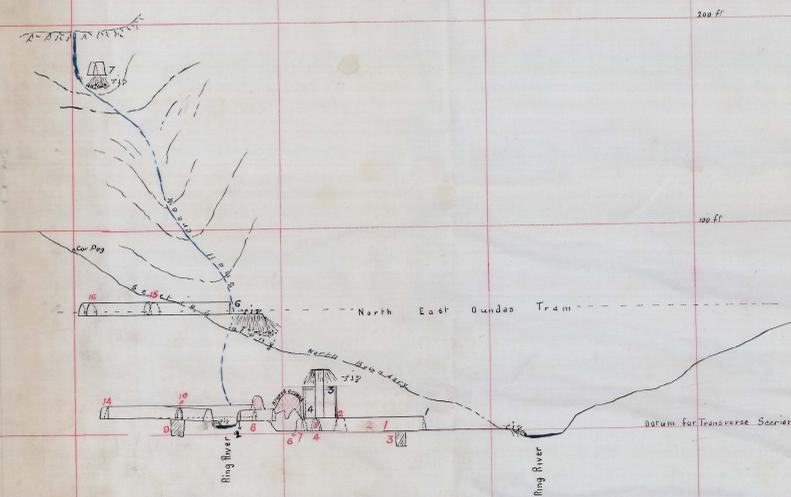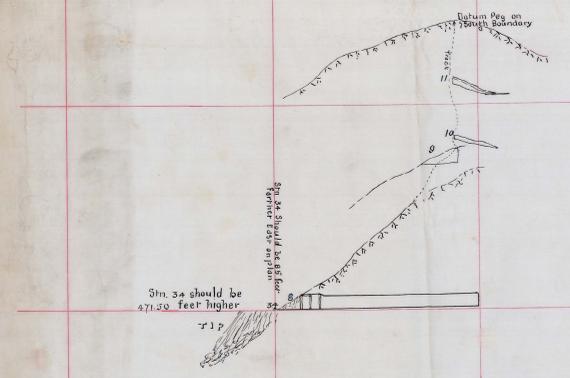

TRANSVERSE
Looking South

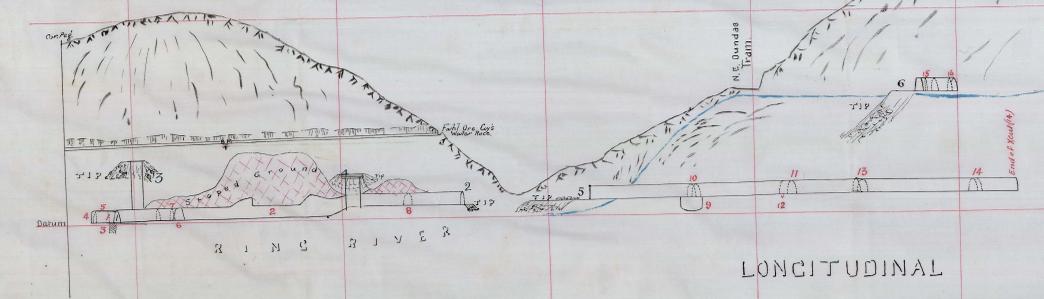

LONGITUDINAL
Looking East

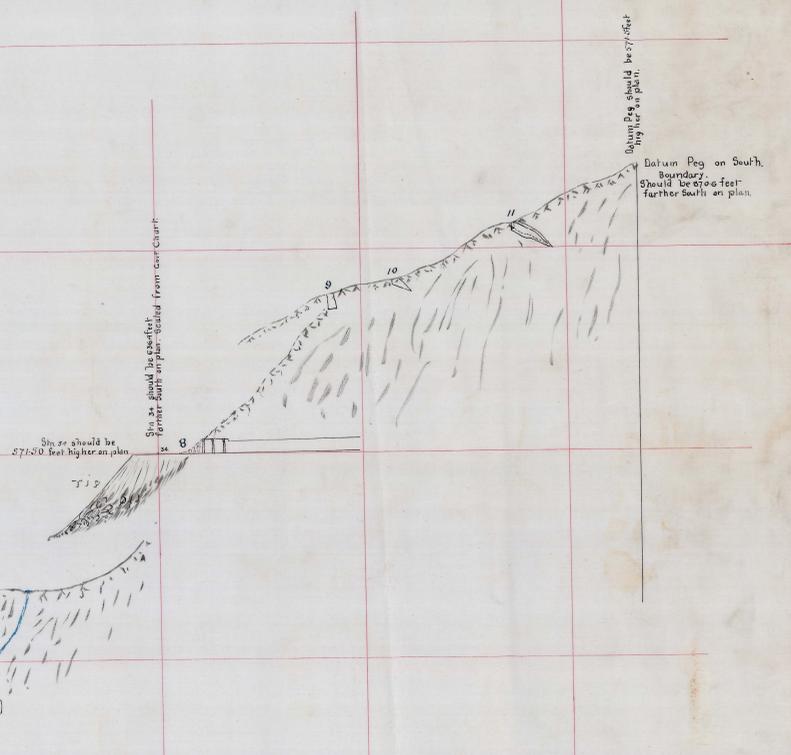

Luke Williams
Capt. M. M.
Dec 31st 1900

