


5 cm



1400
91 M 67 AC.

Ring Valley Mining Co.
Scale 25 Feet = One Inch

John Mayhew
Mining Manager
Dec 31 1901
W.R. Sale
March 26th 1902

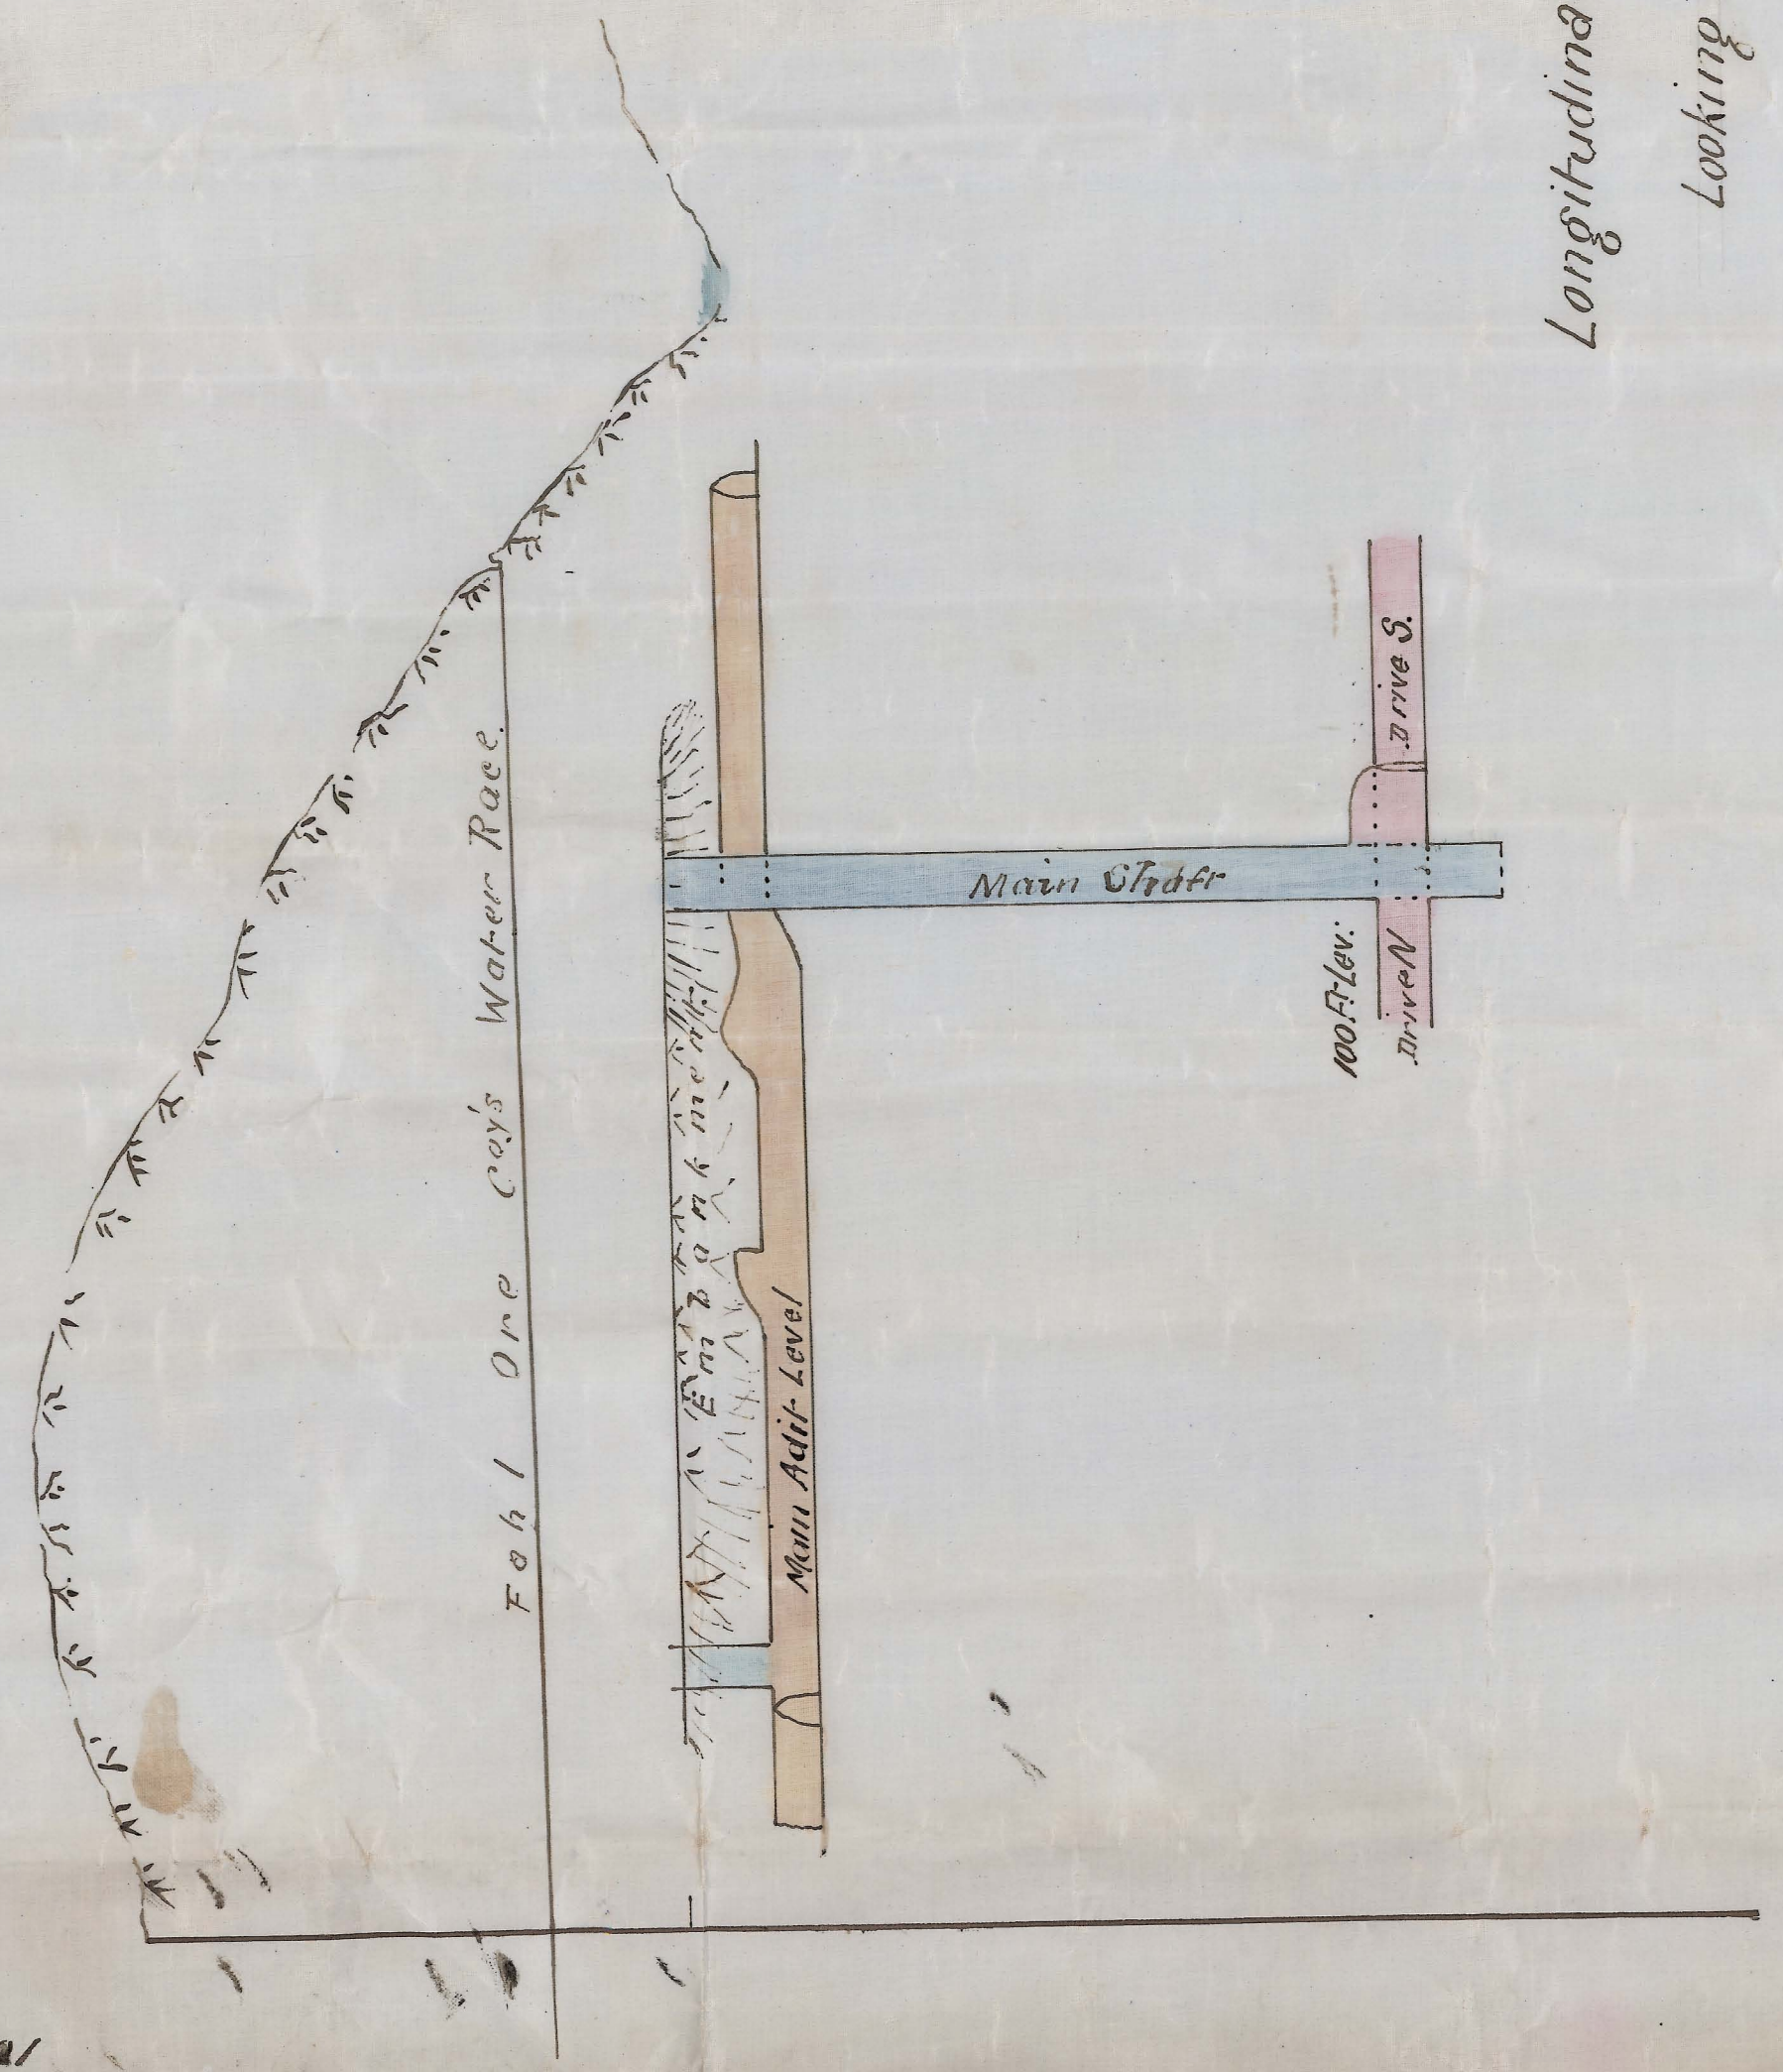

Longitudinal Section.
Looking East.