


RING VALLEY MINING COMPANY
LIMITED

Section on Line A-B on Plan.

Scale = 25 Feet to 1 Inch



John Meyer
Mine Manager
Dec 21, 1902

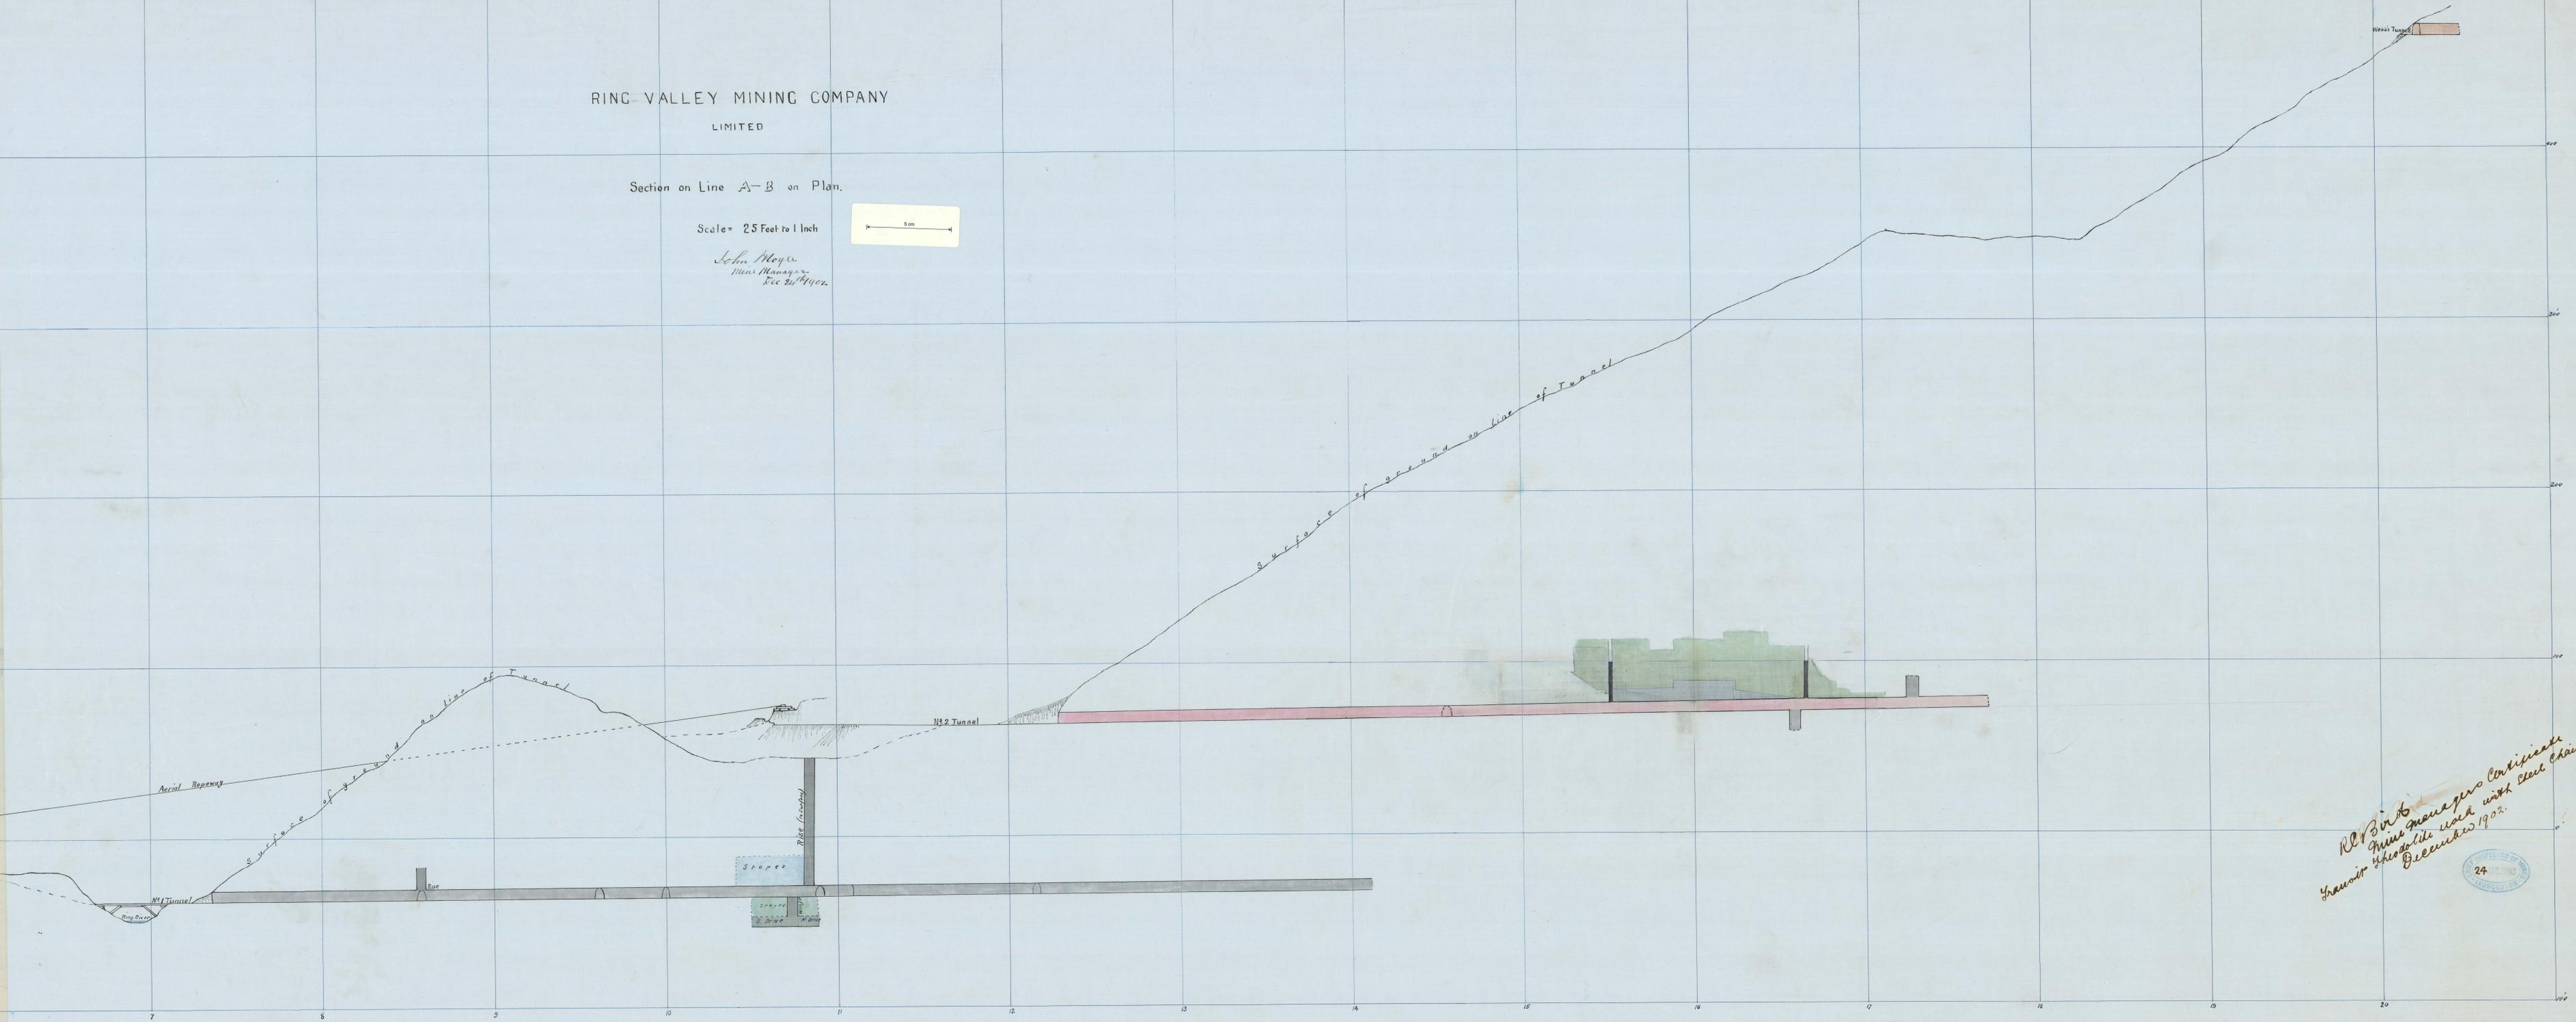

R. B. Smith
Mine Manager Certificate
Issued this 24th day of December 1902.

