


RING VALLEY M.C. LTD.

Plan of Workings, etc:

Scale

1 inch to 25 ft.

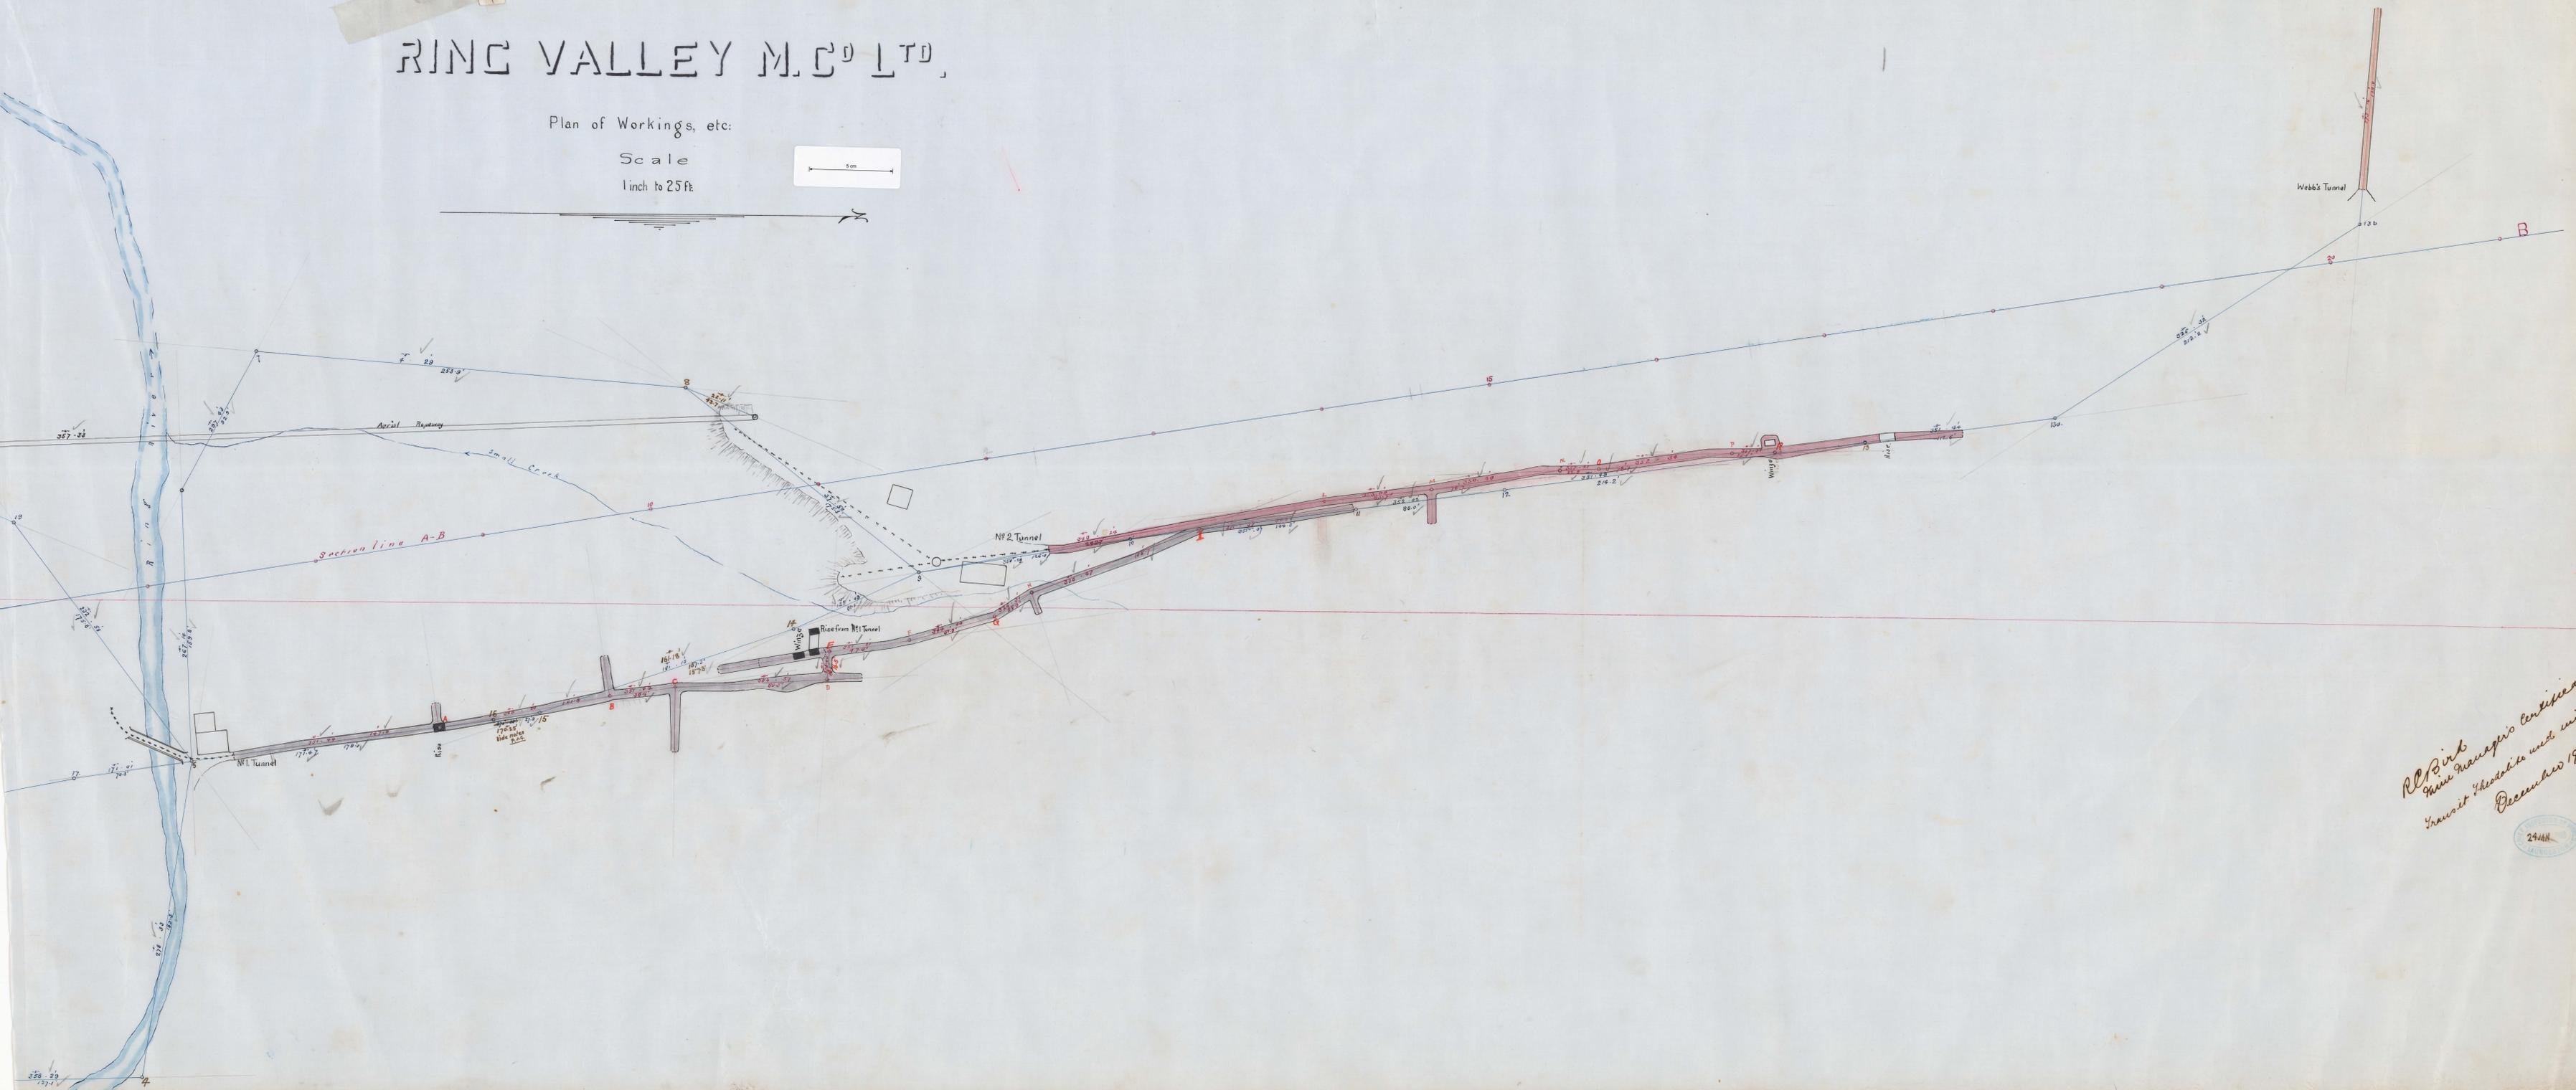

*RLP:rk
Hume Manager's Certificate
Grant of Privilege with Steel Chain
December 1902*

