



Ring Valley Mine
Underground Workings 1908-1909
Scale 25 feet to an inch

Note New work colored green

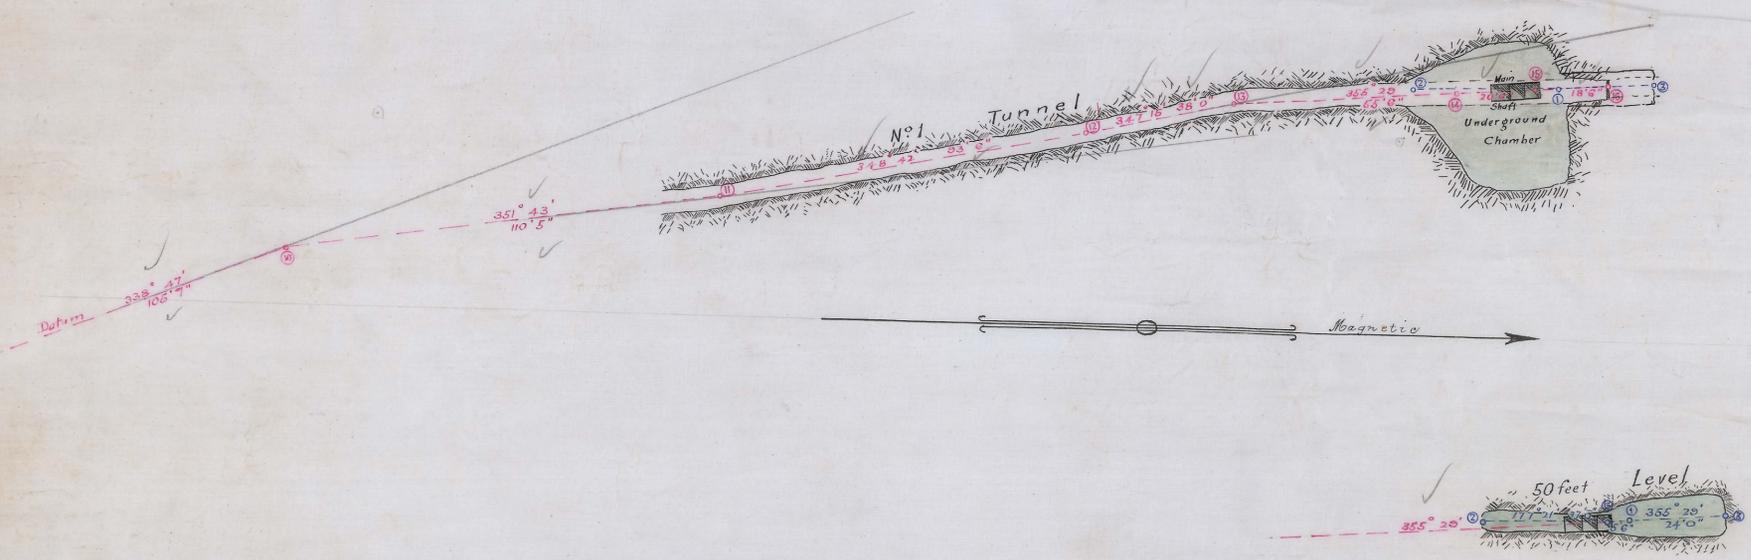

Plan

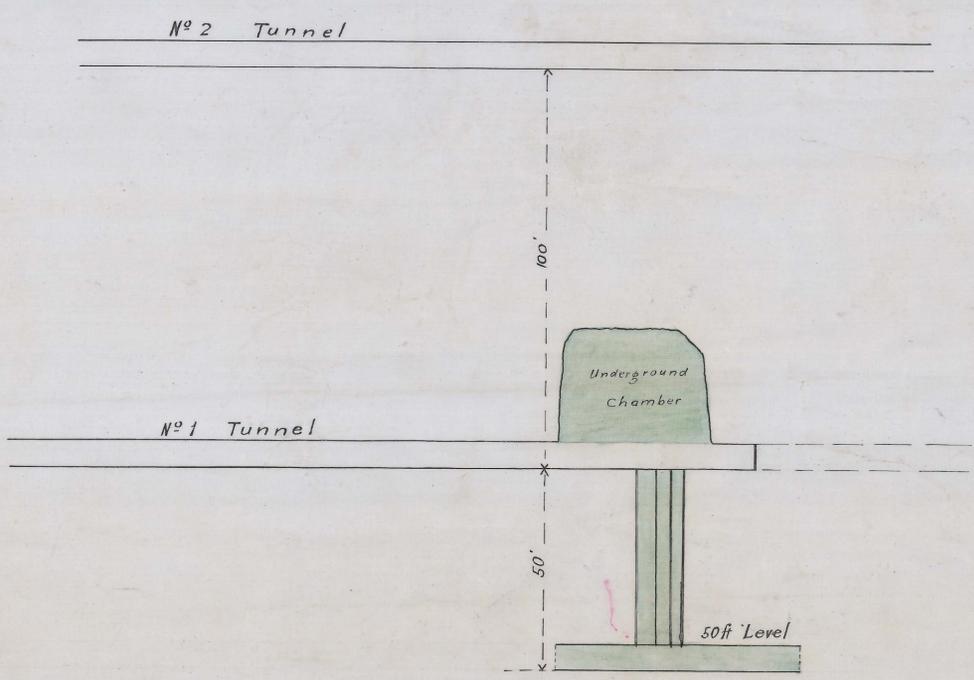

Longitudinal Section

Godfrey Knapp B.Sc.
 February 13th 1909



Examined Kirby 1909.

W.R.R.

P. 11

Ring Valley
 Examined Feb 17 09