


5 cm

RING VALLEY MINE



Plan and Section 50 F^t Level

Scale 40 F^t to the Inch

Robert J. Allan A.S.M.B. A.I.M.M.
17/3/1911

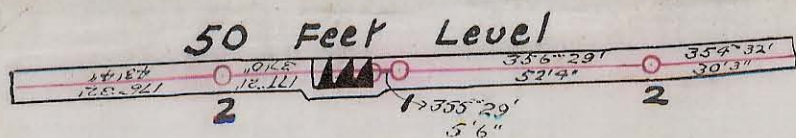

PLAN

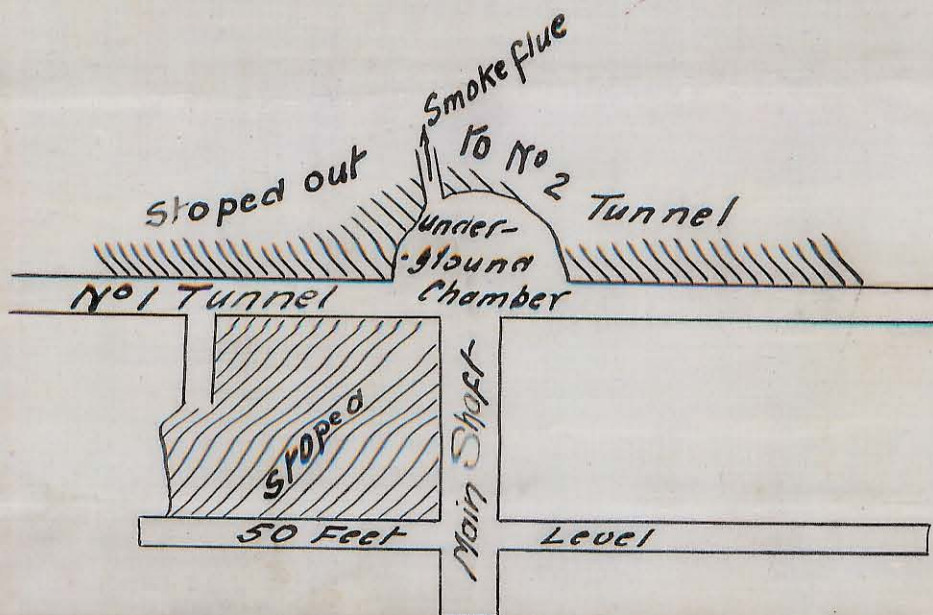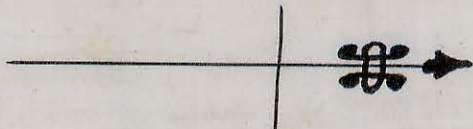

Longitudinal Section

