


WESTERN WORKINGS

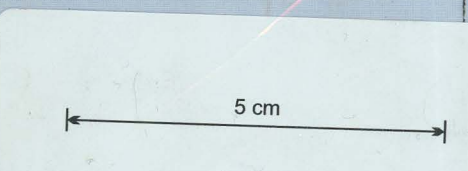

THE

5814
M

5250
M

FOR YEAR ENDED 31ST DECEMBER 1926 *Edgar Brutchett*

WATER TUNNEL

