

ROUND HILL S. & L. M. C^o N. L.


PLAN OF UNDERGROUND WORKINGS

SCALE 

GENERAL MANAGER
[Signature]

MINE SURVEYOR
W. Edgar Lovelace

Surveyed with 5" Transit June 1926

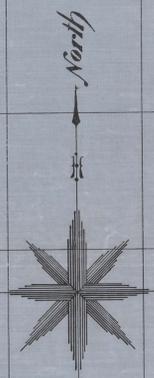

LEGEND

- N^o 1 TUNNEL 
- N^o 2 TUNNEL 
- N^o 1 SHAFT LEVEL 

