


ROUND HILLS & L.M. CO.


PLAN OF WORKINGS

SCALE, 50 FEET TO 1 INCH

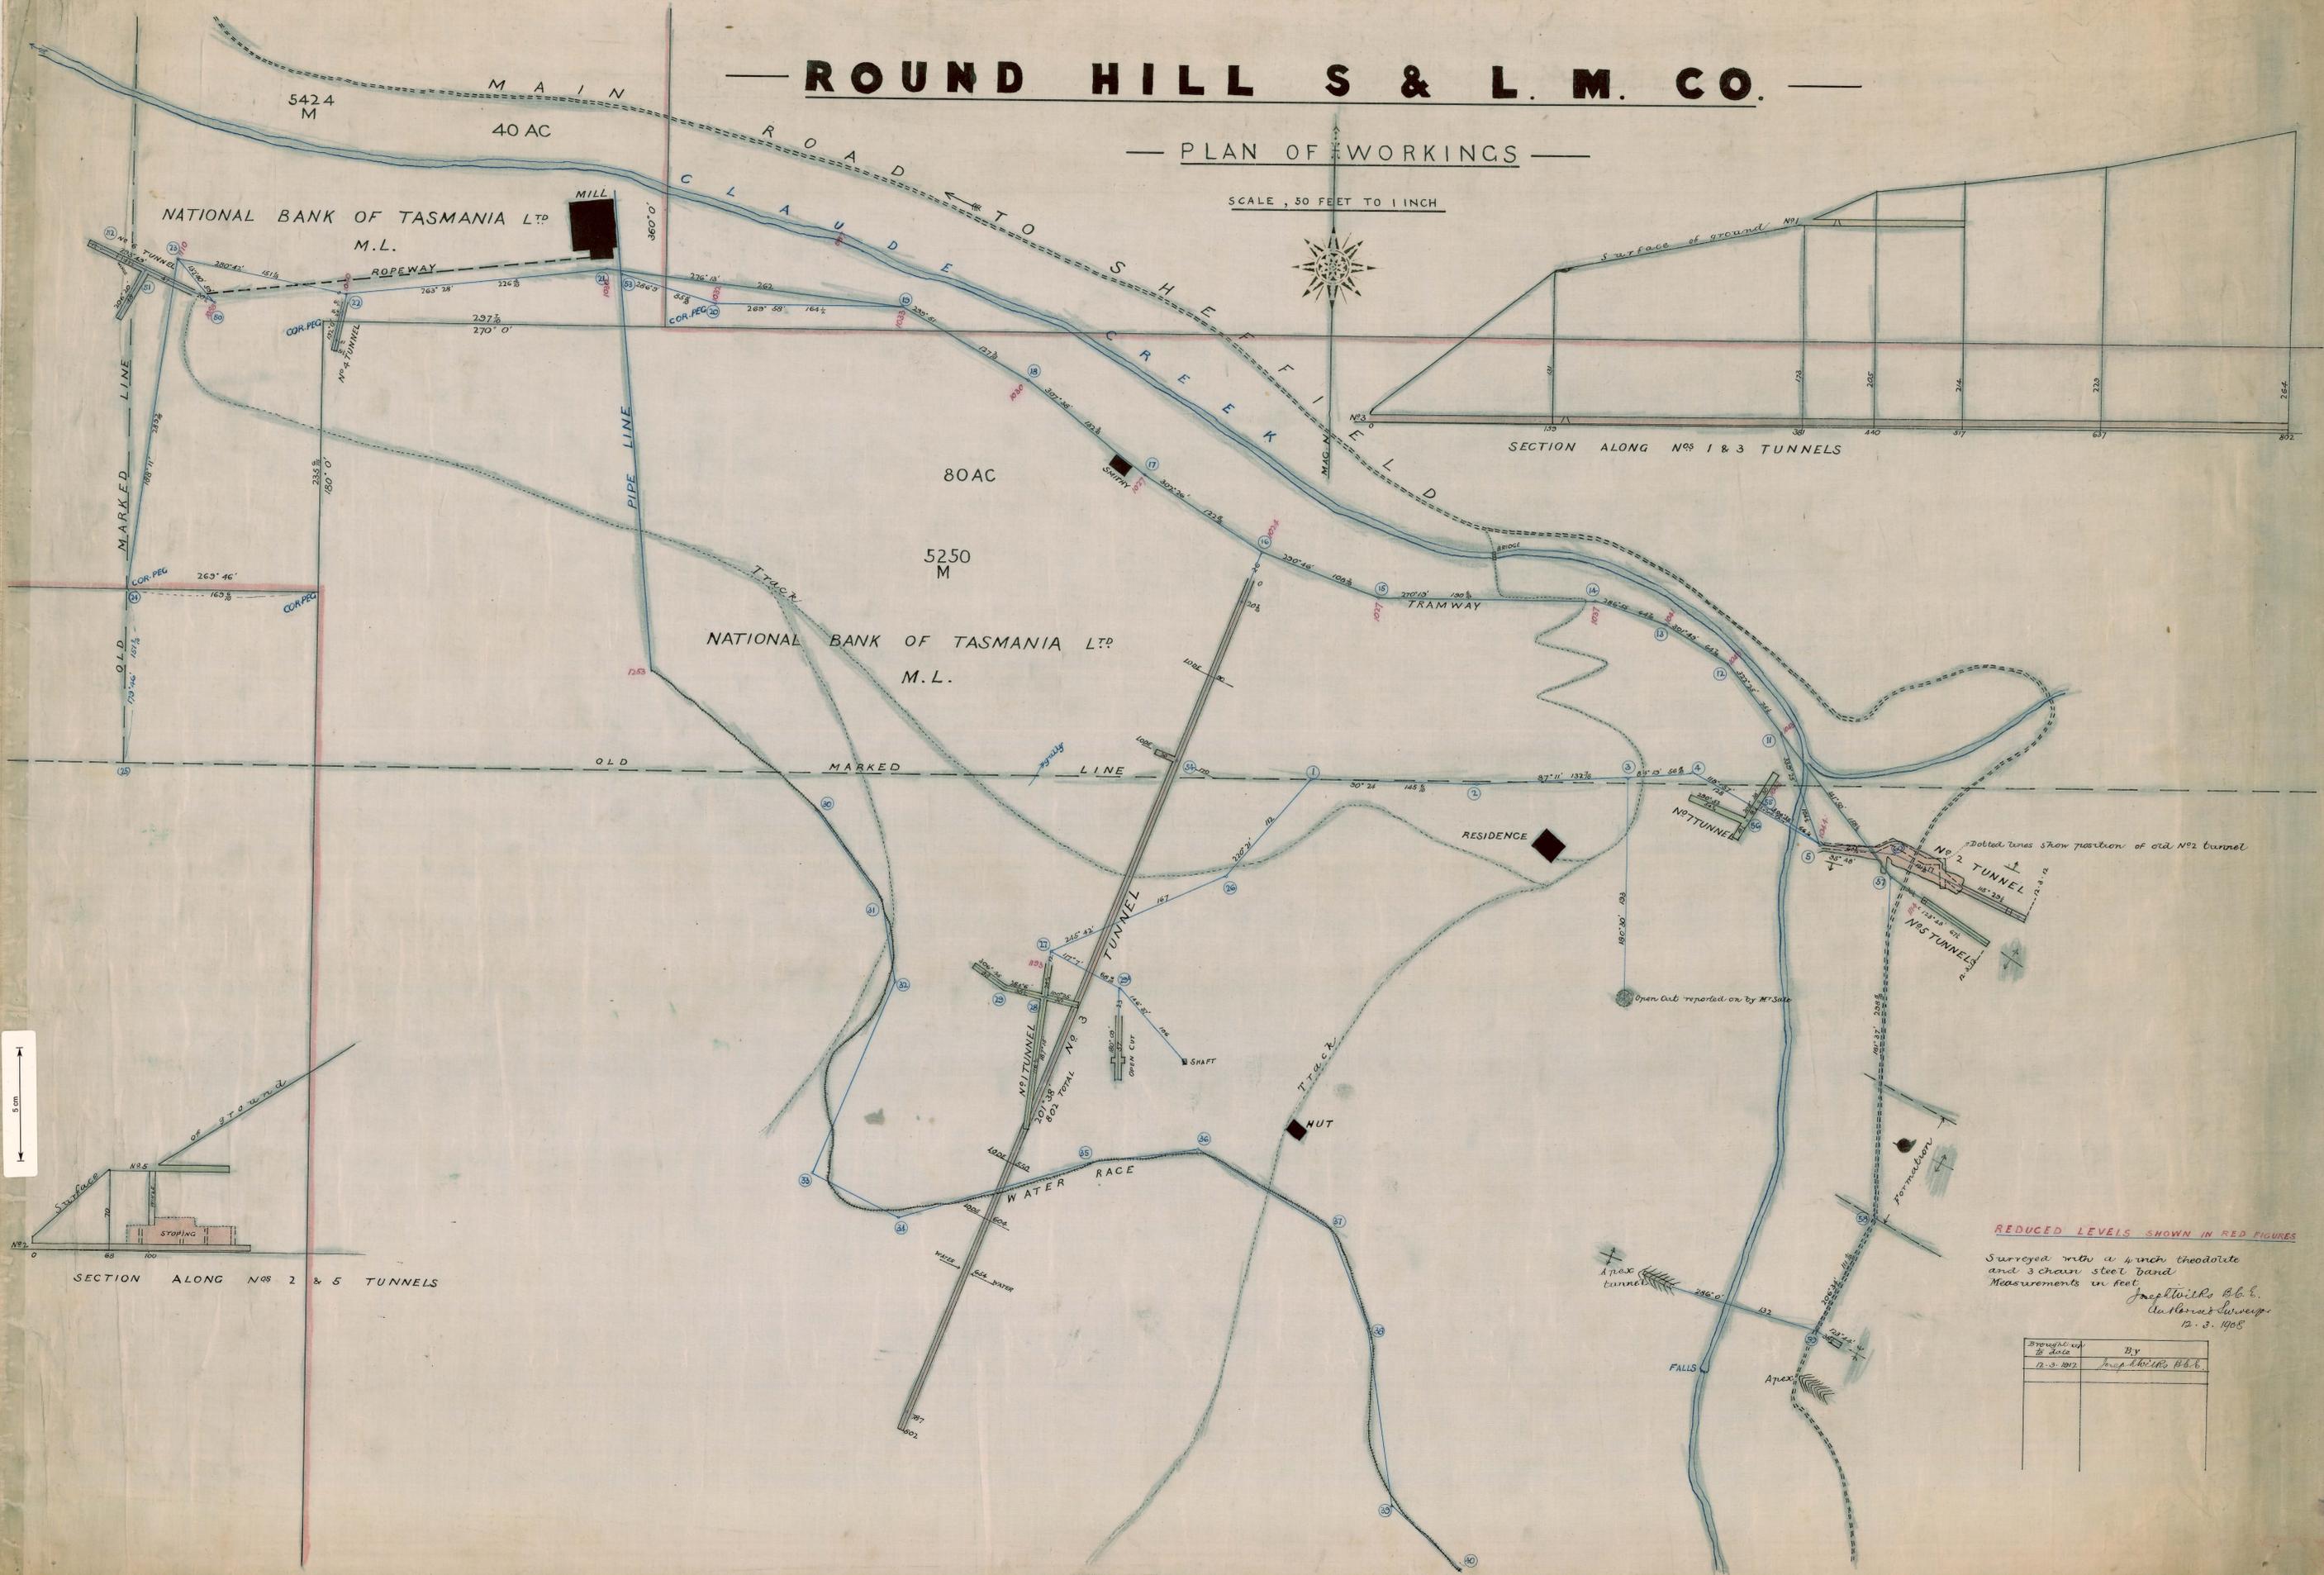

SECTION ALONG NOS 1 & 3 TUNNELS

SECTION ALONG NOS 2 & 5 TUNNELS

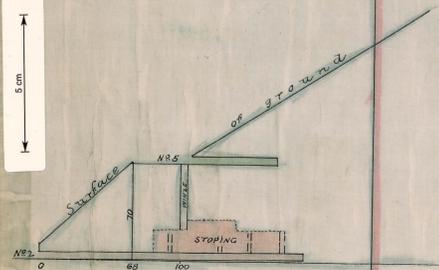

REDUCED LEVELS SHOWN IN RED FIGURES

Surveyed with a 4 inch theodolite and 3 chain steel band. Measurements in feet.
Joseph Wills B.L.S.
Assistant Surveyor.
12.3.1908

Brought up to date	By
12.3.1917	Joseph Wills B.L.S.

286-04

502