


286-08

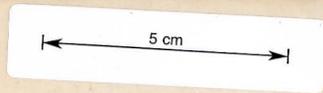

ROUND HILL EXTENDED SILVER AND LEAD MINING COMPANY. NO LIABILITY

WORK DONE SINCE STARTING:


Old Tunnel	DRIVEN	80	feet
Main Tunnel	"	265	feet
Intermediate	"	125	feet
On course of lode		45	feet
		<u>515</u>	

Open cuts and trenches 236 feet.

5 Roomed House, large ore shed,

2 Blacksmith Shops

Ore dump cleared for 10,000 tons seconds.

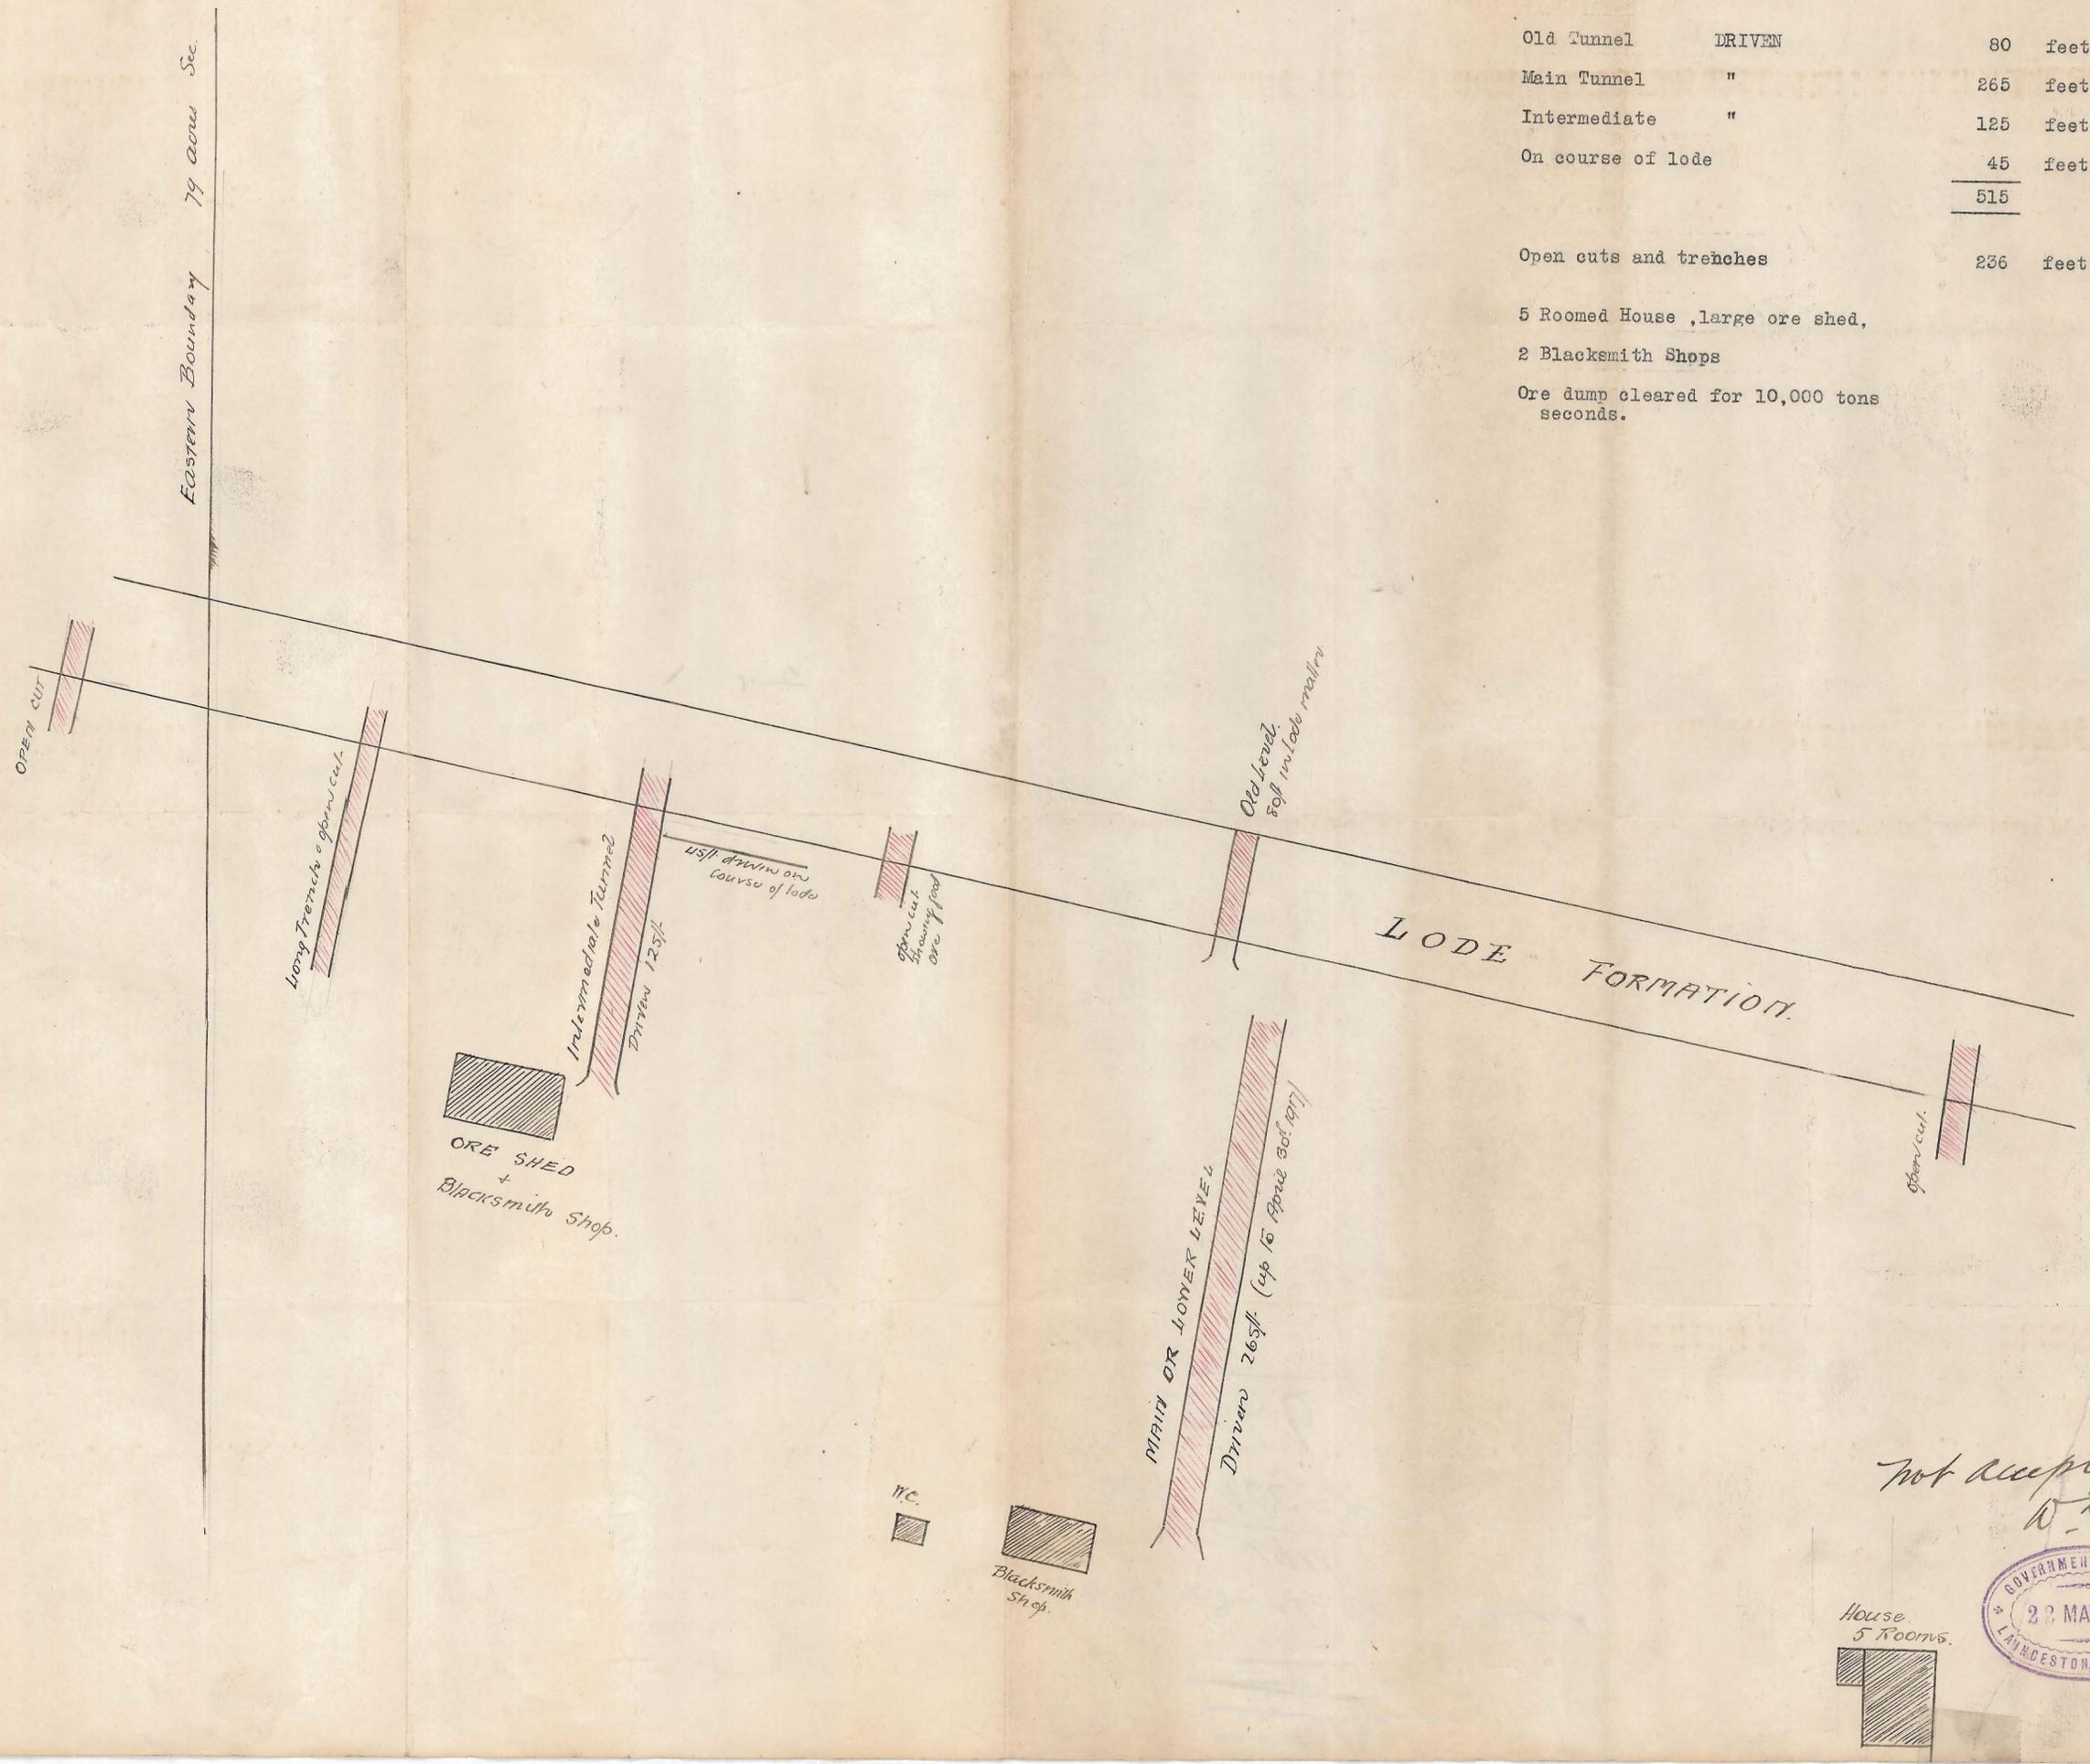

Not accepted
D.D.R.

HOUSE
5 ROOMS.

GOVERNMENT ASSESSOR
23 MAY 1911
LAMBTON, TASMANIA