


Field notes
attached herewith

5 cm

PLAN OF DULVERTON COAL MINES.
Situate in the County of Devon
Parish of Dulverton
Scale one chain to an Inch.

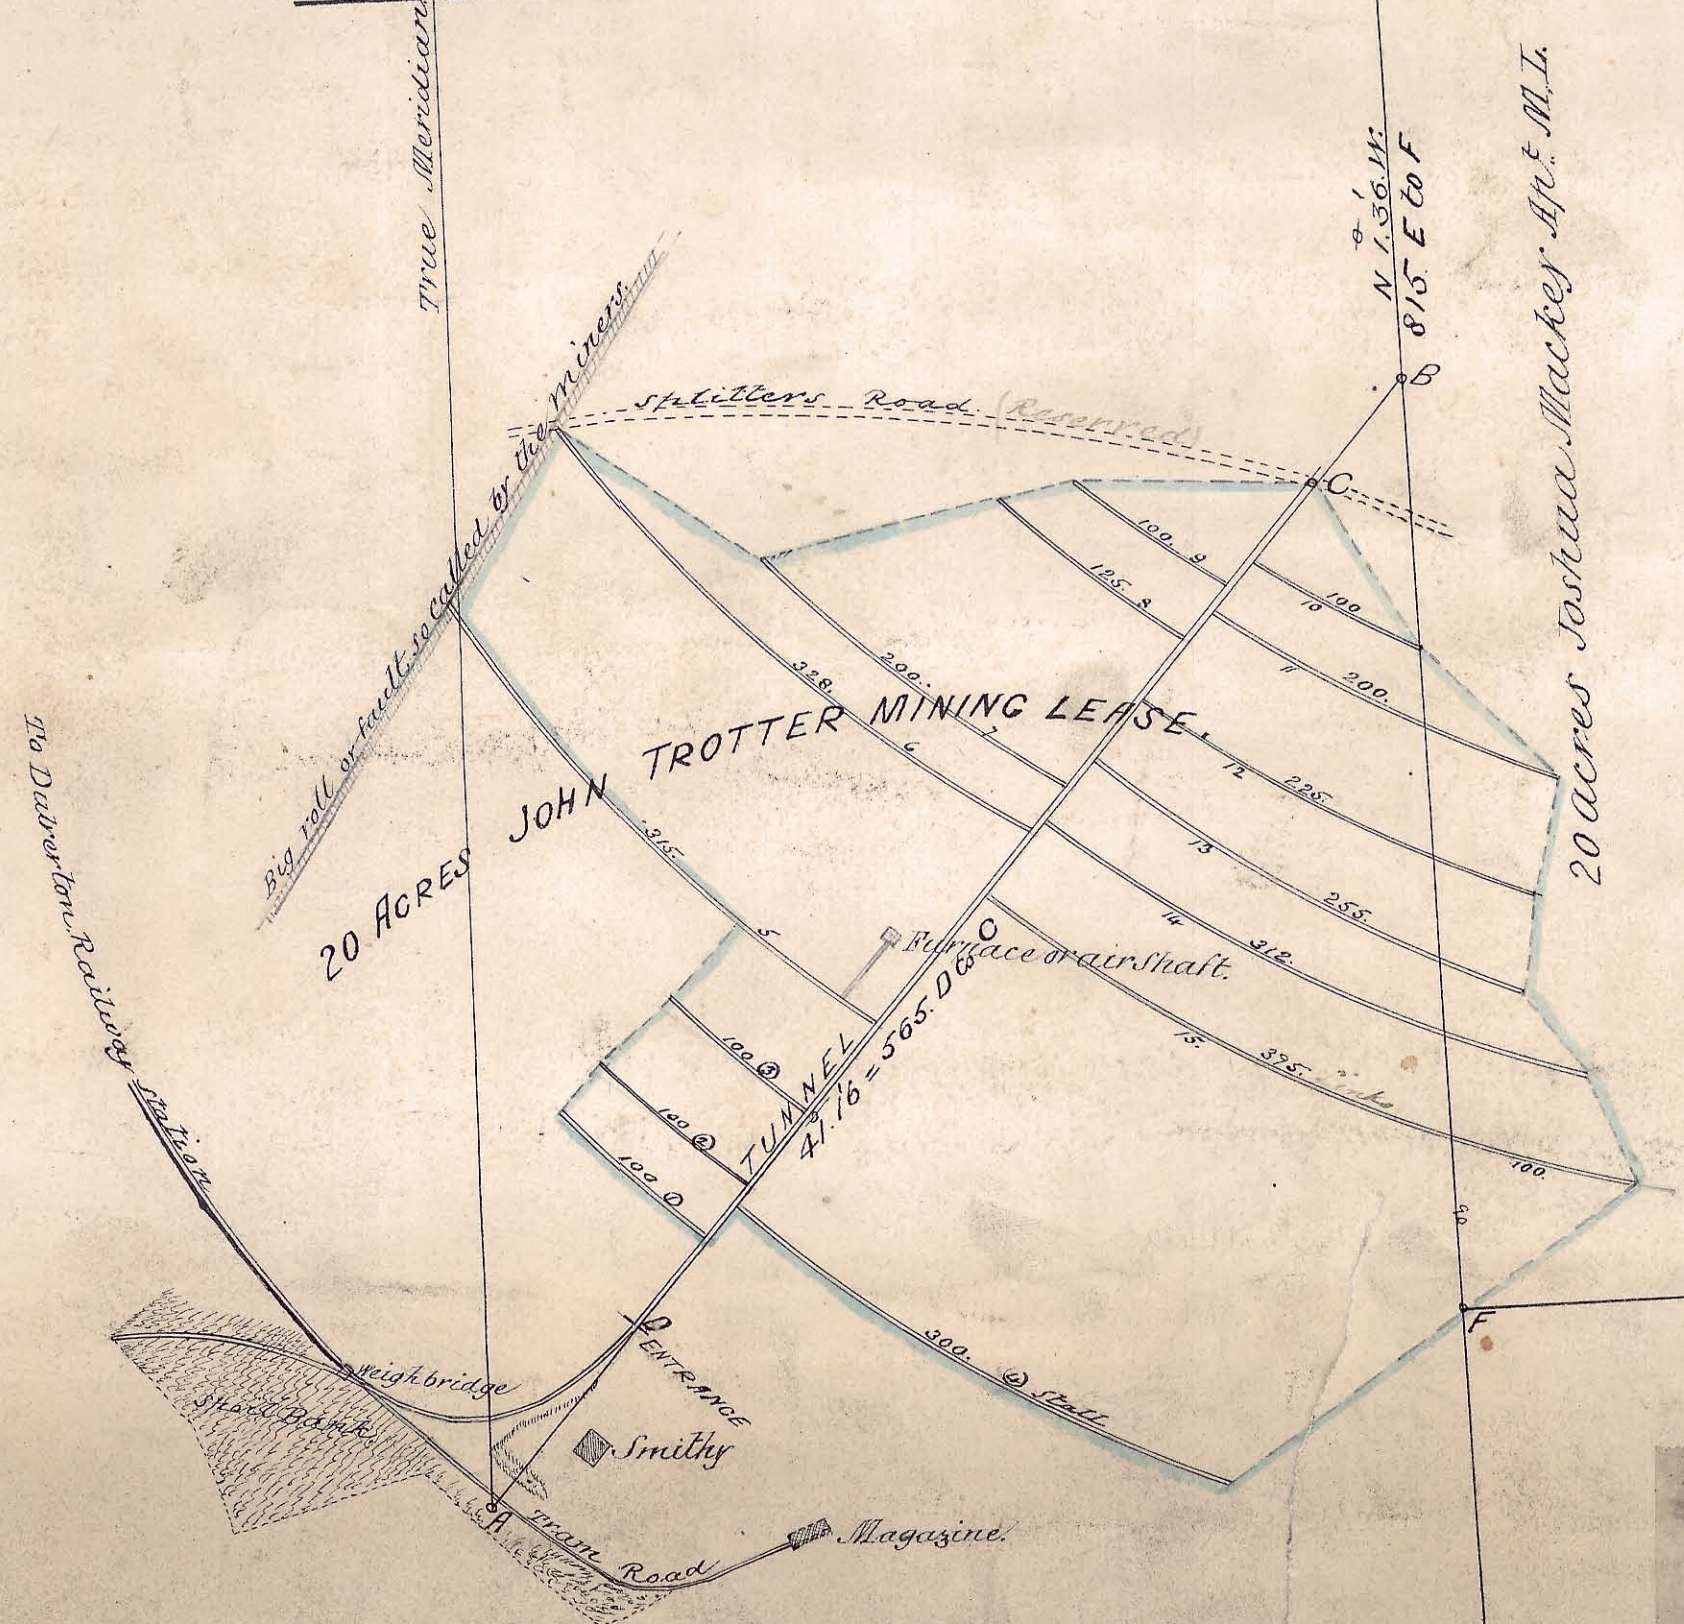

Note D to C Tunnel with stalls right and left no 1 to 15 for taking out Coal.
All the coal within the blue line has been taken out.
The stalls 5 to 15 inclusive have been measured and are approxi-
-mately parallel and level. Field notes herewith.

James Dooley
Jan 30th 1890

Section of Dulverton Coal mines
Horizontal Scale One Chain to An Inch.
Vertical Scale 10 feet to an inch. D to C TUNNEL.

James Dooley
Authorized Surveyor
Jan 30th 1890

