

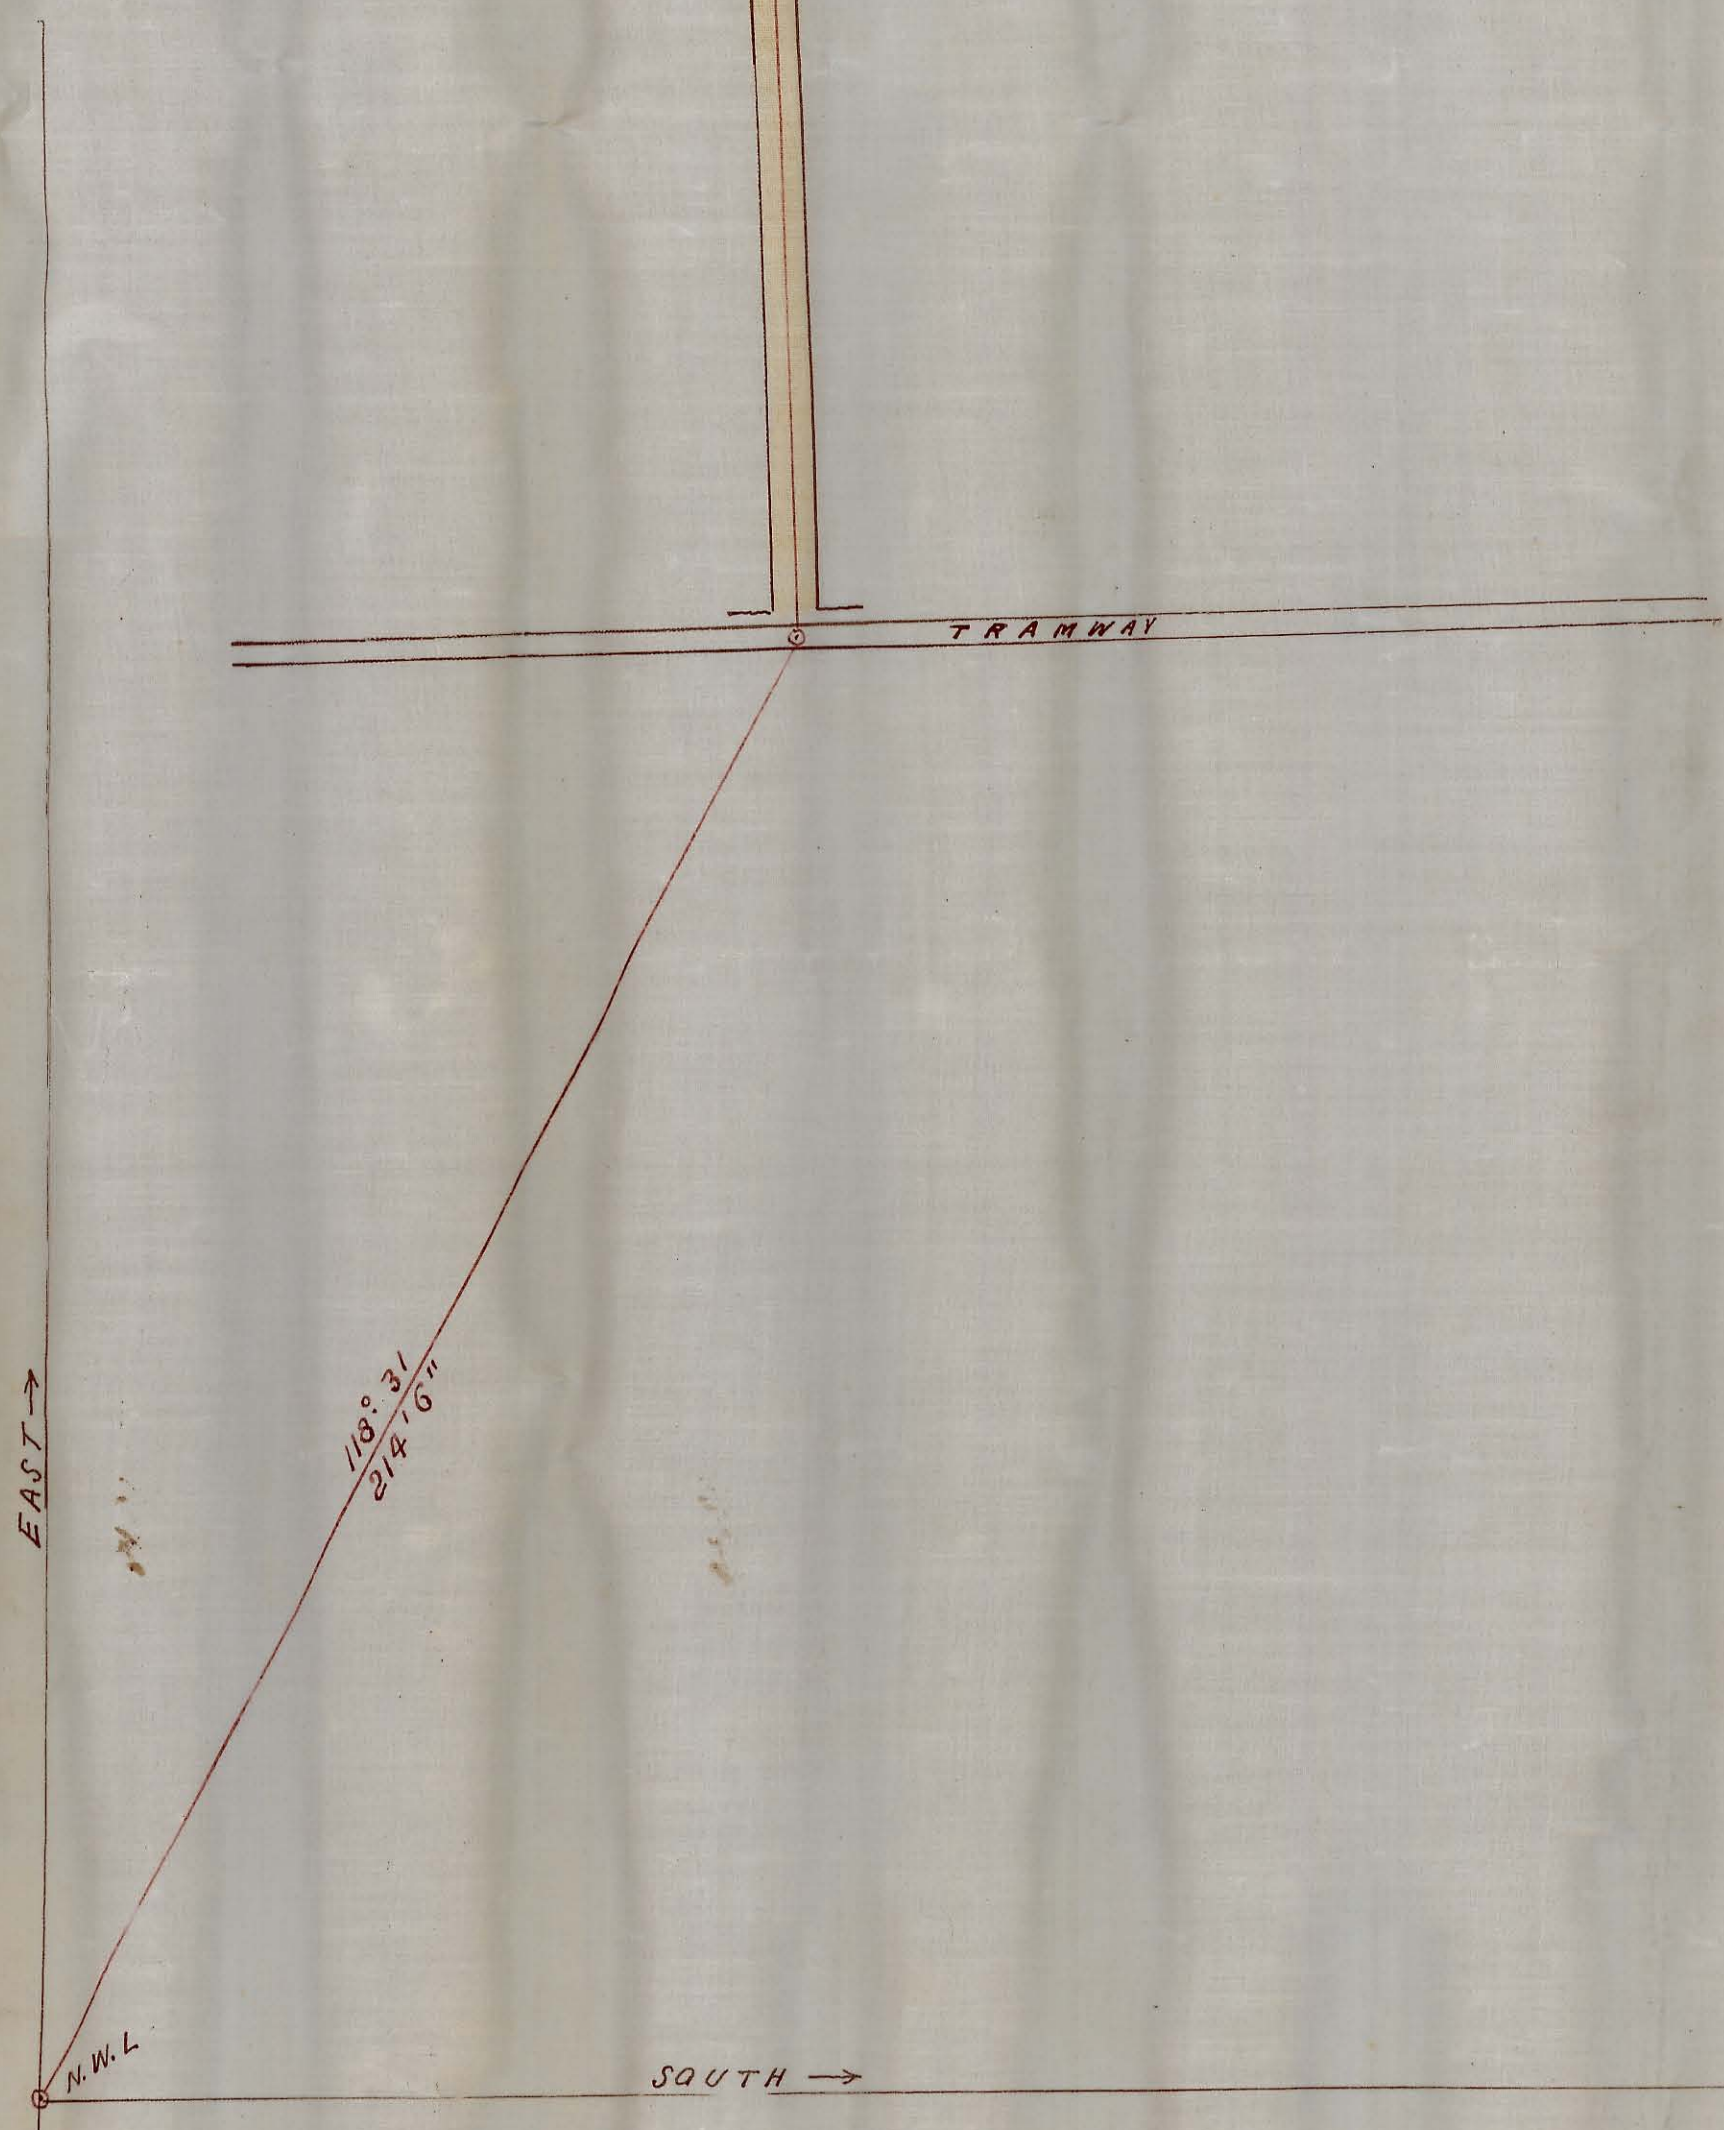


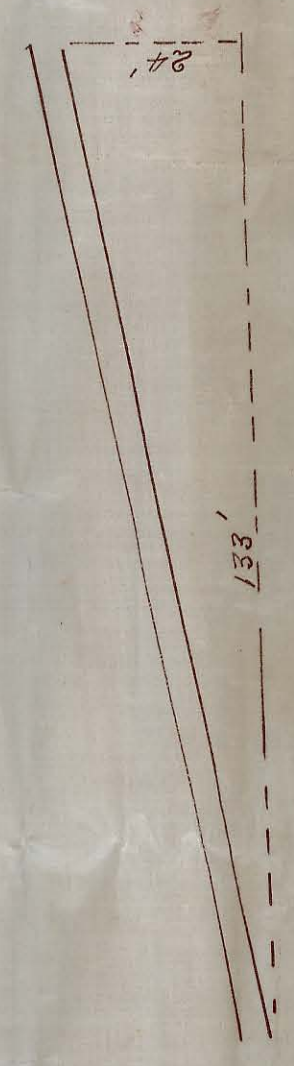

DULVERTON COLLIERY

Scale 25 ft to 1 inch

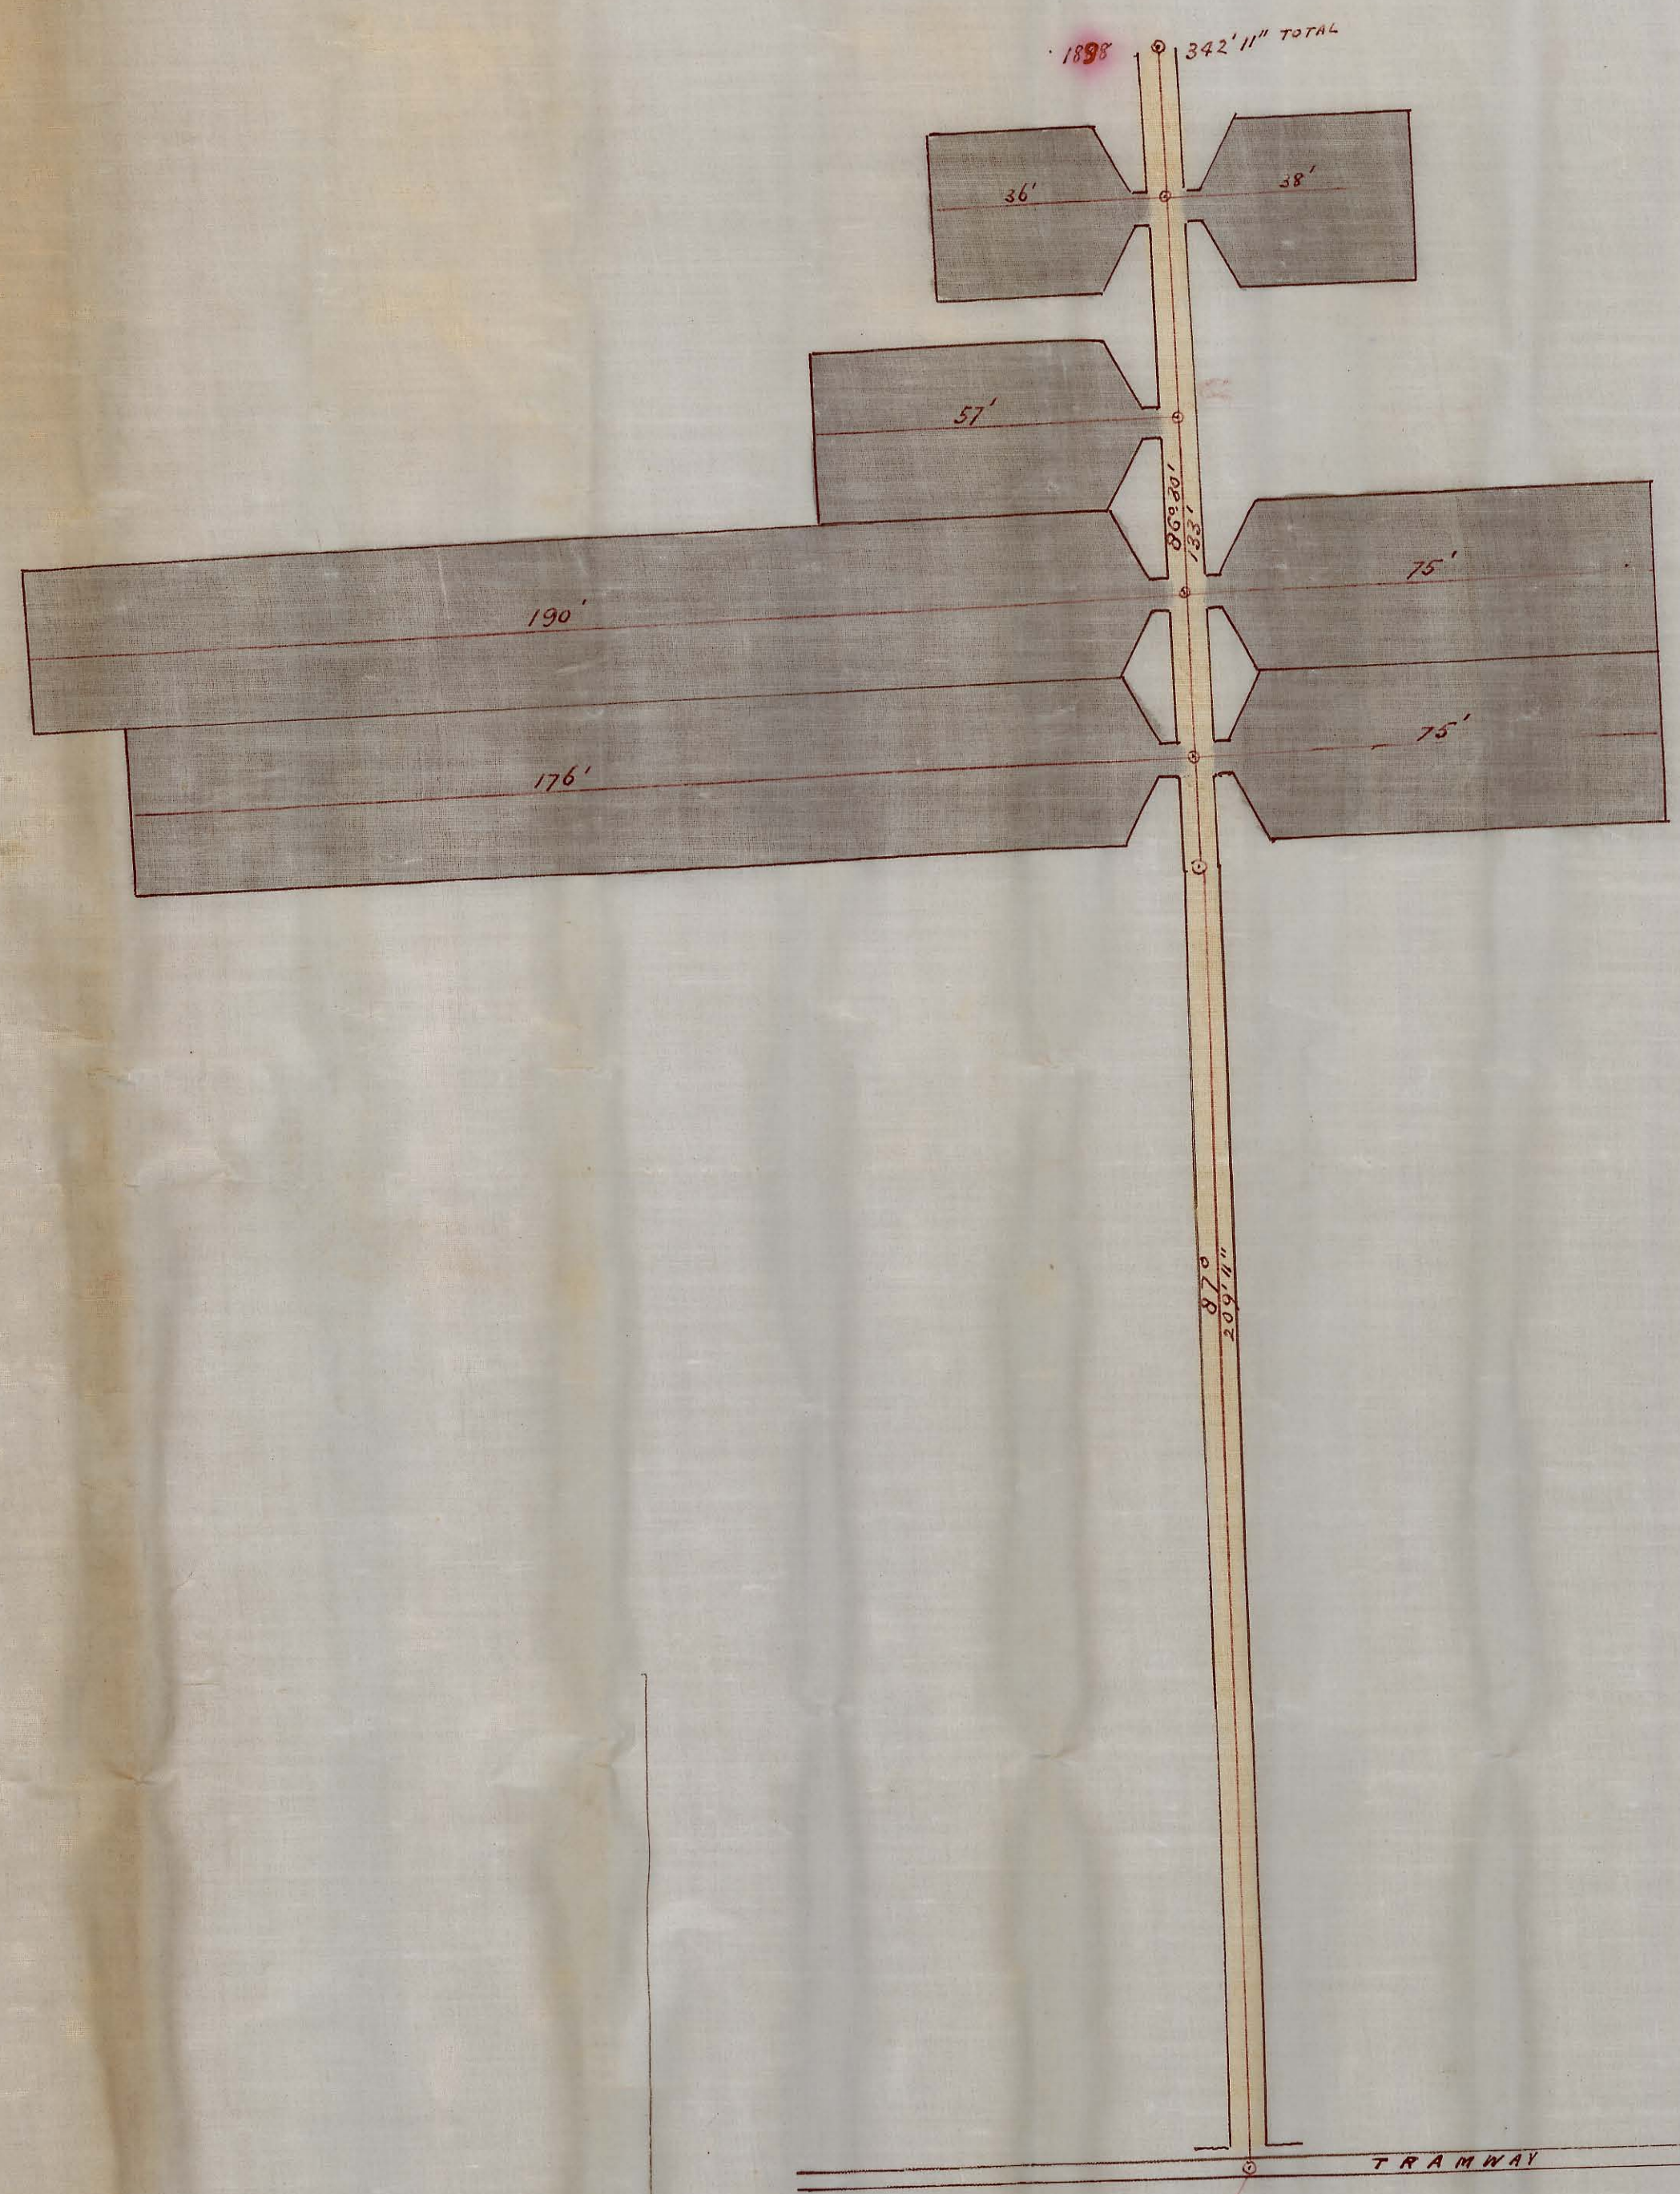

1888
Dulverton Colliery
Corrected
copy of work done during
1895. Shows survey & construction
of single watercourse.
Auth. Surveyor
4/2/99