


5 cm

DULVERTON COAL MINE

Scale 25ft to 1 inch.

*Certified correct copy of
plan of work for 1899
C. Knight, Watchman
Auth. Surveyor
31/1/1900*

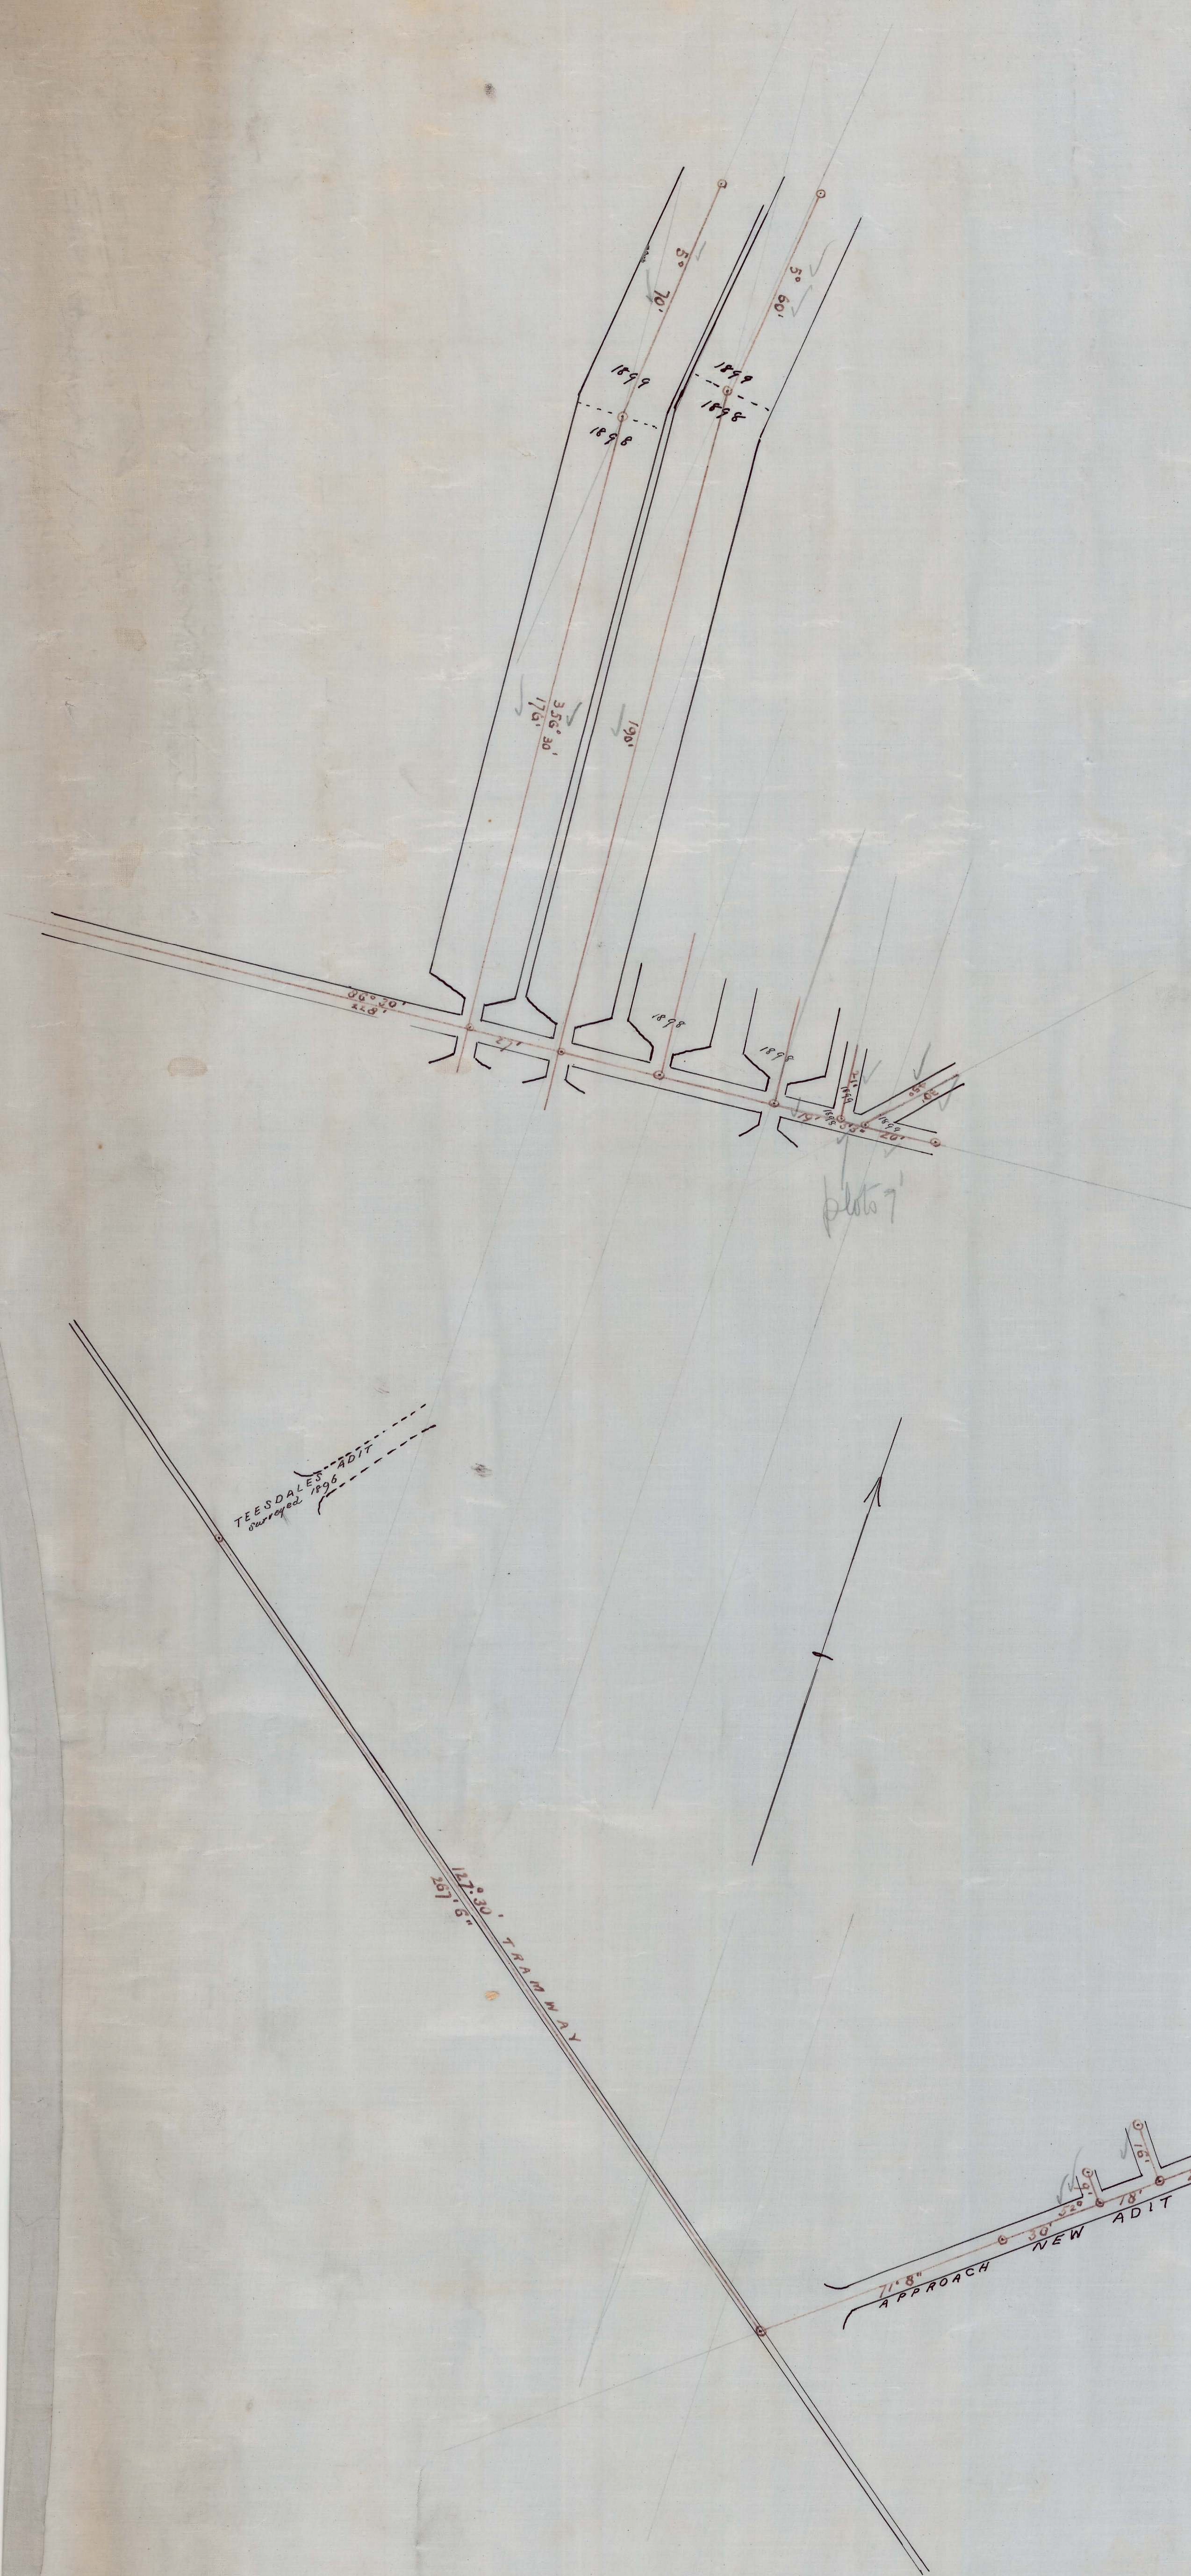

Proposed Car for 1888

Proposed Car for 1888