


287-04


81

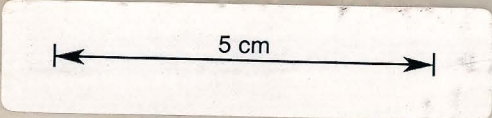

DULVERTON COLLIERY.

Scale 40 feet to 1 inch

Proposed for 1882

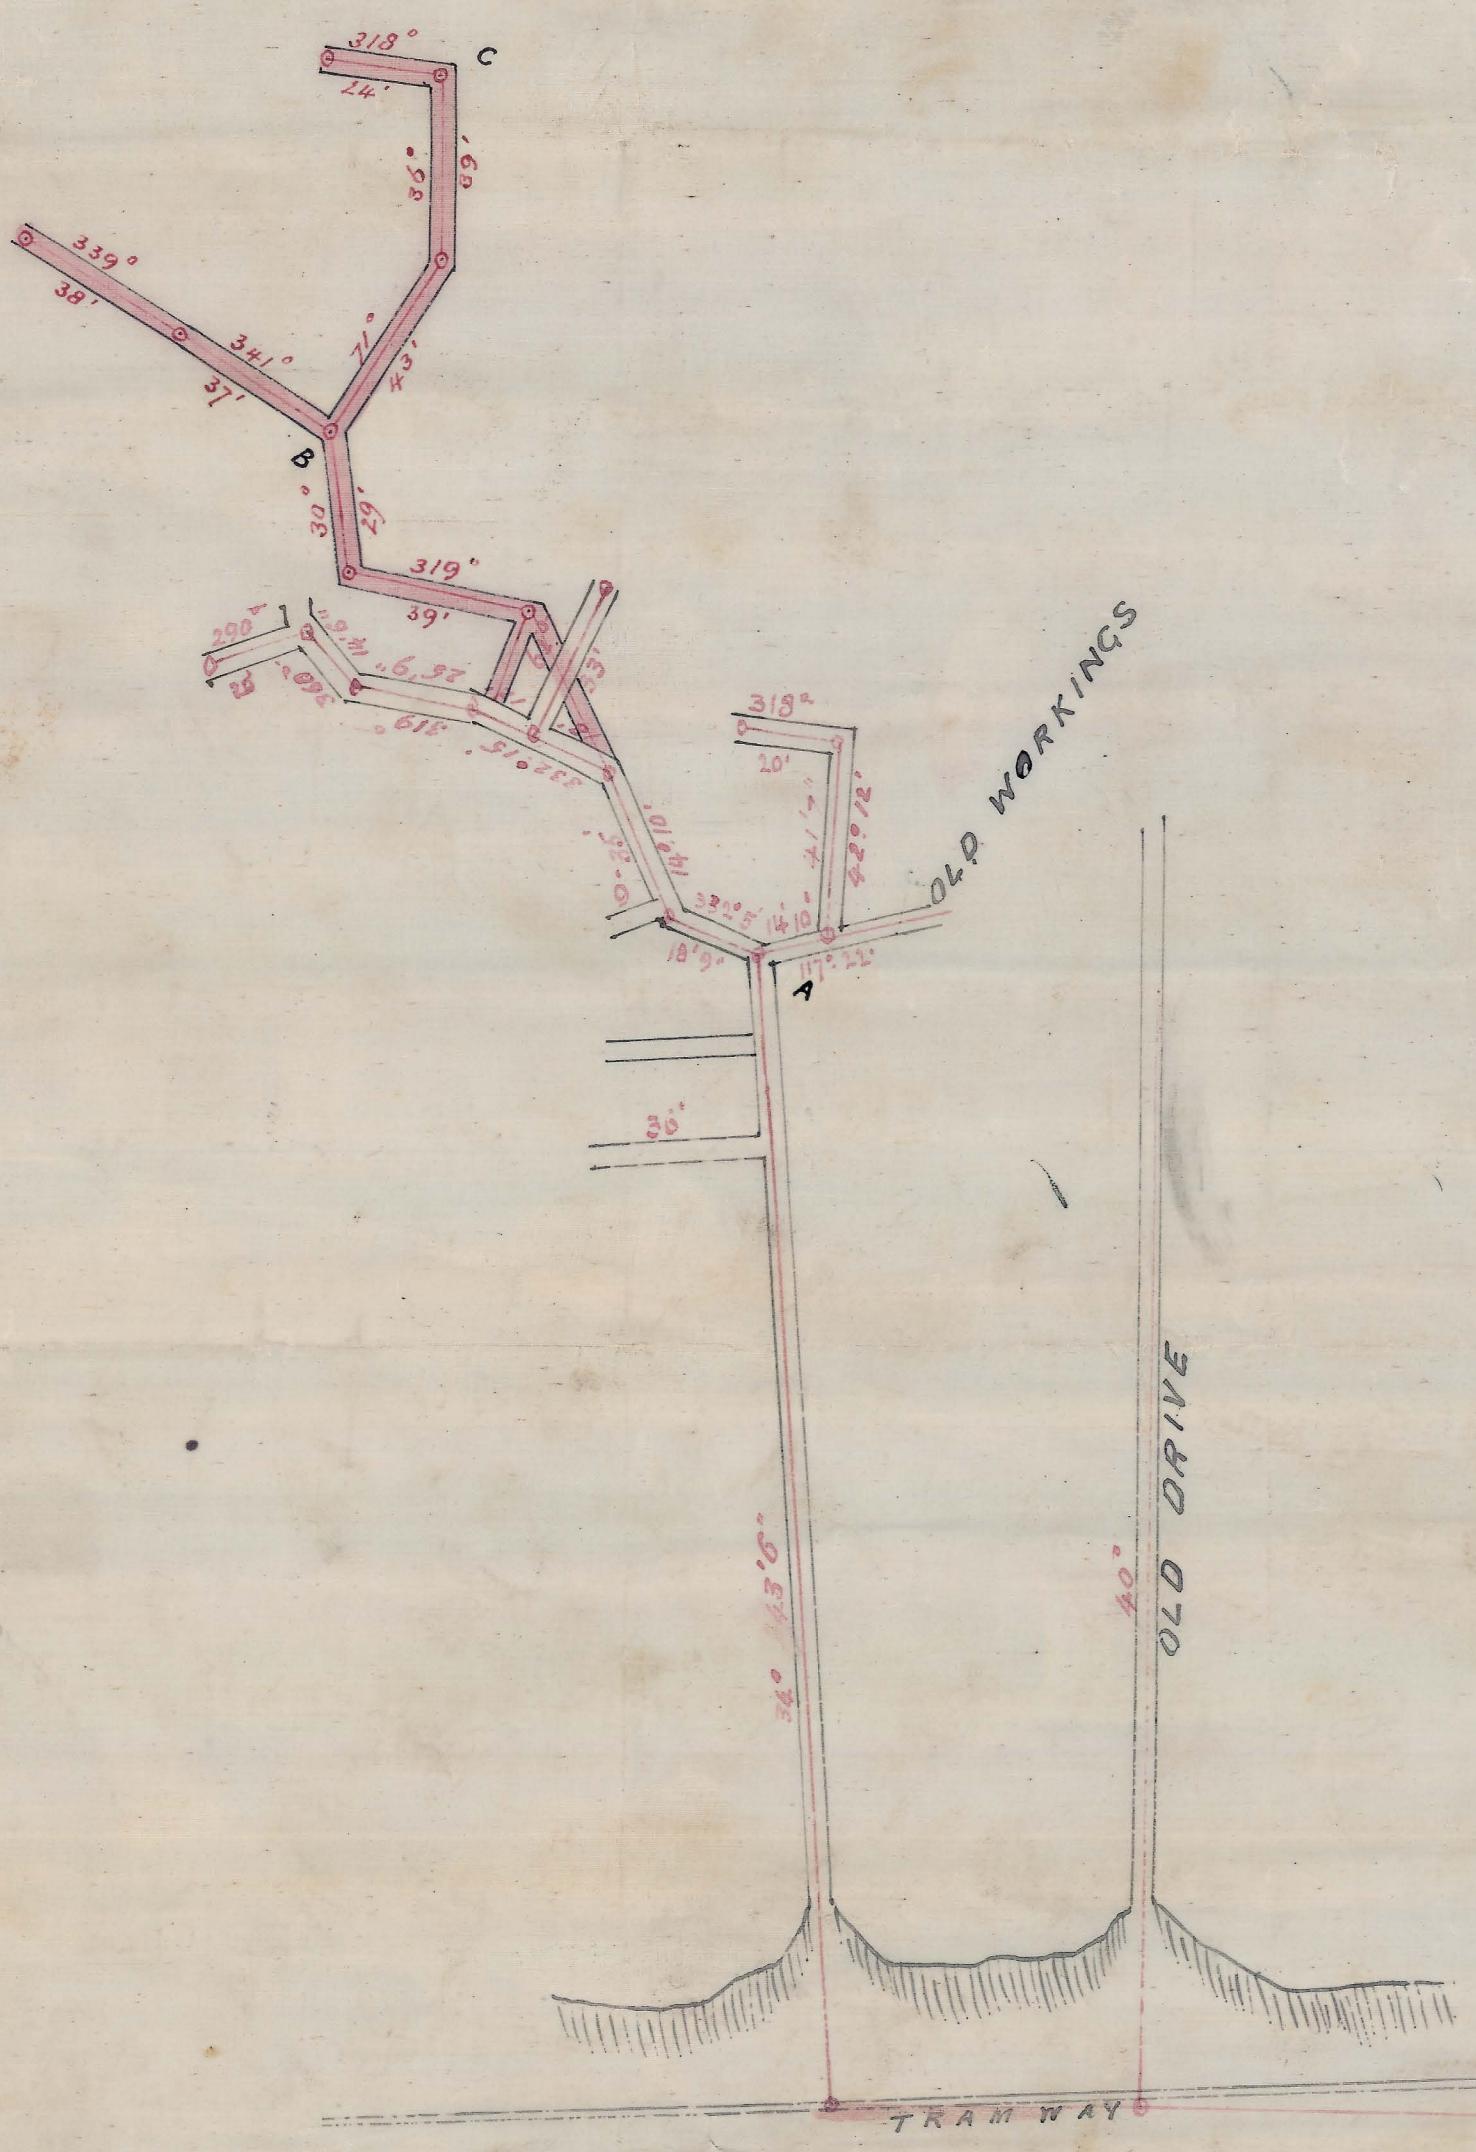

See 1744.
87m.

Corrected copy
of plan of work done
during the year 1896 & 1897
by J. B. Smith & Co. Ltd.
1897 colored red.

3 FEB 1898

10/2/97

Recd 3. 2. 98.

1881
Proposed for 1882

81