

PLAN

of the Underground Workings of the
Dulverton Coal Mine

Scale 2 chains to an inch



81



50 1/2 ac
John Cassell


N^o 2295

R. W. Pierce

484

N^o 1046 20 ac.

R. W. Pierce

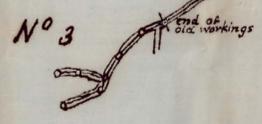


N^o 1745 20 ac.


R. W. Pierce

1300
180° Datum of Bearings

B 1420

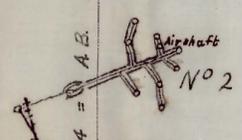

N^o 1744

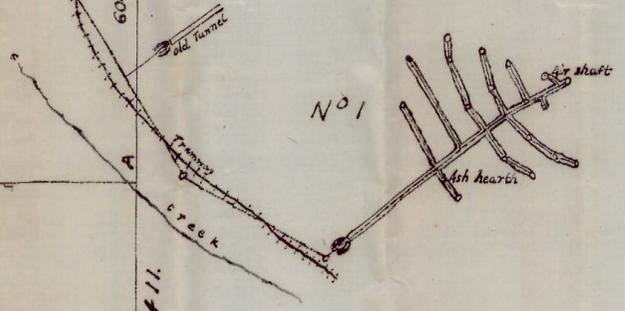

N^o 1

R. W. Pierce

Dulverton Colliery
1845

Arthur Hall
Surveyor
Leith.

18

18