



287
04

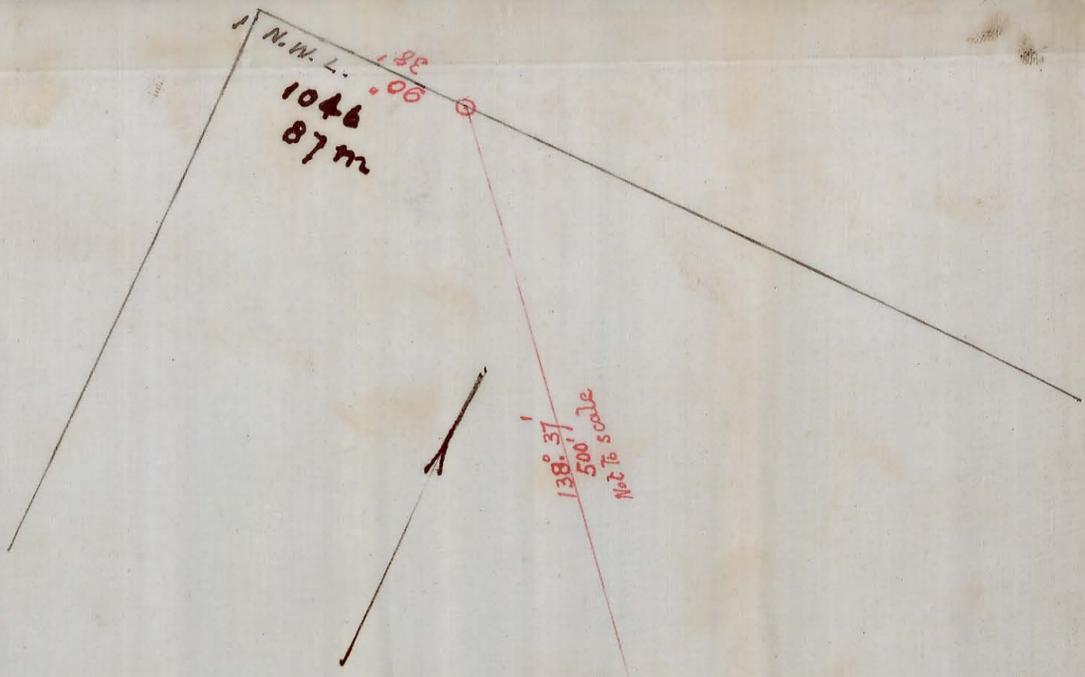

Dulreerton Coal Mine

Scale 25 ft. to 1 in.

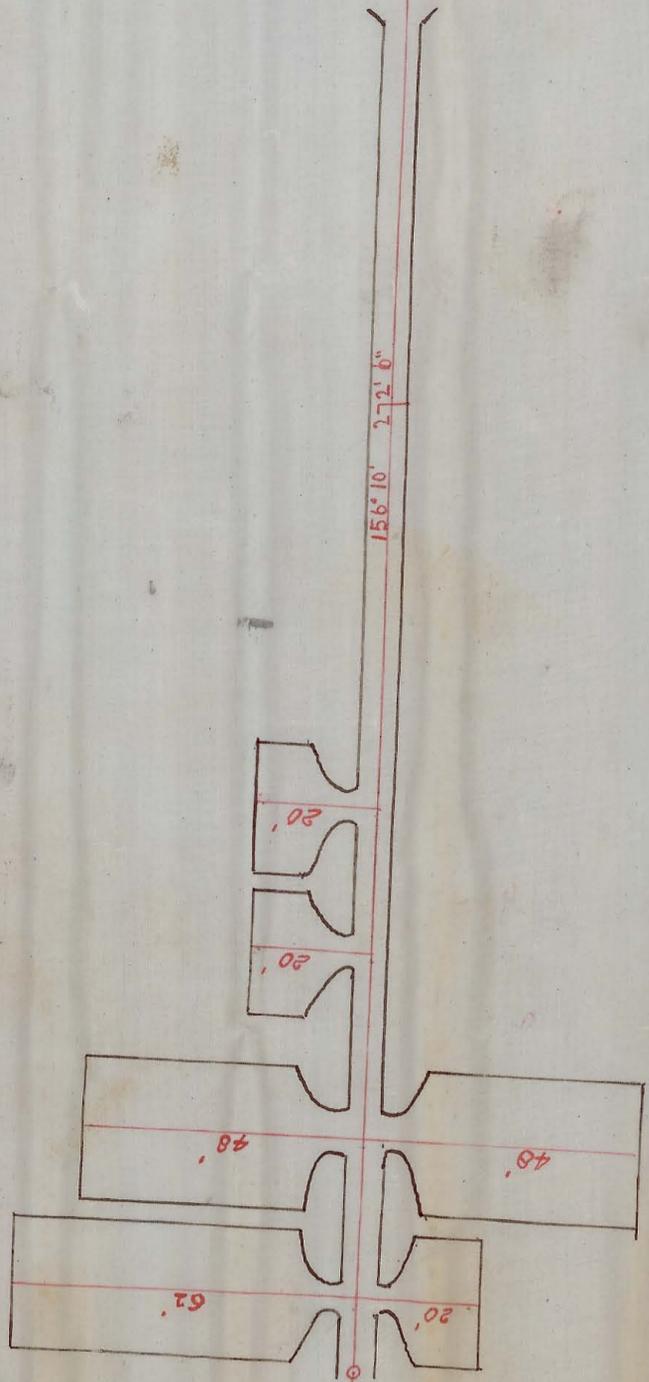

Certified correct
copy of plan of work
done during 1900.
Geo. H. B. Sargeant
Chief Watchman
6/2/1901



Dulreerton Coal Mine
1001 1901