




288-05

5 cm


RENISON BELL TIN MINE

NORTH ORE BODY

Scale 1 inch = 40 Feet

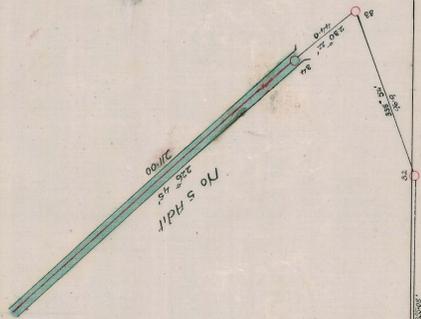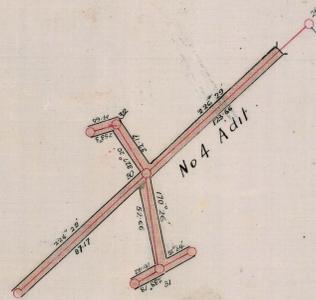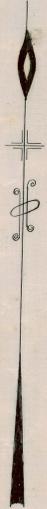

Consolidated Lease
N^o 4023 119 ac
W. Q. Finlay & E. Hawson
M. L.

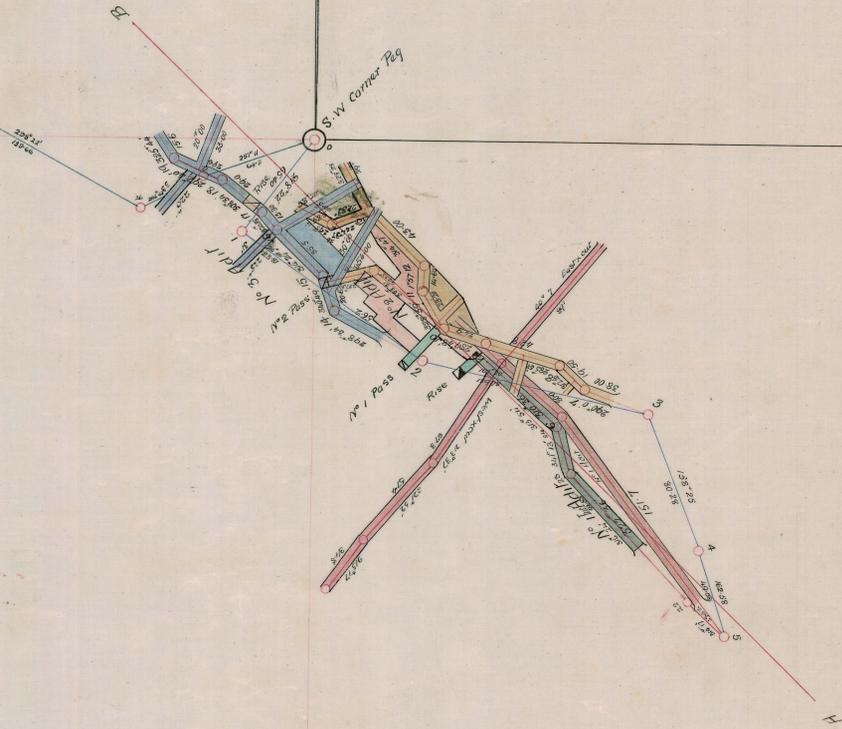

Instrument Used 4.104 Transit theodolite

W. Q. Finlay
Surveyor
December 31st 1911
J. P. Keeth Dec. 31st 1912
W. B. Scott May 1914