

288-06


5 cm

# RENISON BELL TIN MINE

## North Ore Body

Scale 1 inch = 40 Feet

J. B. Scott  
May 1914

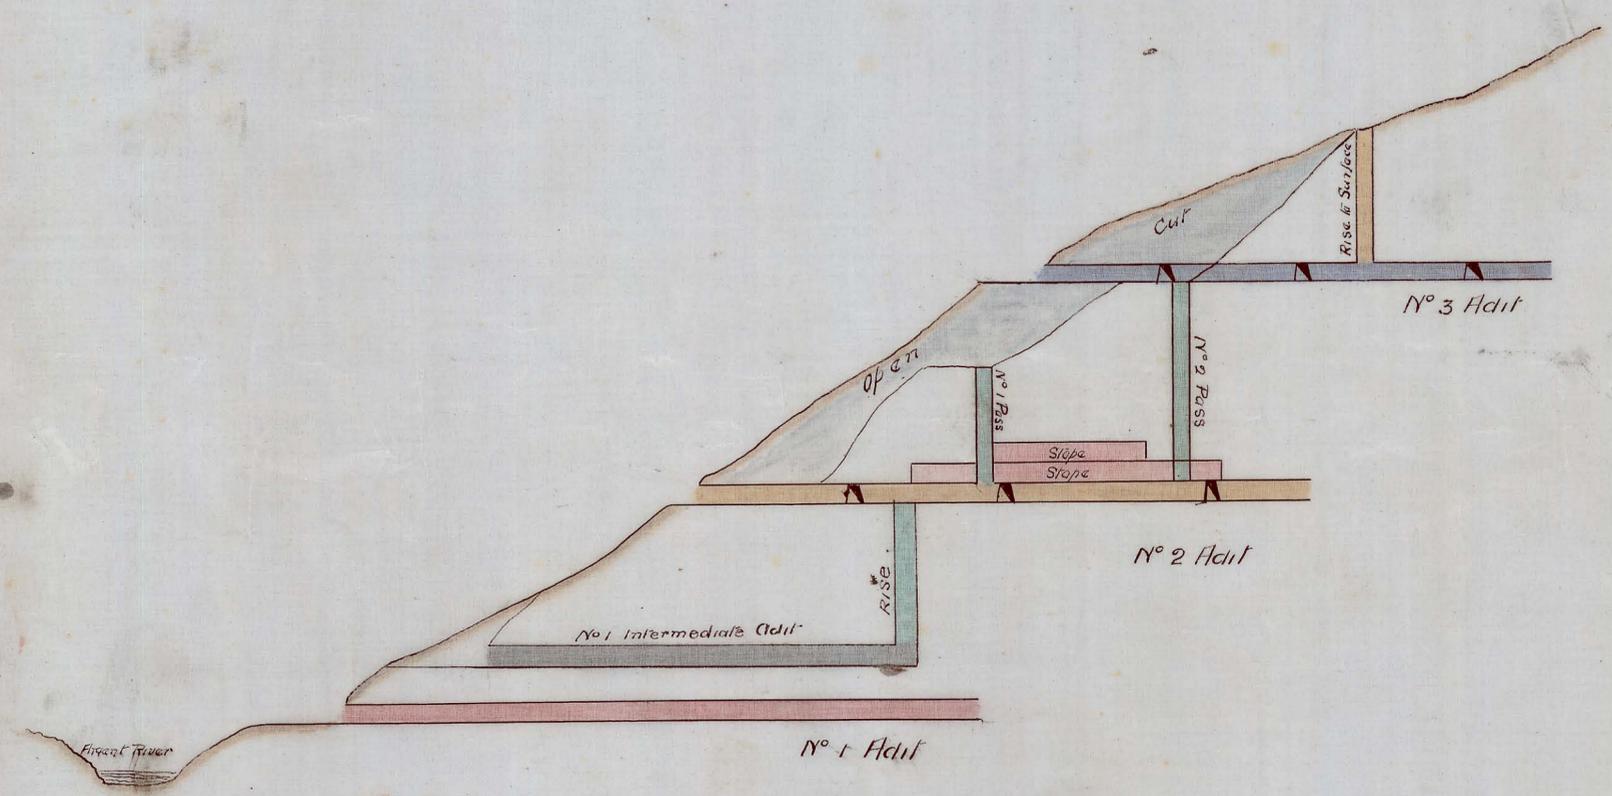

Longitudinal Section on Line A. B.

J. B. Scott  
3/2/13