



284
-07

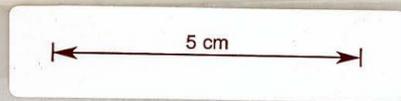

RENISON BELL TIN MINE

Longitudinal Section on Line AB

Scale 1 inch = 40 Feet

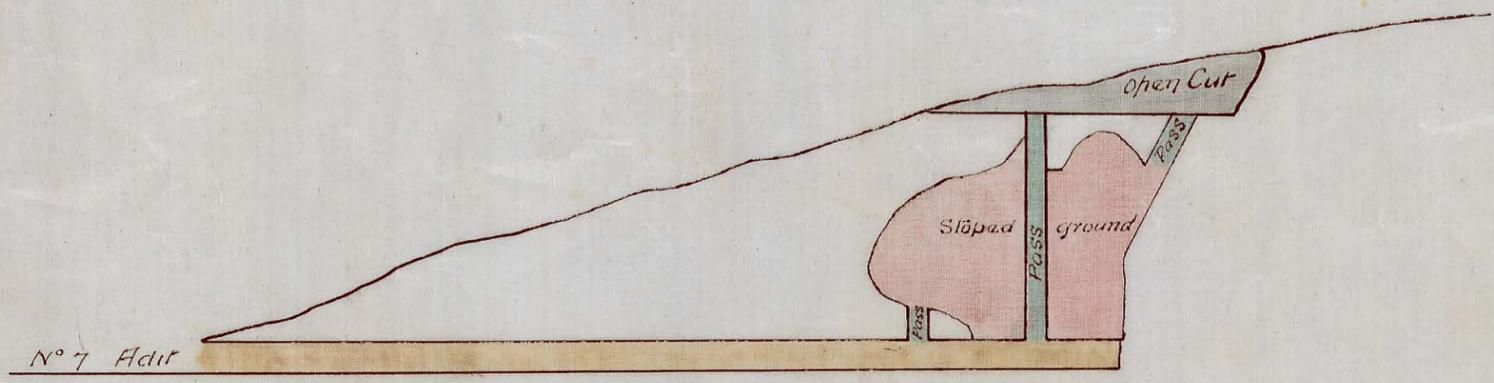

*J. B. Scott
3/2/43*