


ADELAIDE PROPRIETARY


SILVER LEAD MINE

DUNDAS.


5 cm

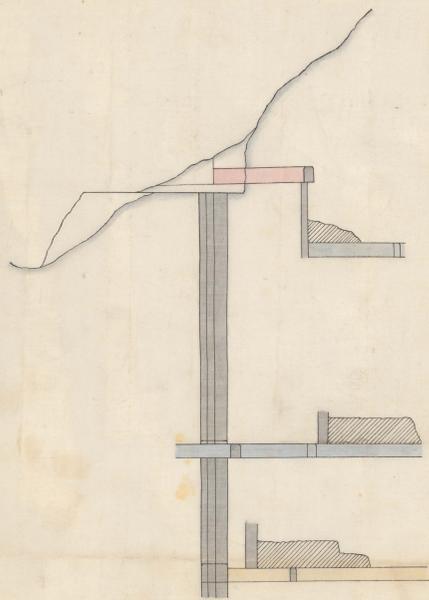

LONGITUDINAL ELEVATION

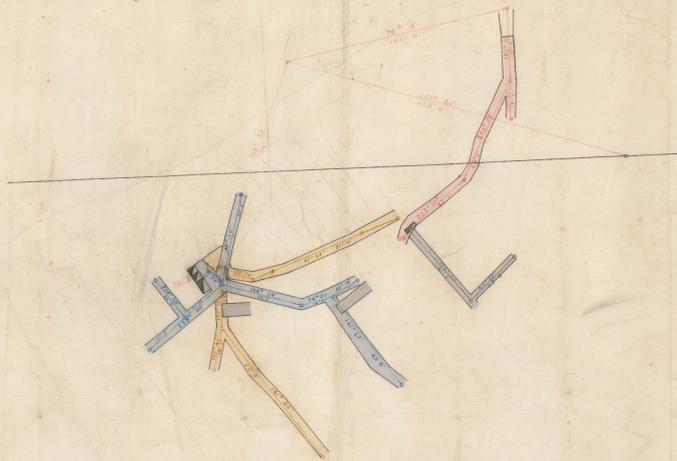


PLAN

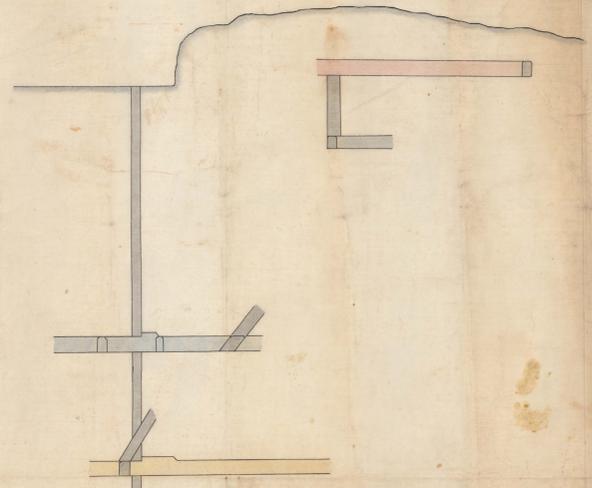


CROSS SECTION


MAIN SHAFT AND N°1 TUNNEL

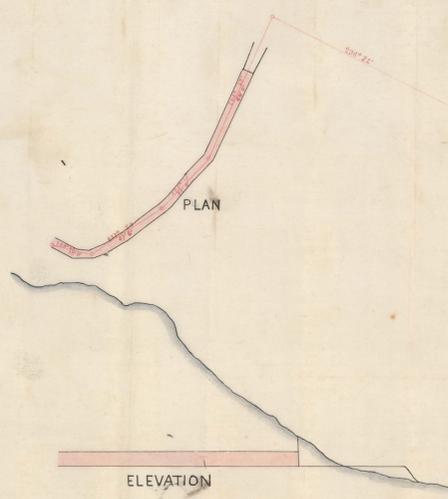

N°2 TUNNEL

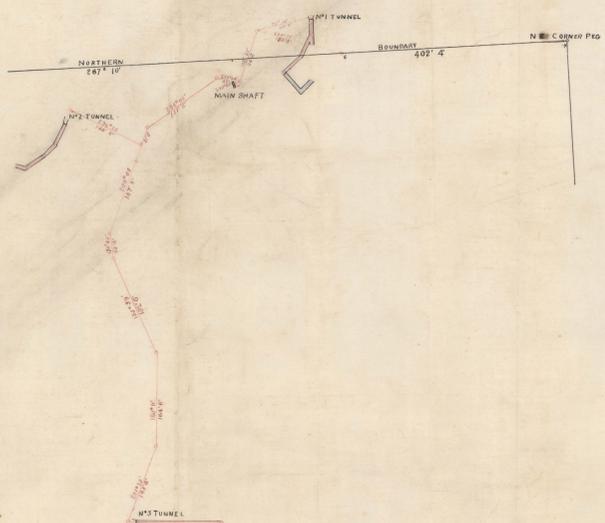

CONNECTION PLAN

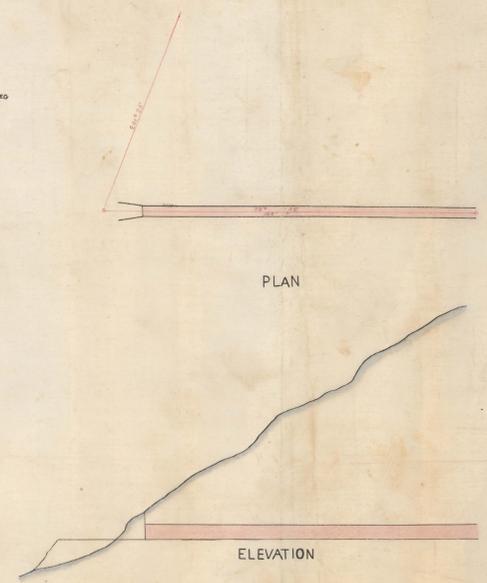

N°3 TUNNEL

SCALES :-
WORKINGS 25 F^t TO 1 INCH
CONNECTION PLAN 100 F^t TO 1 INCH

6-1-93

REFERENCES :-

- TUNNELS
- 327' LEVEL
- 187' LEVEL
- 170' LEVEL
- SHAFTS RISSES &c
- STOPS JANY 93

Alfred P. Hamilton
Surveyor

Transit Theodolite used.