


# PLAN of LORD BRASSEY NICKEL COMPANY N.L. UNDERGROUND WORKINGS Scale 25 Feet to an inch 1899

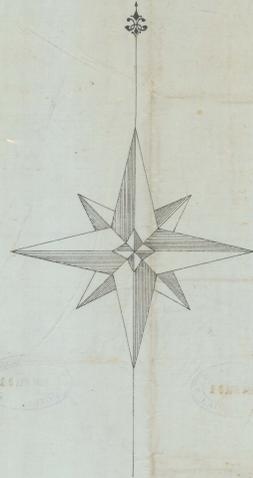

*I David Jones of Moraitoh hereby declare this plan to be substantially correct for the purposes of the Mines Act of 1895.*

*David Jones*


District Surveyor  
Moraitoh Tas 28.2.99.

1758  
91M


80AC

## SECTIONS


Transverse Section

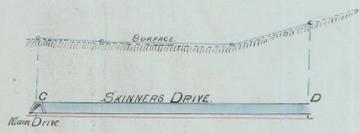

Transverse Section

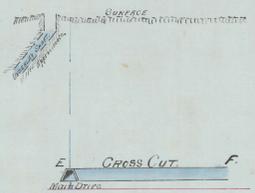

Longitudinal Section

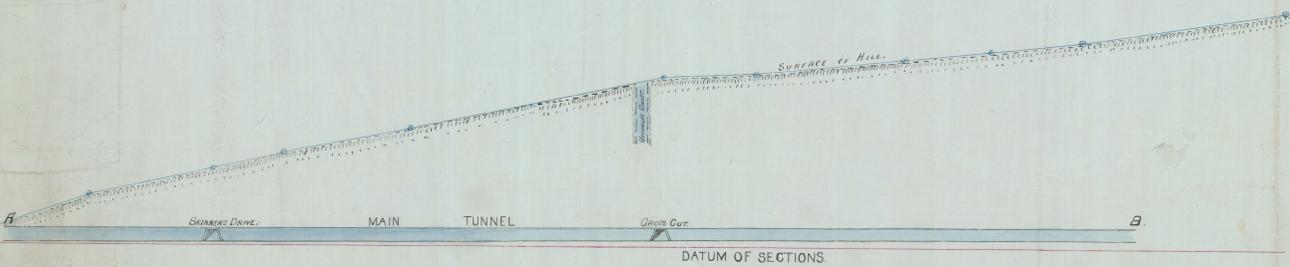

*Handwritten notes or signatures in the bottom right corner.*