


Silver King, P.A. N.L.

SOUTH KING MINE


"Fahey's Tribute"

UNDERGROUND WORKS.

Scale 25 FT. = One Inch

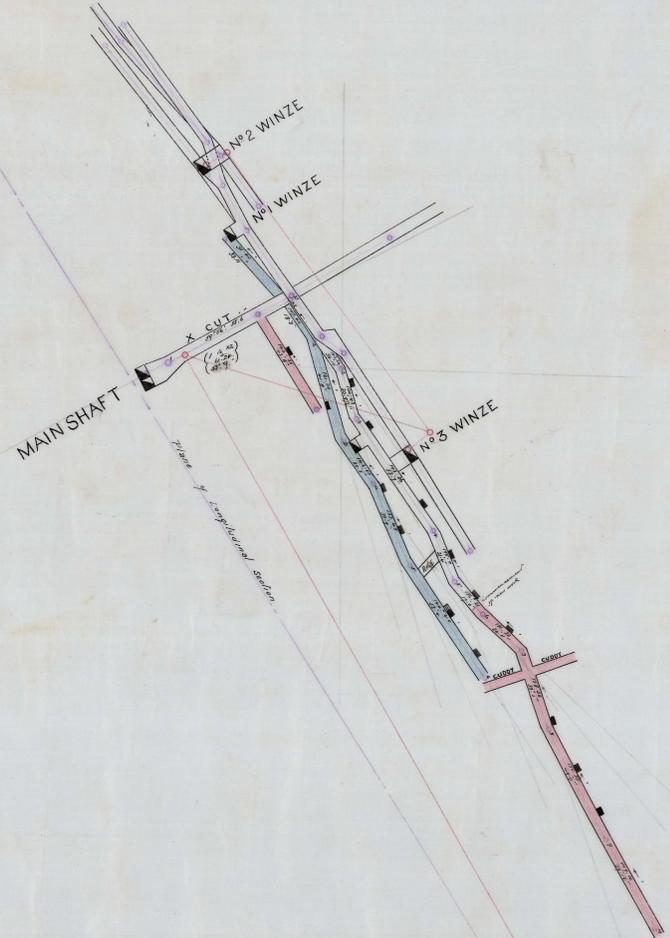

LONGITUDINAL SECTION

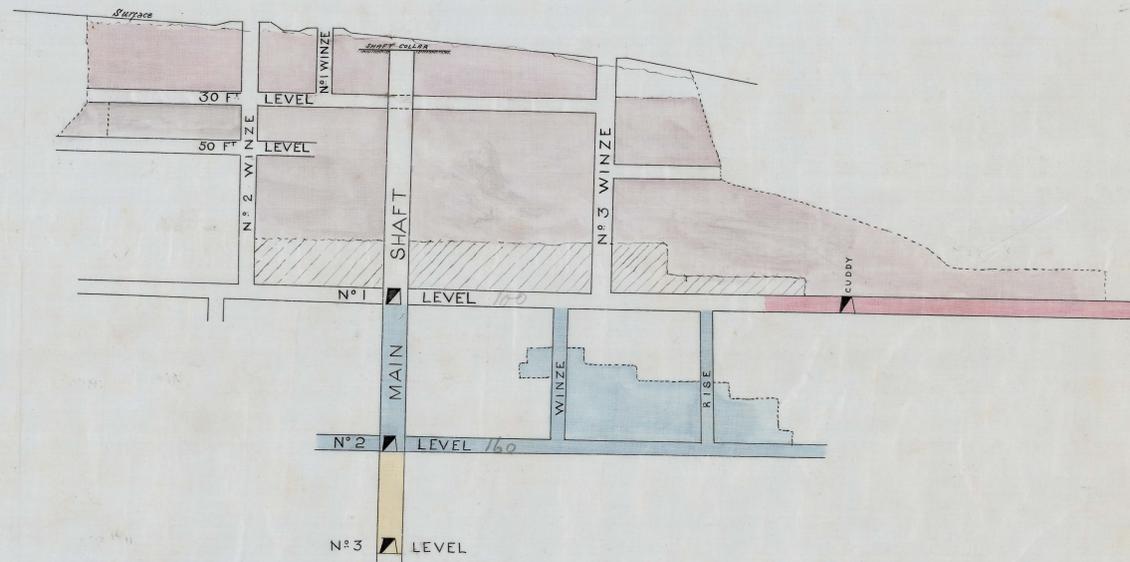

222 87 M

*J. H. Loring's
P.L. Certificate No. 1204
Month 12 1901*



SE CORNER