


9th May
1894

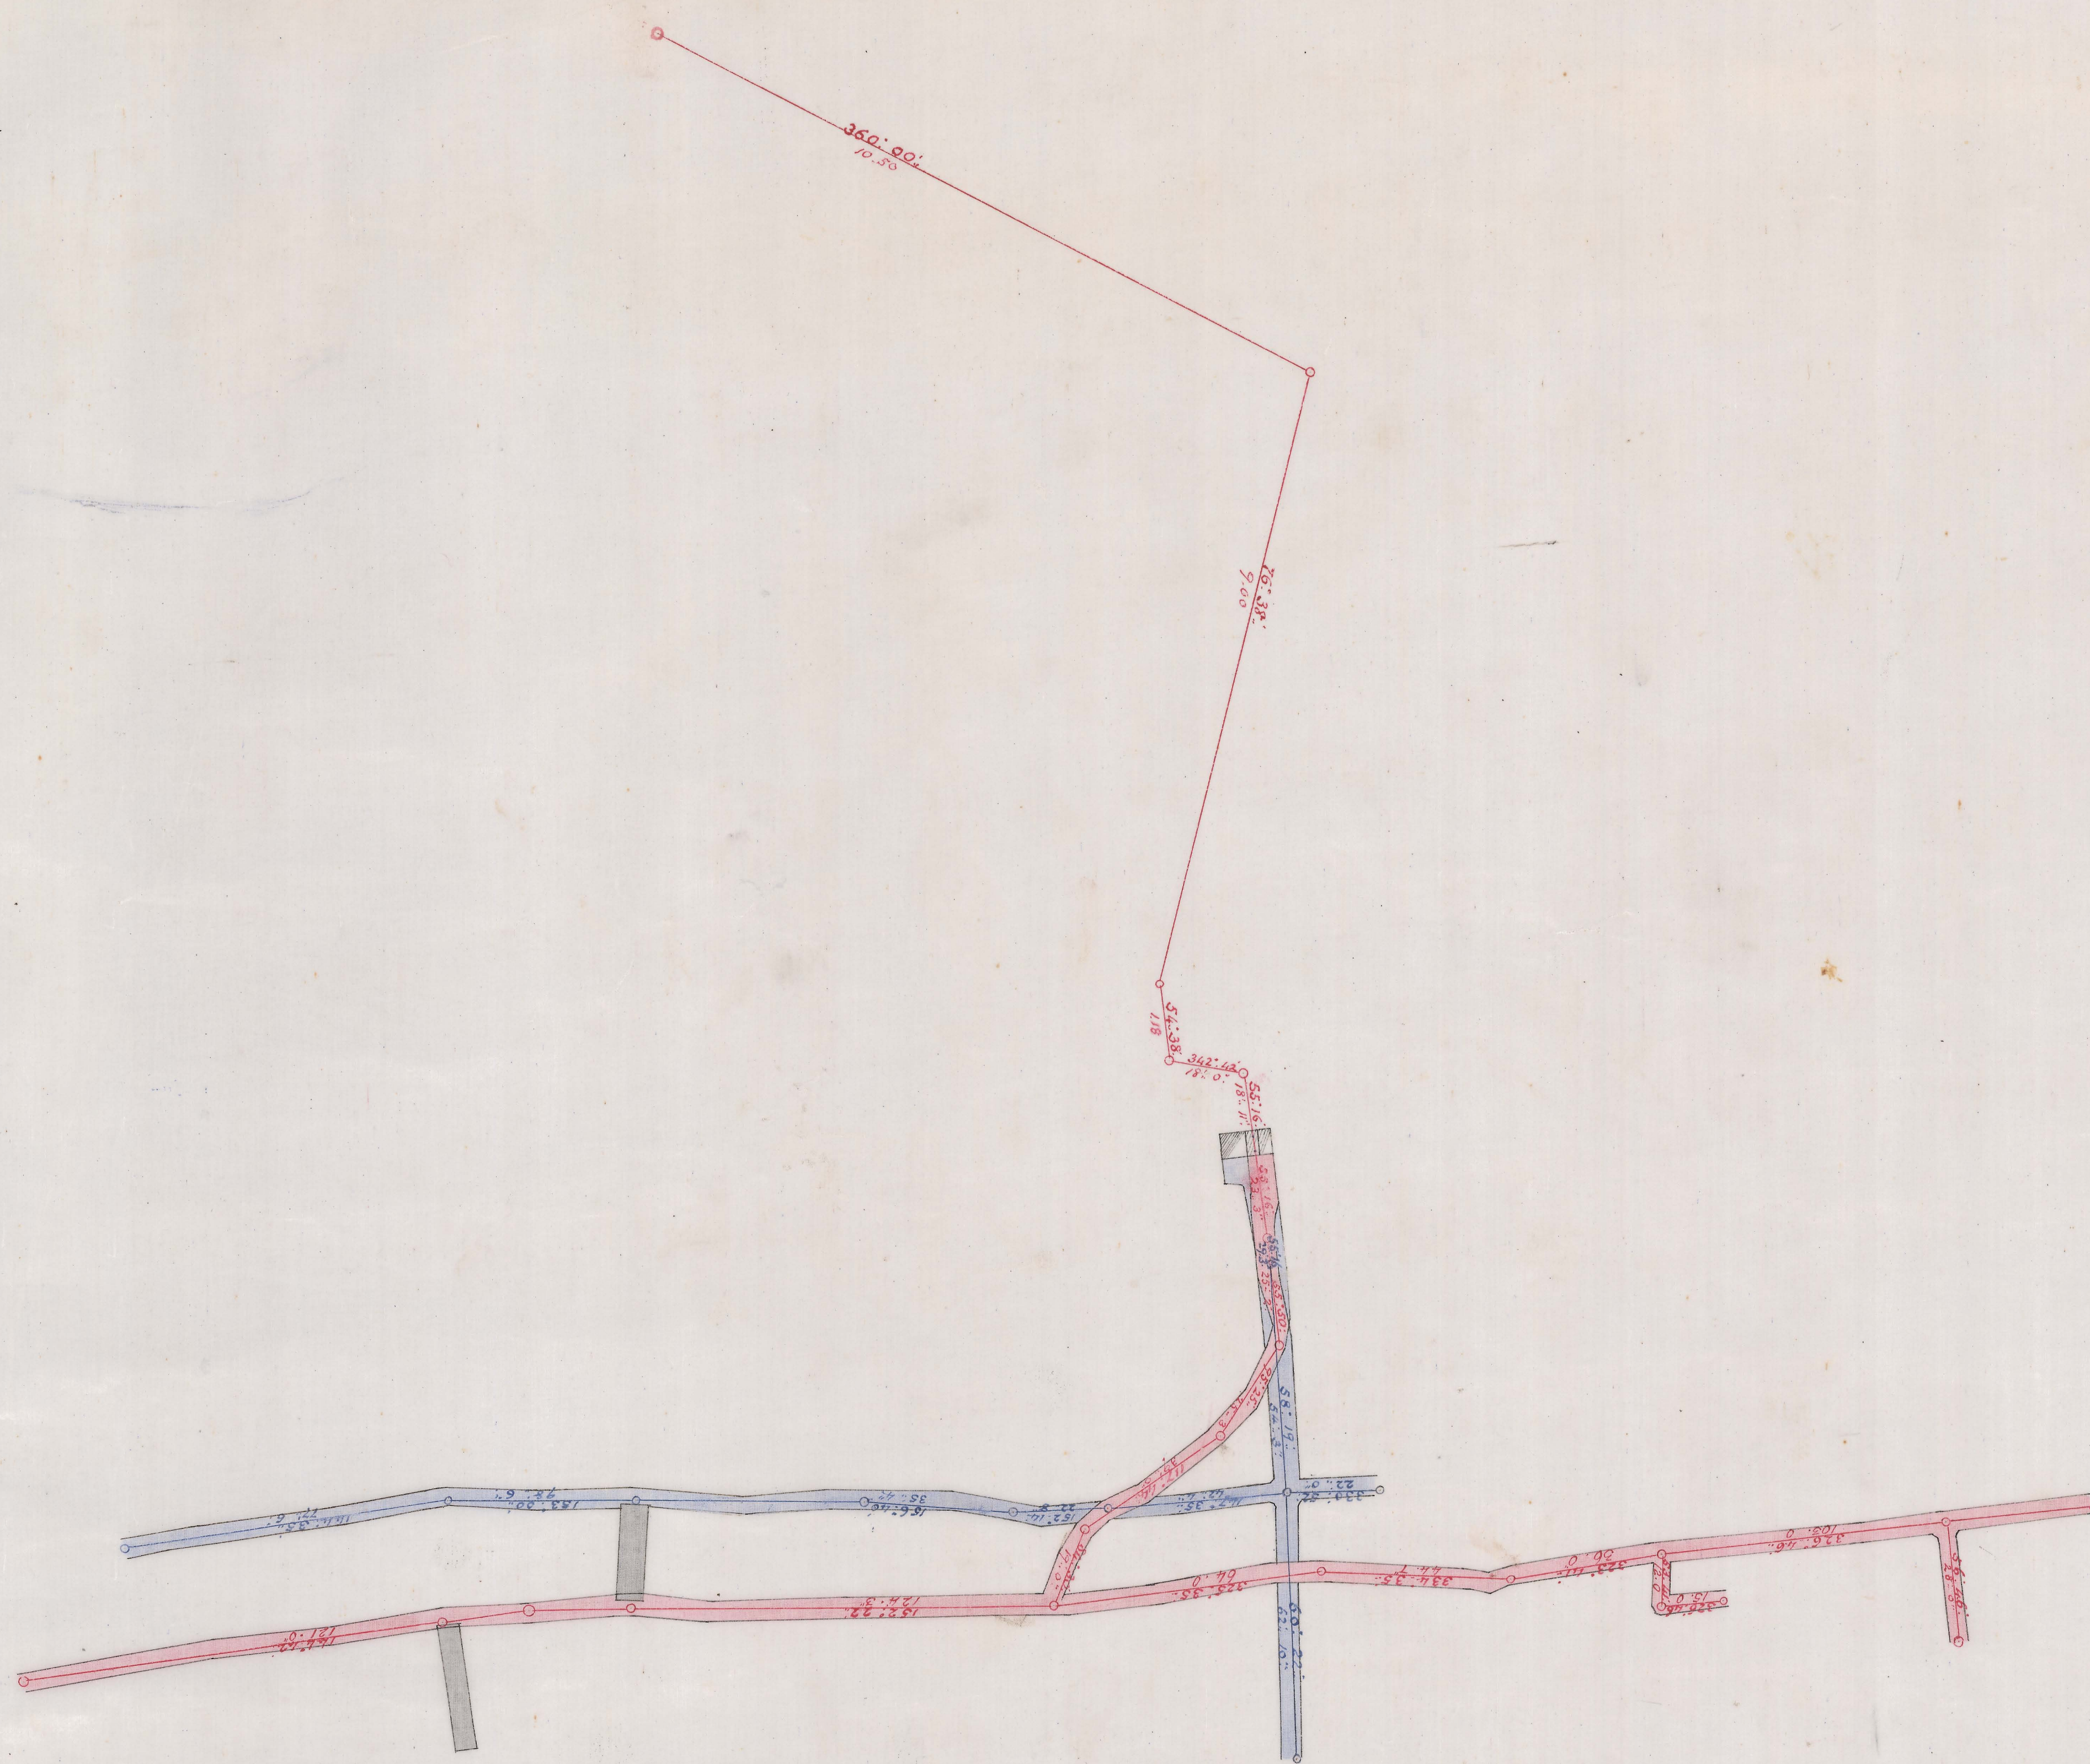

SCALE

— 25- FEET- TO- ONE- INCH —

-  106 F^T LEVEL
 176 F^T
 SHAFTS & WINZES
 GROUND STOPED
 STOPES FILLED IN