


# SILVER KING MINE

SECTION 222 87 M

(FAHEY'S TRIBUTE)

SCALE 25 FEET TO 1 INCH

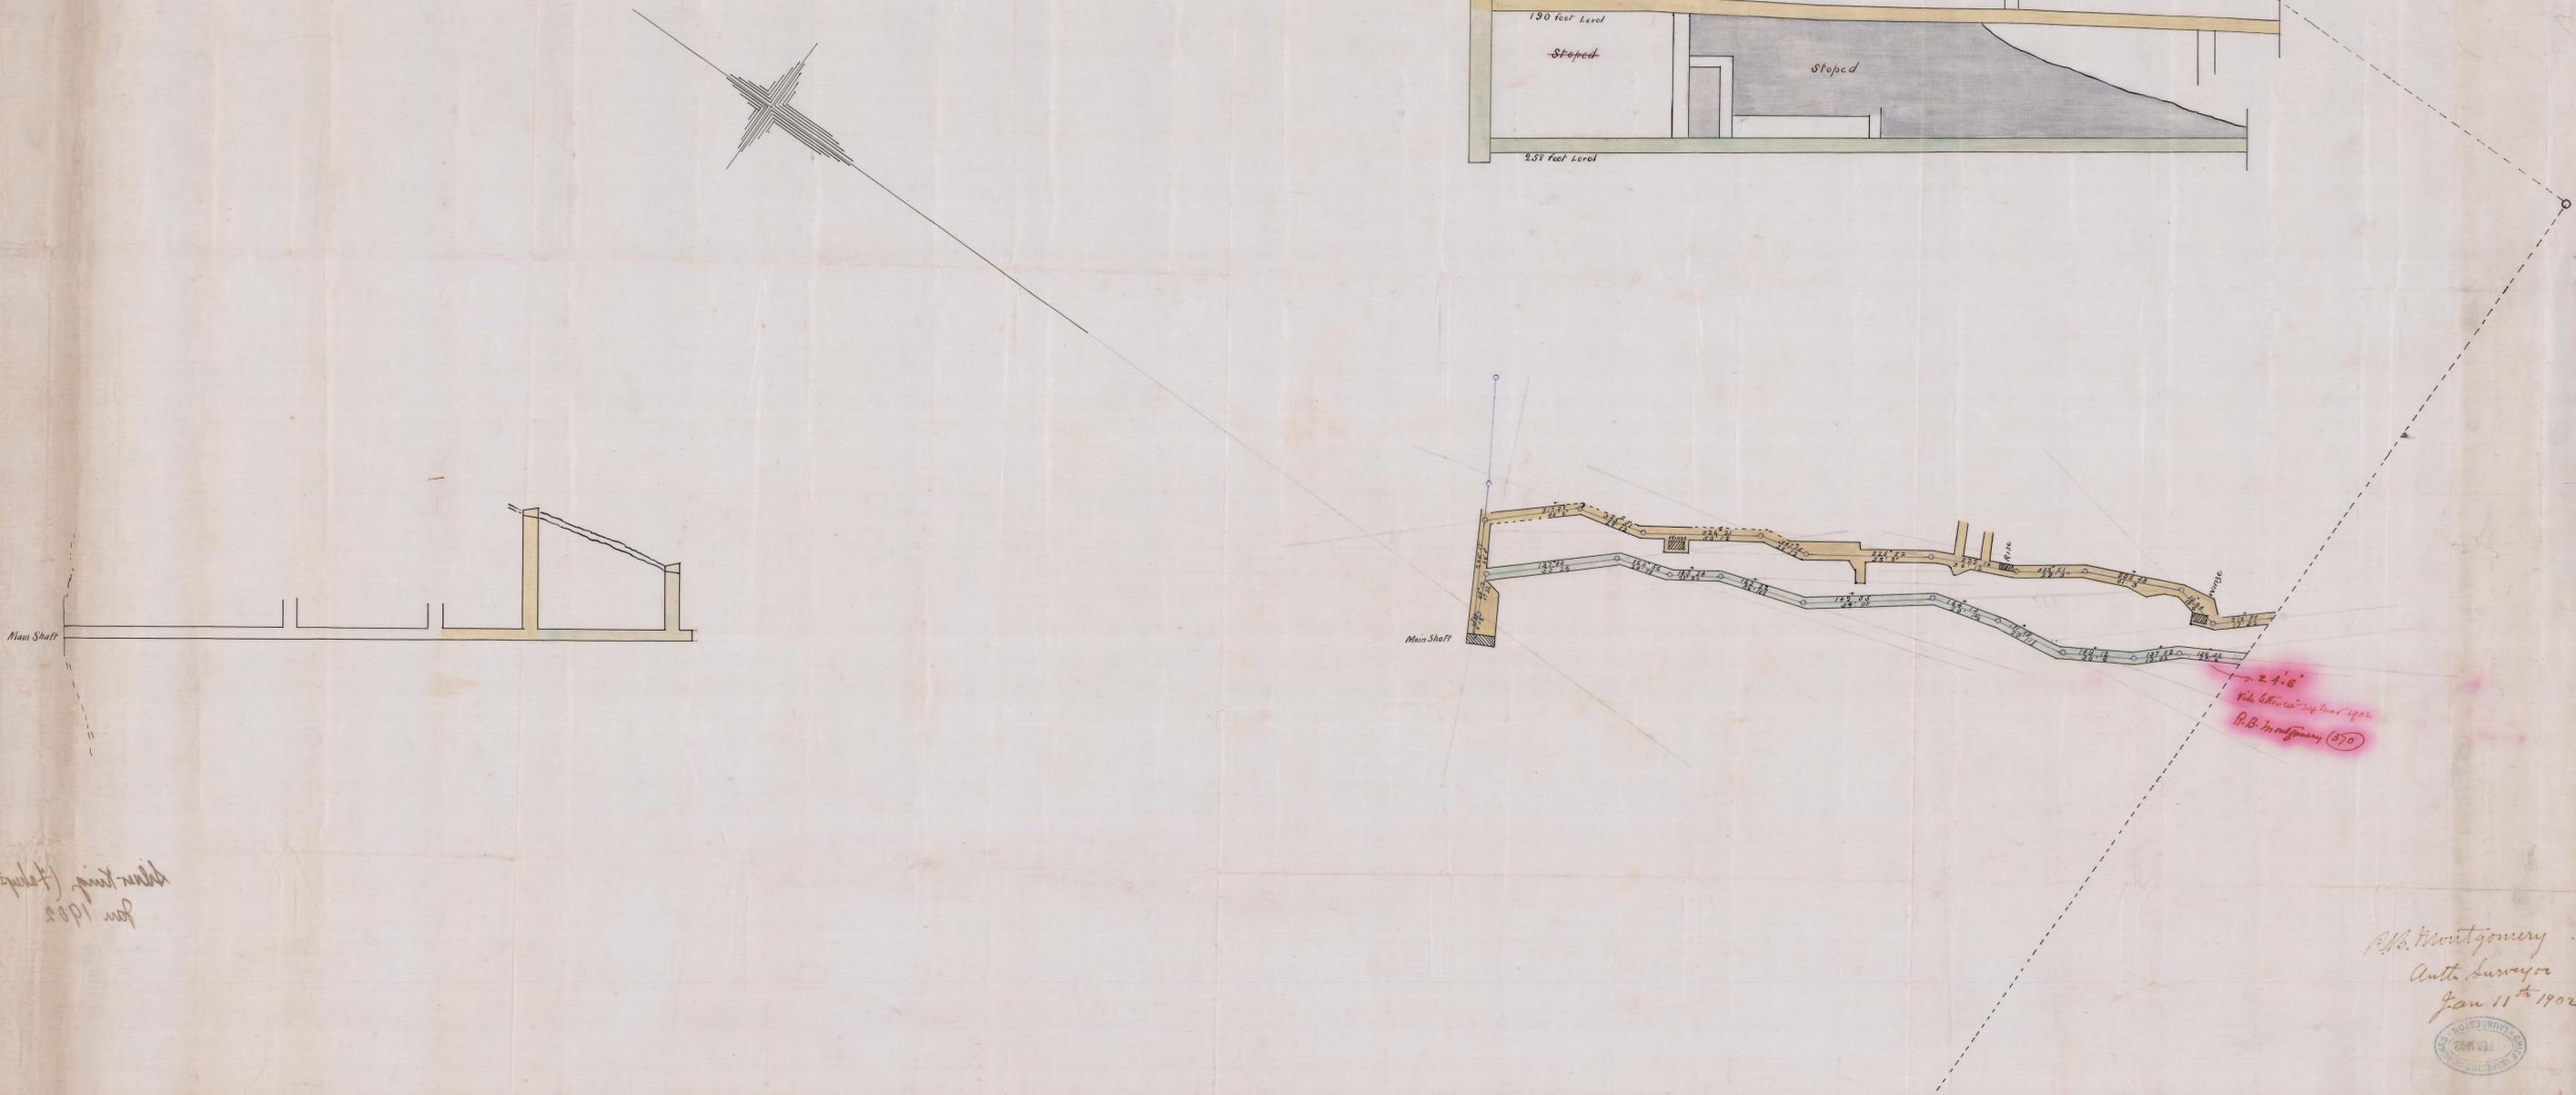

*(Main Shaft) (Fahey's Tribute) Jan 1902*

*R.B. Montgomery  
Auth. Surveyor  
Jan 11th 1902*



41

201 07

41