


25/1
 180
 322
 NW angle
 135
 750° 23'
 1250' 0" (at 1/2 scale)

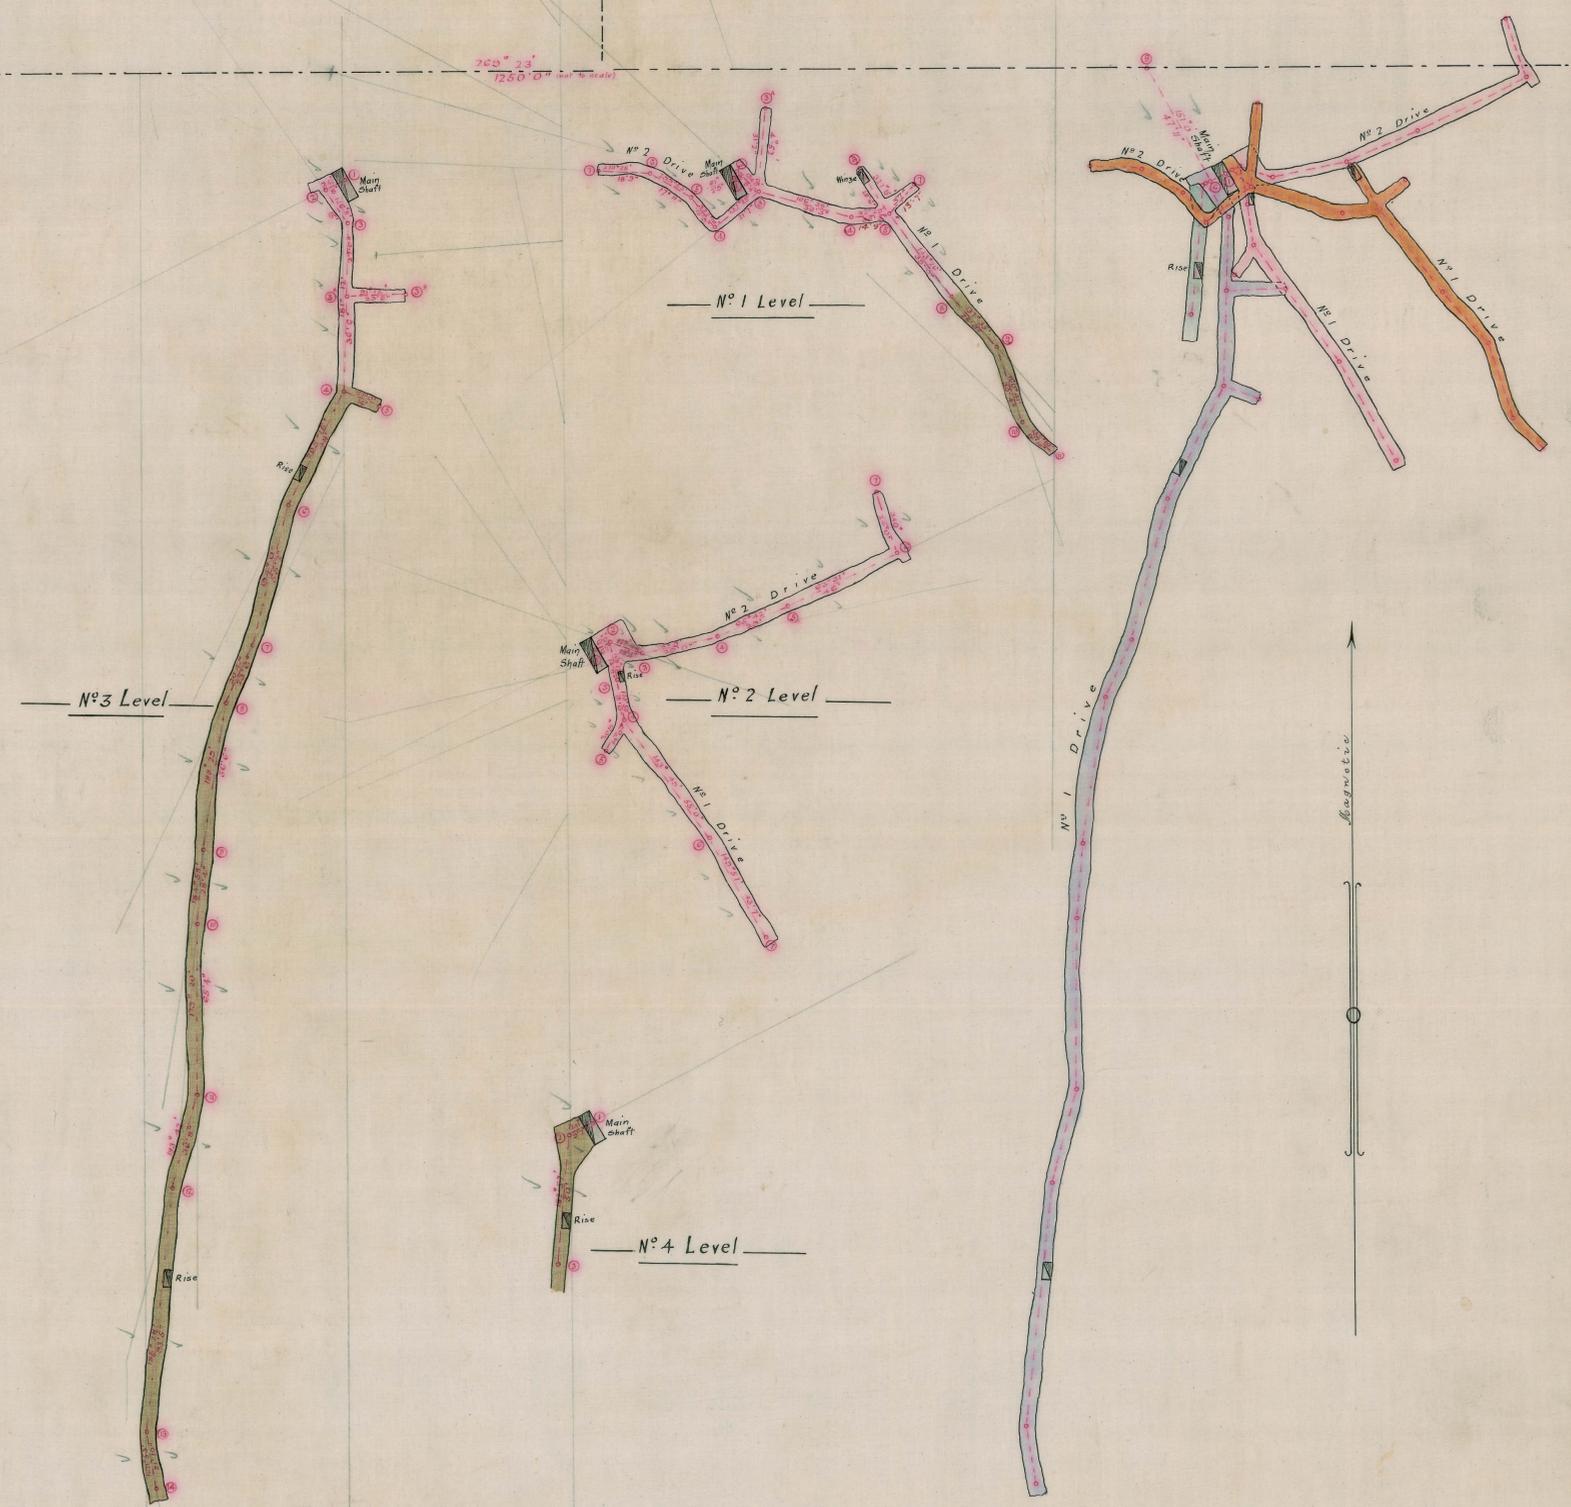

5m

292
03

— Reference —

No. 1 Level	colored	thus	
No. 2 Level	"	"	
No. 3 Level	"	"	
No. 4 Level	"	"	
1908-9 Work	"	"	

Northern Territories Mines of Australia Lim
 Adelaide Mine

Underground Workings

Scale 30ft to one Inch



Sheet I

Godfrey Smith C.E.