


5 cm

292-04

North East
1899
1898

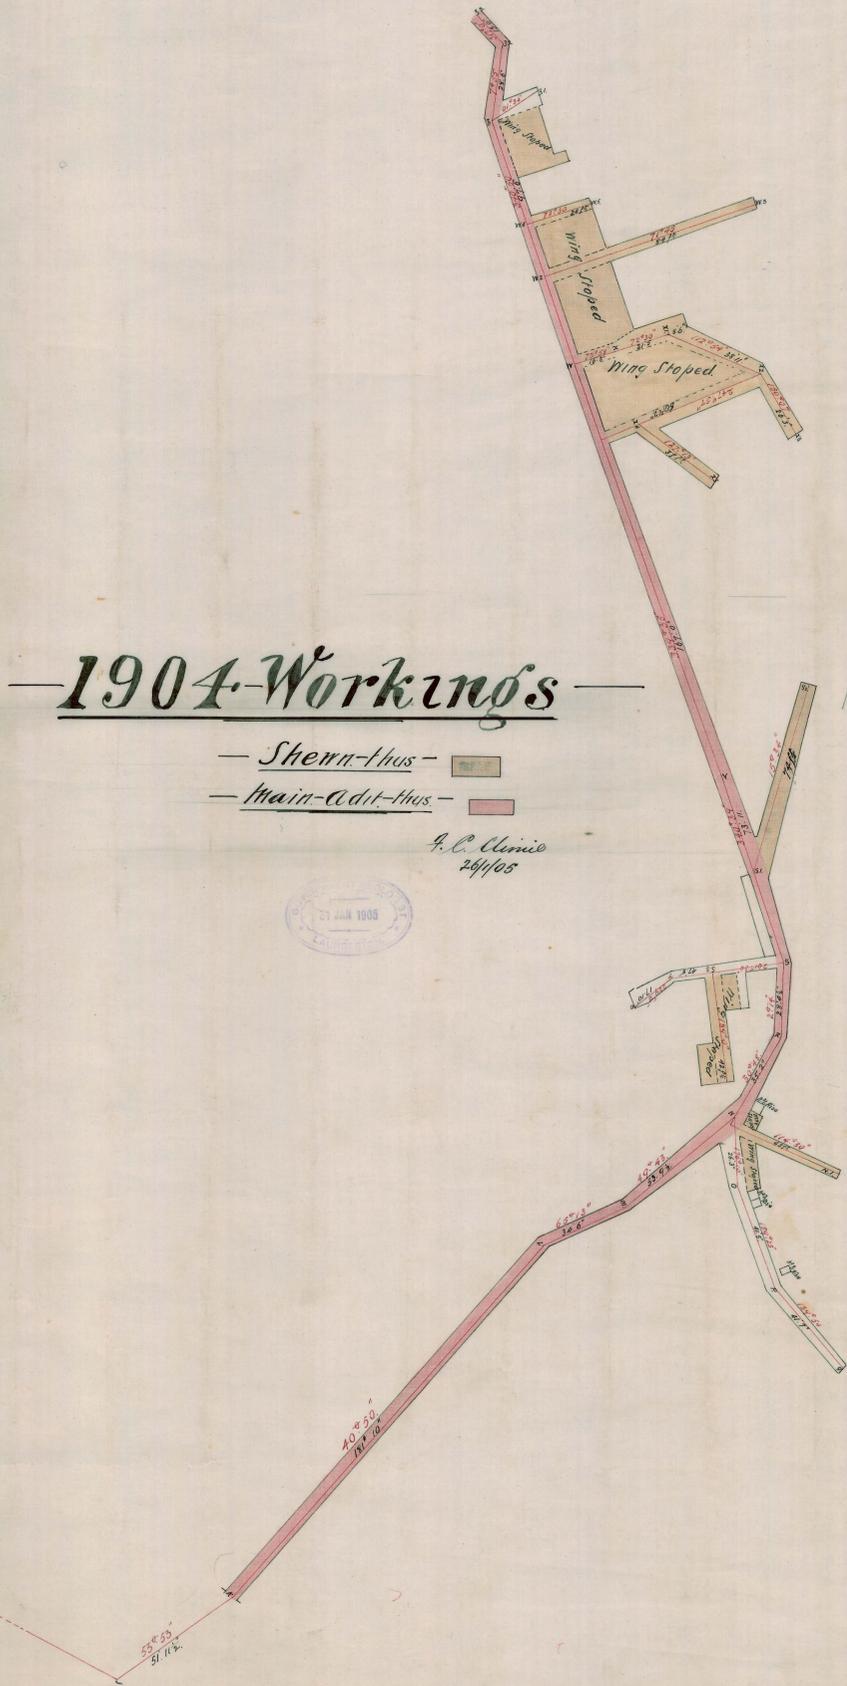

PLAN

— Underground - Workings —
— West-Comet-Prov-Synd. N.L. —

— Scale - 25 - Feet - 1 - Inch —

— 1904-Workings —

- Shewn-Thus —
- Main-Adit-Thus —

F. C. Umic
24/105

